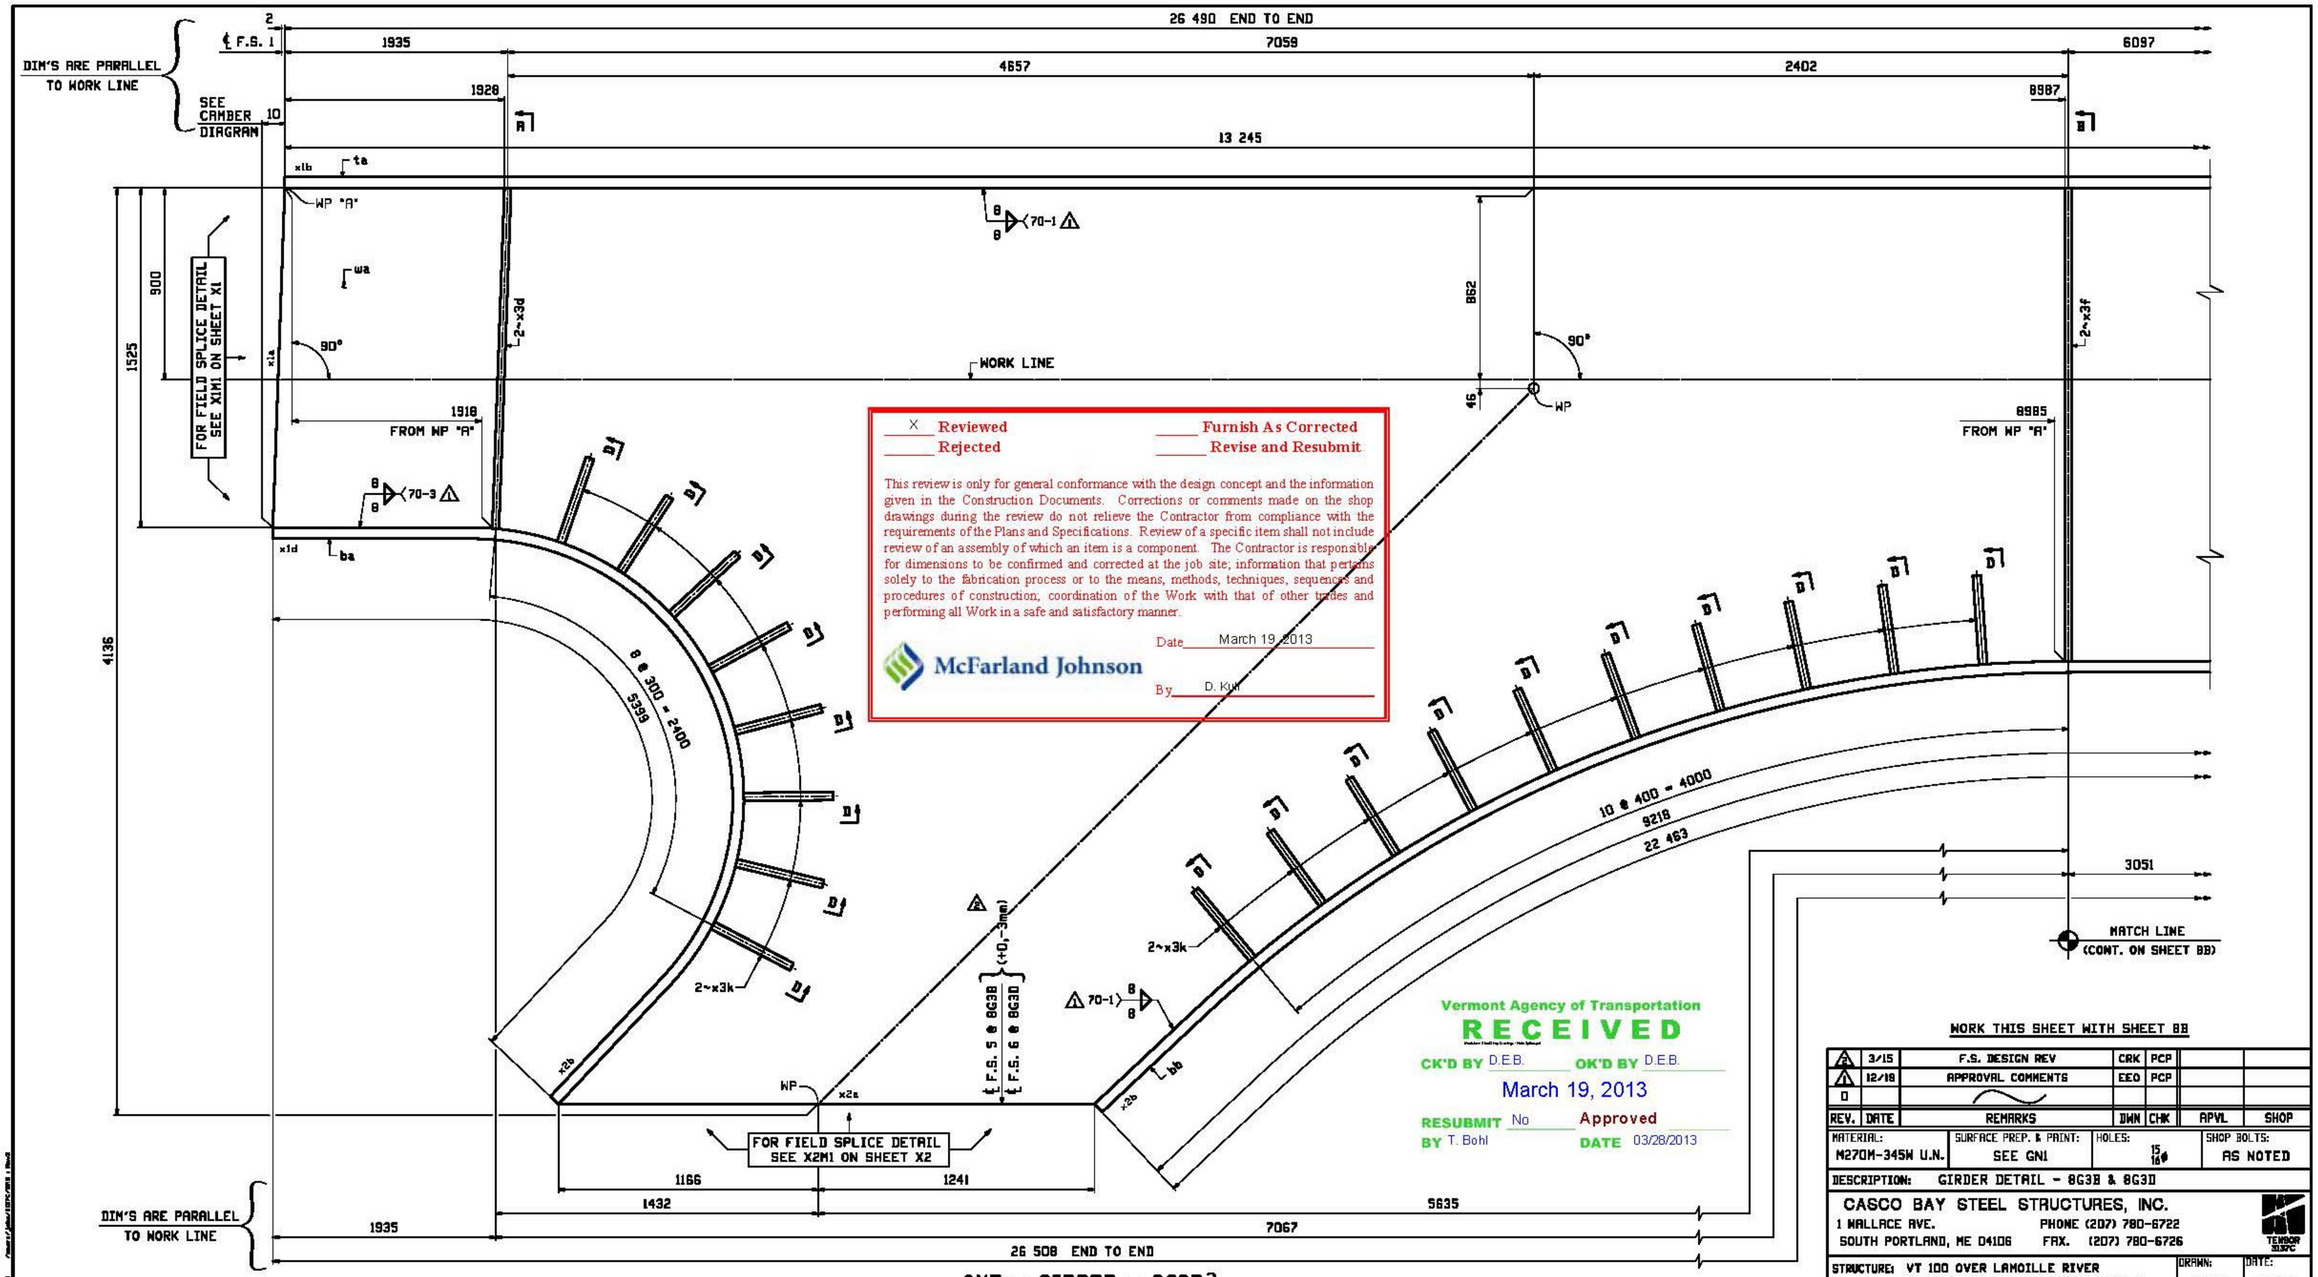

X Reviewed
Rejected
Furnish As Corrected
Revise and Resubmit

This review is only for general conformance with the design concept and the information given in the Construction Documents. Corrections or comments made on the shop drawings during the review do not relieve the Contractor from compliance with the requirements of the Plans and Specifications. Review of a specific item shall not include review of an assembly of which an item is a component. The Contractor is responsible for dimensions to be confirmed and corrected at the job site; information that pertains solely to the fabrication process or to the means, methods, techniques, sequences and procedures of construction; coordination of the Work with that of other trades and performing all Work in a safe and satisfactory manner.

McFarland Johnson

Date March 19, 2013

By D. Kuh

Vermont Agency of Transportation
RECEIVED
CK'D BY D.E.B. OK'D BY D.E.B.
March 19, 2013
RESUBMIT No Approved
BY T. Bohl DATE 03/28/2013

WORK THIS SHEET WITH SHEET 8B

REV.	DATE	REMARKS	DWN	CHK	APVL	SHOP
2	3/15	F.S. DESIGN REV	CRK	PCP		
1	12/18	APPROVAL COMMENTS	EEO	PCP		
0						

MATERIAL: M270M-345W U.N.	SURFACE PREP. & PAINT: SEE GN1	HOLES: 15 14ϕ	SHOP BOLTS: AS NOTED

DESCRIPTION: GIRDER DETAIL - 8G3B & 8G3D

CASCO BAY STEEL STRUCTURES, INC.
1 WALLACE AVE. PHONE (207) 780-6722
SOUTH PORTLAND, ME 04106 FAX. (207) 780-6726

TEMBOR 2030PC

STRUCTURE: VT 100 OVER LAMOILLE RIVER
MORRISTOWN, VT LAMOILLE COUNTY
STP F 029-1 (2) C/1

DRAWN: EEO	DATE: 08/27
CHKD: PCP	DATE: 09/17
LOCATION: MORRISTOWN, VT	JOB NO.
PROJ NO. STP F 029-1(2)C/1	521
CUSTOMER: WINTERSET, INC.	DWG NO. 8AB REV. 2

ONE - GIRDER - 8G3B
ONE - GIRDER - 8G3D
} ALIKE EXCEPT AS NOTED

FOR FIELD SPLICE DETAILS SEE DRAWINGS X1 & X2.
FOR GIRDER STANDARD DETAILS SEE DRAWING X3 & X4.
FOR CAMBER & FLANGE DIAGRAMS SEE DRAWING C2.
FOR GENERAL NOTES SEE DRAWING GN1.
T2 DENOTES MATERIAL SUBJECT TO CHARPY V-NOTCH TESTING.