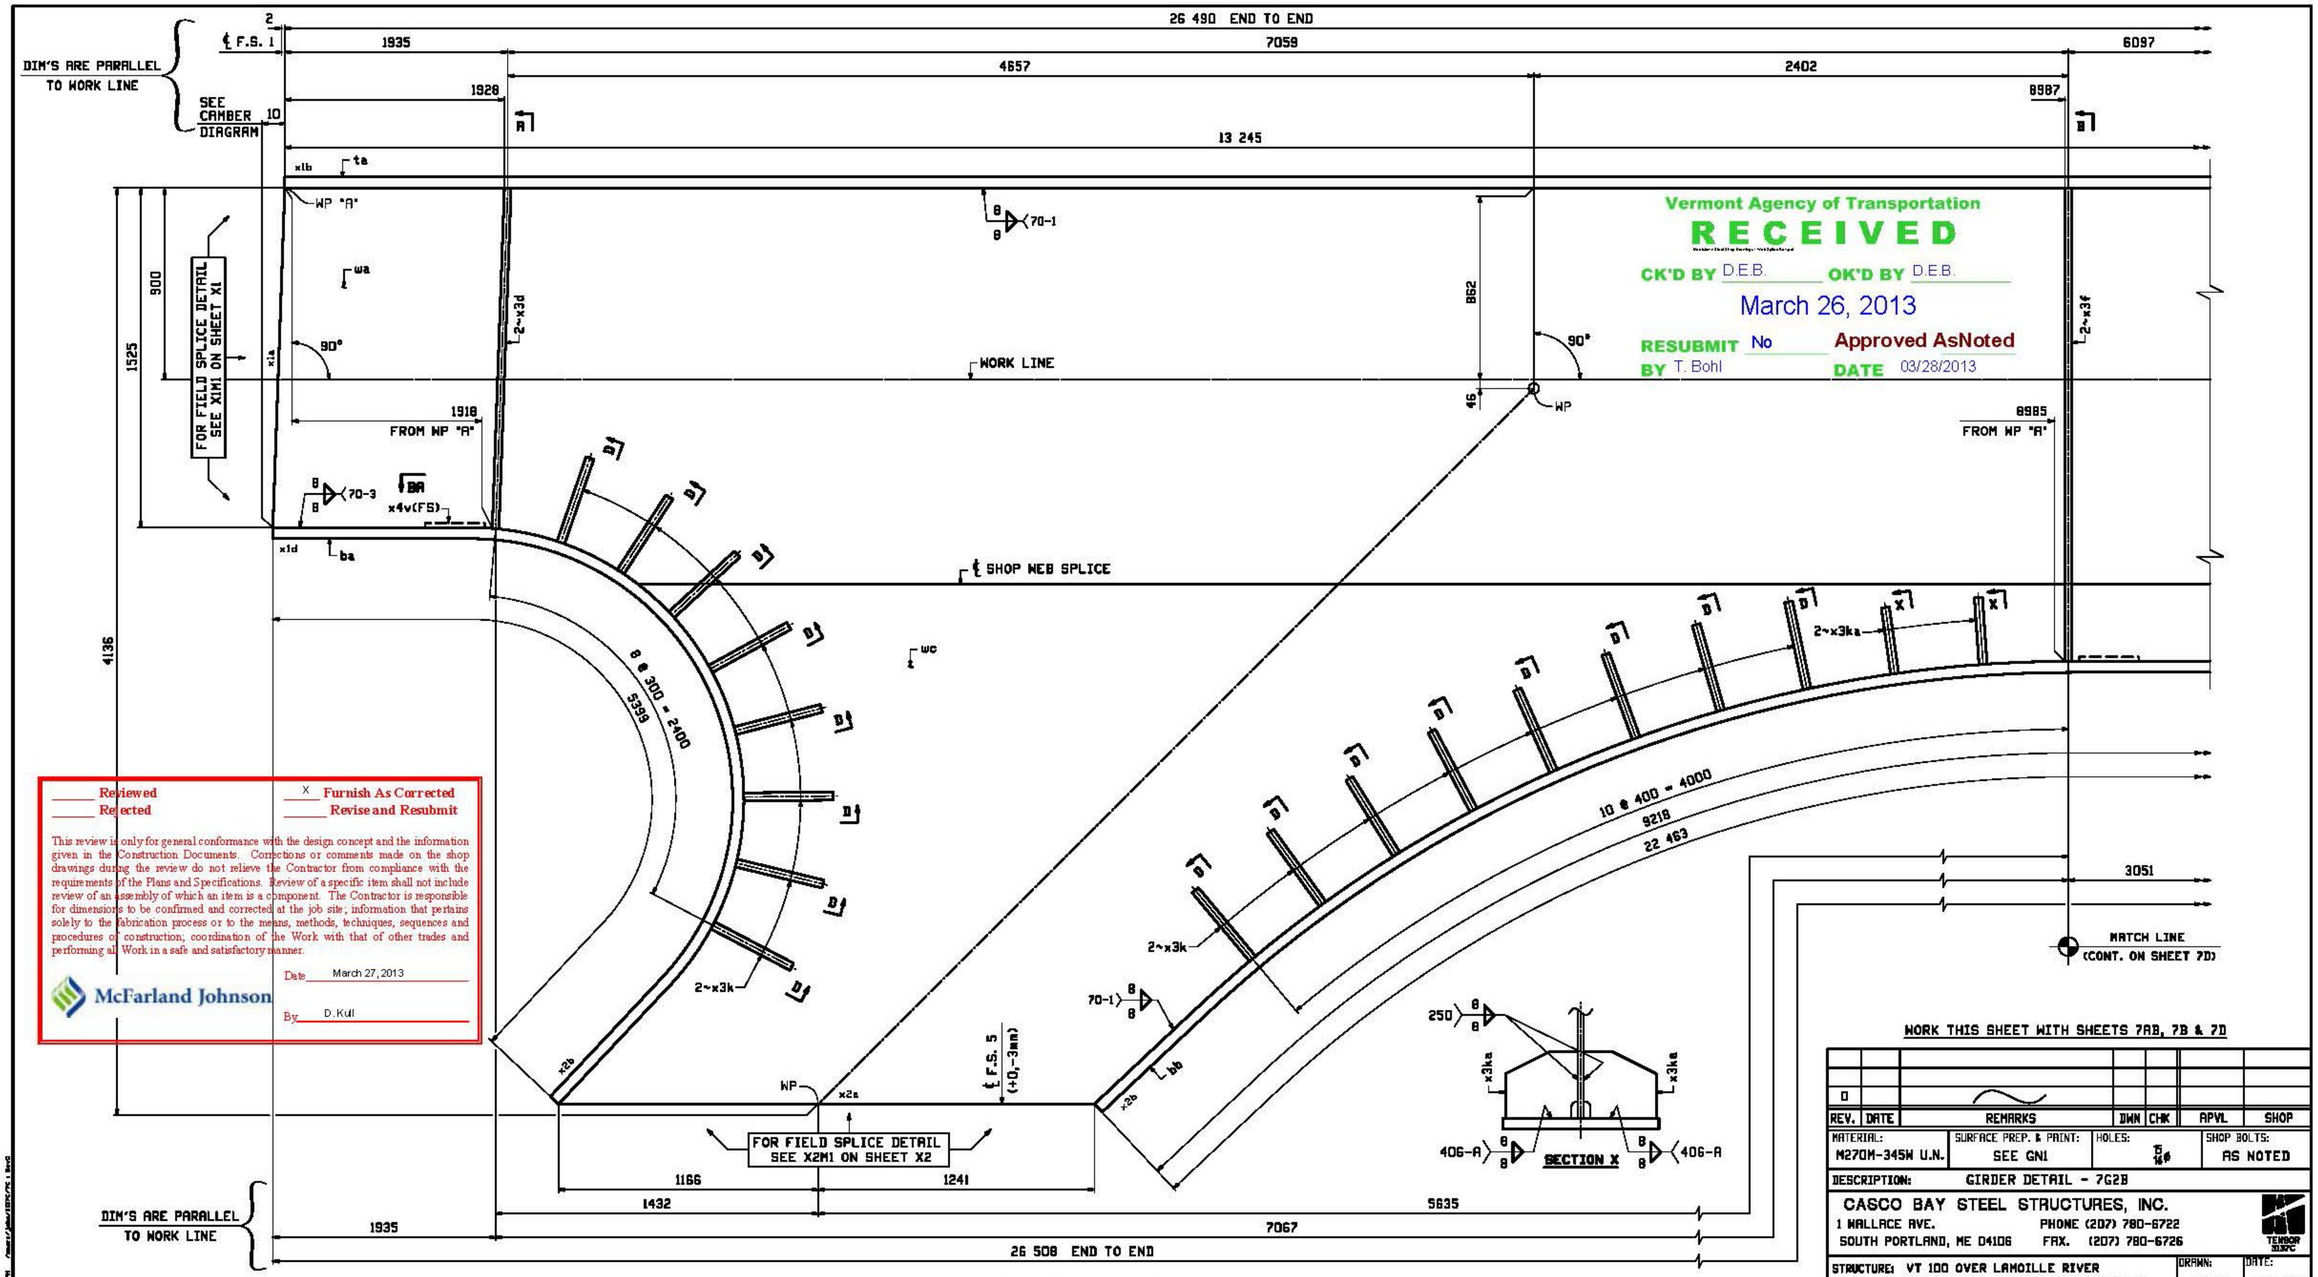

Vermont Agency of Transportation
RECEIVED
CK'D BY D.E.B. OK'D BY D.E.B.
March 26, 2013
RESUBMIT No Approved AsNoted
BY T. Bohl DATE 03/28/2013

Reviewed
Rejected
X Furnish As Corrected
Revise and Resubmit

This review is only for general conformance with the design concept and the information given in the Construction Documents. Corrections or comments made on the shop drawings during the review do not relieve the Contractor from compliance with the requirements of the Plans and Specifications. Review of a specific item shall not include review of an assembly of which an item is a component. The Contractor is responsible for dimensions to be confirmed and corrected at the job site; information that pertains solely to the fabrication process or to the means, methods, techniques, sequences and procedures of construction; coordination of the Work with that of other trades and performing all Work in a safe and satisfactory manner.

McFarland Johnson

Date March 27, 2013

By D.Kull

WORK THIS SHEET WITH SHEETS 7AB, 7B & 7D

REV.	DATE	REMARKS	DWN	CHK	APVL	SHOP
0						

MATERIAL: M270M-345W U.N.	SURFACE PREP. & PAINT: SEE GN1	HOLES: 5/16ø	SHOP BOLTS: AS NOTED
DESCRIPTION: GIRDER DETAIL - 7G2B			

CASCO BAY STEEL STRUCTURES, INC.
1 WALLACE AVE. PHONE (207) 780-6722
SOUTH PORTLAND, ME 04106 FAX. (207) 780-6726

STRUCTURE: VT 100 OVER LAMOILLE RIVER MORRISTOWN, VT LAMOILLE COUNTY STP F 029-1 (2) C/1	DRAWN: EEO	DATE: 3/21/13
	CHKD: PCP	DATE: 3/25/13
LOCATION: MORRISTOWN, VT	JOB NO.	DWG NO.
PROJ NO. STP F 029-1(2)C/1	521	7C
CUSTOMER: WINTERSET, INC.		REV. △

ONE - GIRDER - 7G2B

FOR FIELD SPLICE DETAILS SEE DRAWINGS X1 & X2.
FOR GIRDER STANDARD DETAILS SEE DRAWING X3 & X4.
FOR CAMBER & FLANGE DIAGRAMS SEE DRAWING C6.
FOR GENERAL NOTES SEE DRAWING GN1.
T2 DENOTES MATERIAL SUBJECT TO CHARPY V-NOTCH TESTING.