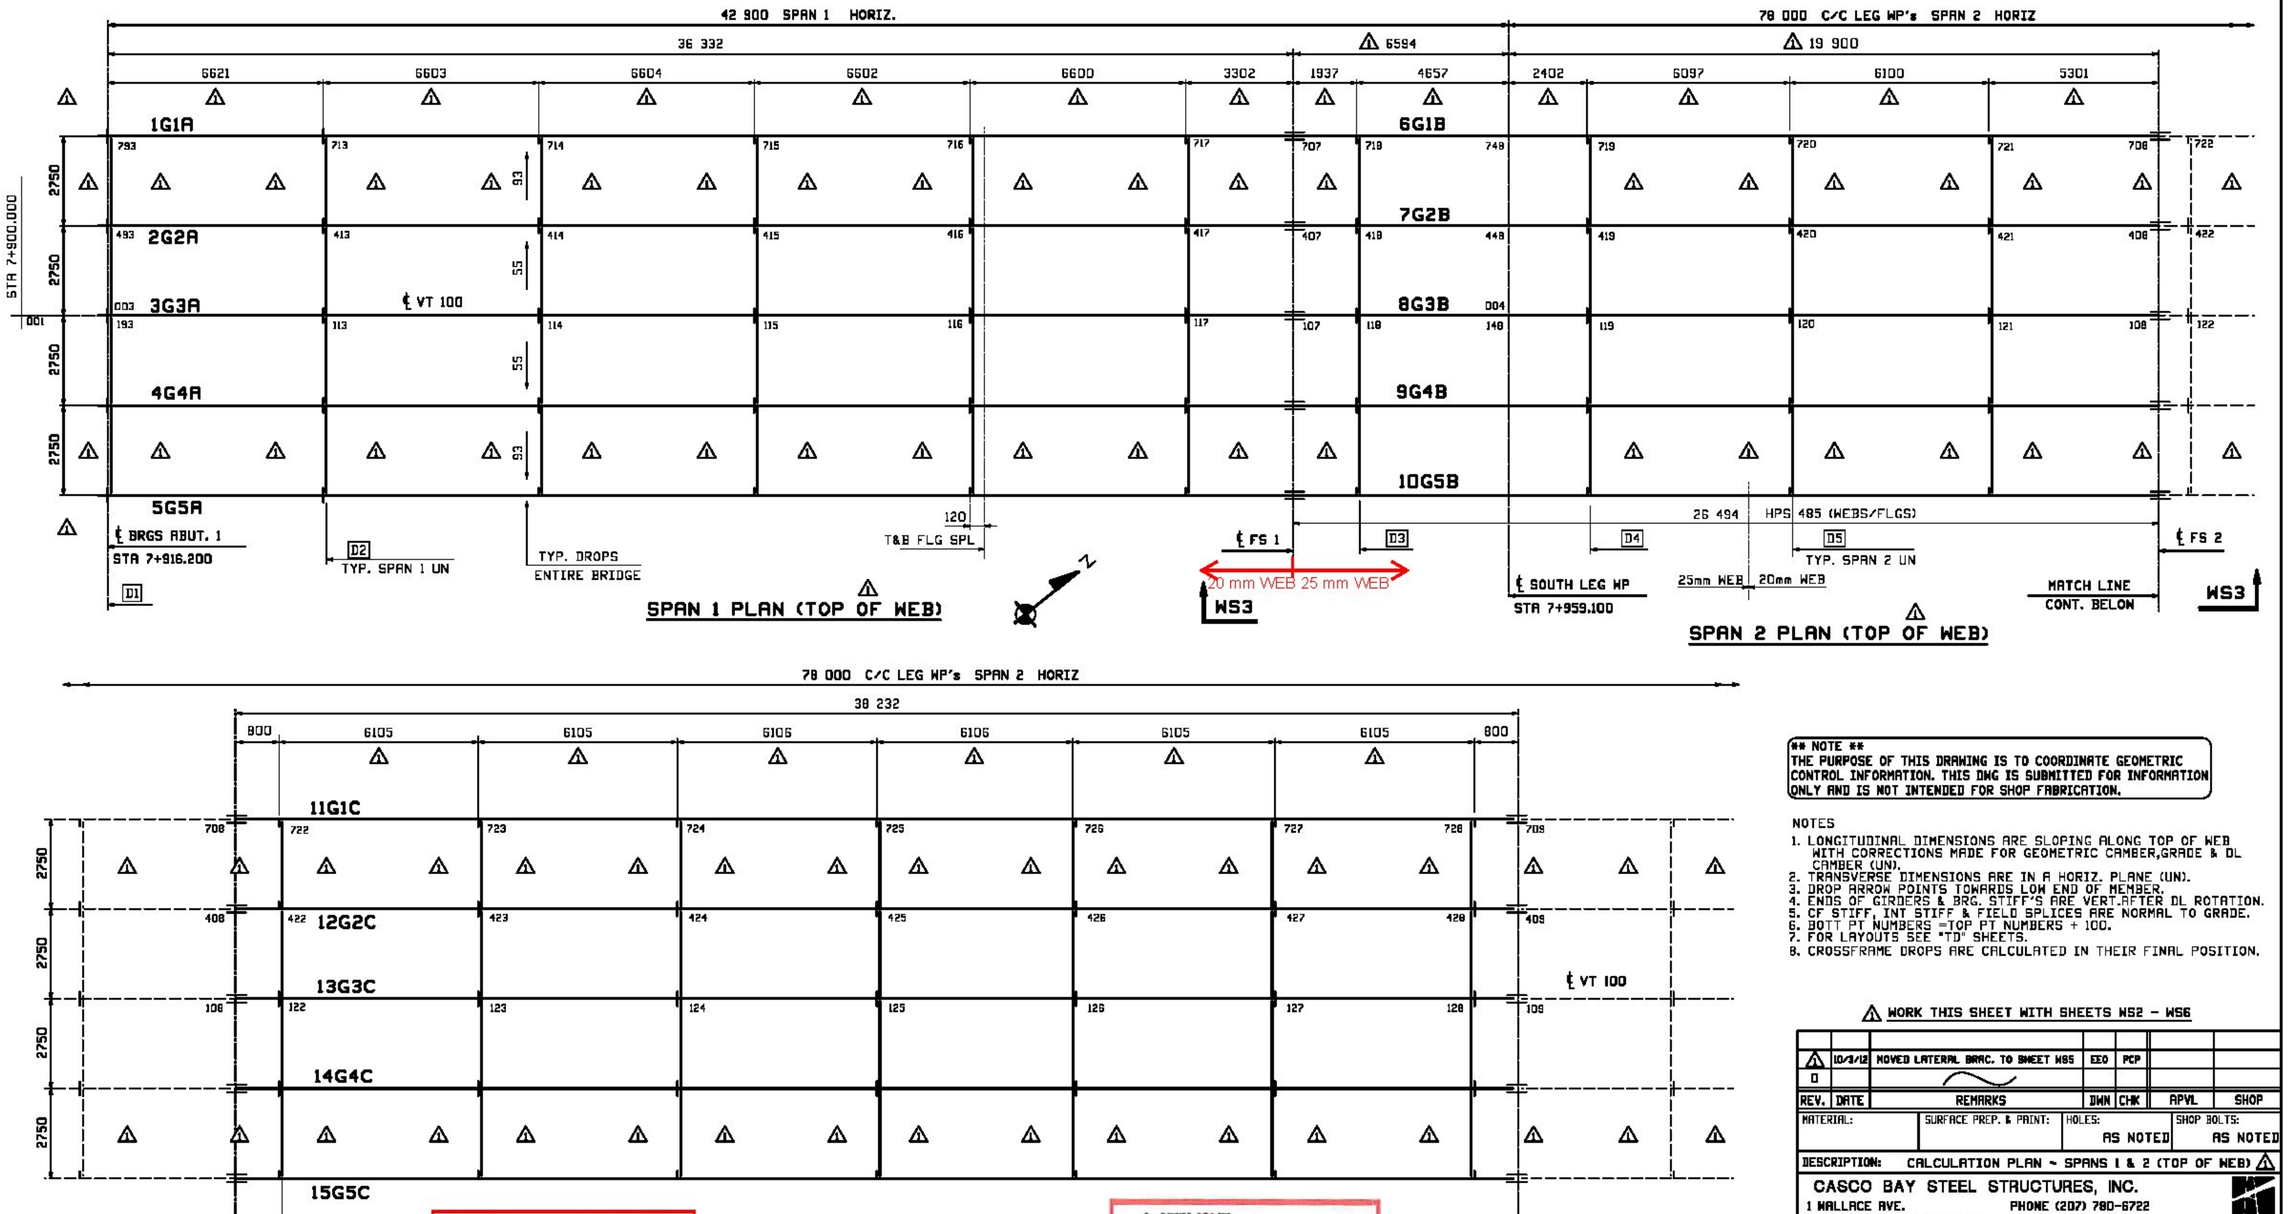

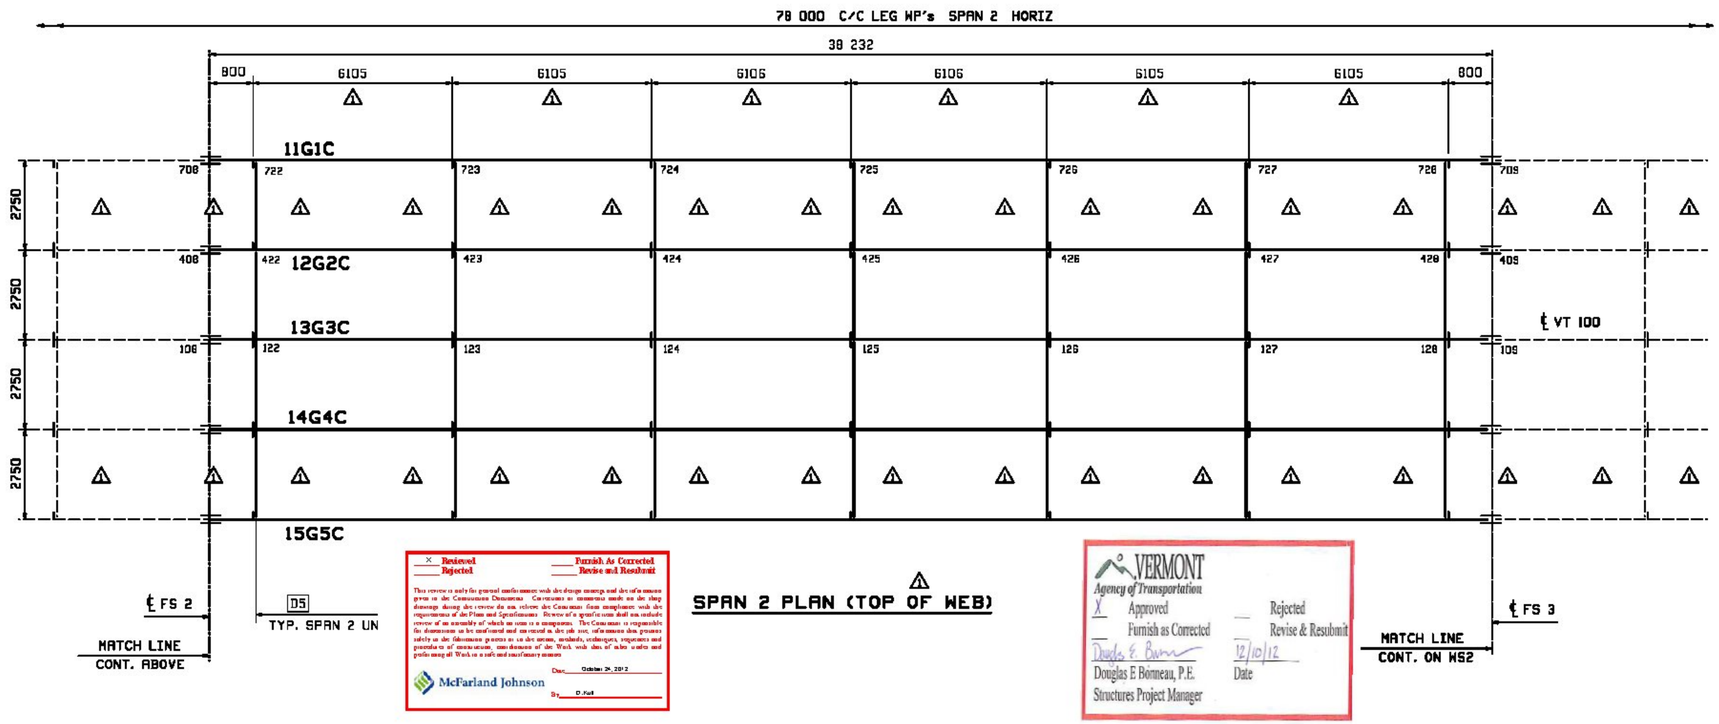

Reviewed / Rejected — Furnish As Corrected / Revise and Resubmit

This review is only for general conformance with the design concept and the information given in the Contract Documents. Contractor or contractor made at the risk, damage along the review do not relieve the Contractor from compliance with the requirements of the Plans and Specifications. Review of a specification shall not include review of an assembly of which an item is a component. The Contractor is responsible for dimensions to be confirmed and correlated at the job site, information that pertains solely to the fabrication process or to the means, methods, techniques, sequences and procedures of construction, coordination of the Work with that of other trades and performing all Work in a safe and satisfactory manner.

McFarland Johnson — Date: October 24, 2012 — By: D.Hall

VERMONT Agency of Transportation
X Approved — Rejected
Furnish as Corrected — Revise & Resubmit
Douglas E Bonneau, P.E. — 12/10/12 Date
Structures Project Manager

** NOTE **
THE PURPOSE OF THIS DRAWING IS TO COORDINATE GEOMETRIC CONTROL INFORMATION. THIS DWG IS SUBMITTED FOR INFORMATION ONLY AND IS NOT INTENDED FOR SHOP FABRICATION.

NOTES
1. LONGITUDINAL DIMENSIONS ARE SLOPING ALONG TOP OF WEB WITH CORRECTIONS MADE FOR GEOMETRIC CAMBER,GRADE & DL CAMBER (UN).
2. TRANSVERSE DIMENSIONS ARE IN A HORIZ. PLANE (UN).
3. DROP ARROW POINTS TOWARDS LOW END OF MEMBER.
4. ENDS OF GIRDERS & BRG. STIFF'S ARE VERT.AFTER DL ROTATION.
5. CF STIFF, INT STIFF & FIELD SPLICES ARE NORMAL TO GRADE.
6. BOTT PT NUMBERS =TOP PT NUMBERS + 100.
7. FOR LAYOUTS SEE "TD" SHEETS.
8. CROSSFRAME DROPS ARE CALCULATED IN THEIR FINAL POSITION.

WORK THIS SHEET WITH SHEETS WS2 – WS6

REV.	DATE	REMARKS	DWN	CHK	APVL	SHOP
1	10/1/12	MOVED LATERAL BRAC. TO SHEET WS5	EEO	PCP		
0						

MATERIAL: | SURFACE PREP. & PAINT: | HOLES: AS NOTED | SHOP BOLTS: AS NOTED

DESCRIPTION: CALCULATION PLAN ~ SPANS 1 & 2 (TOP OF WEB)

CASCO BAY STEEL STRUCTURES, INC.
1 WALLACE AVE. PHONE (207) 780-6722
SOUTH PORTLAND, ME 04106 FAX. (207) 780-6726
TENSOR 3132FC

STRUCTURE: VT 100 OVER LAMOILLE RIVER
MORRISTOWN, VT LAMOILLE COUNTY
STP F 029-1 (2) C/1

DRAWN: WJG	DATE: 07/26		
CHKD: SOB	DATE: 08/02		
LOCATION: MORRISTOWN, VT	JOB NO. 521	DWG NO. WS1	
PROJ NO. STP F 029-1(2)C/1		REV. 1	
CUSTOMER: WINTERSET, INC.			