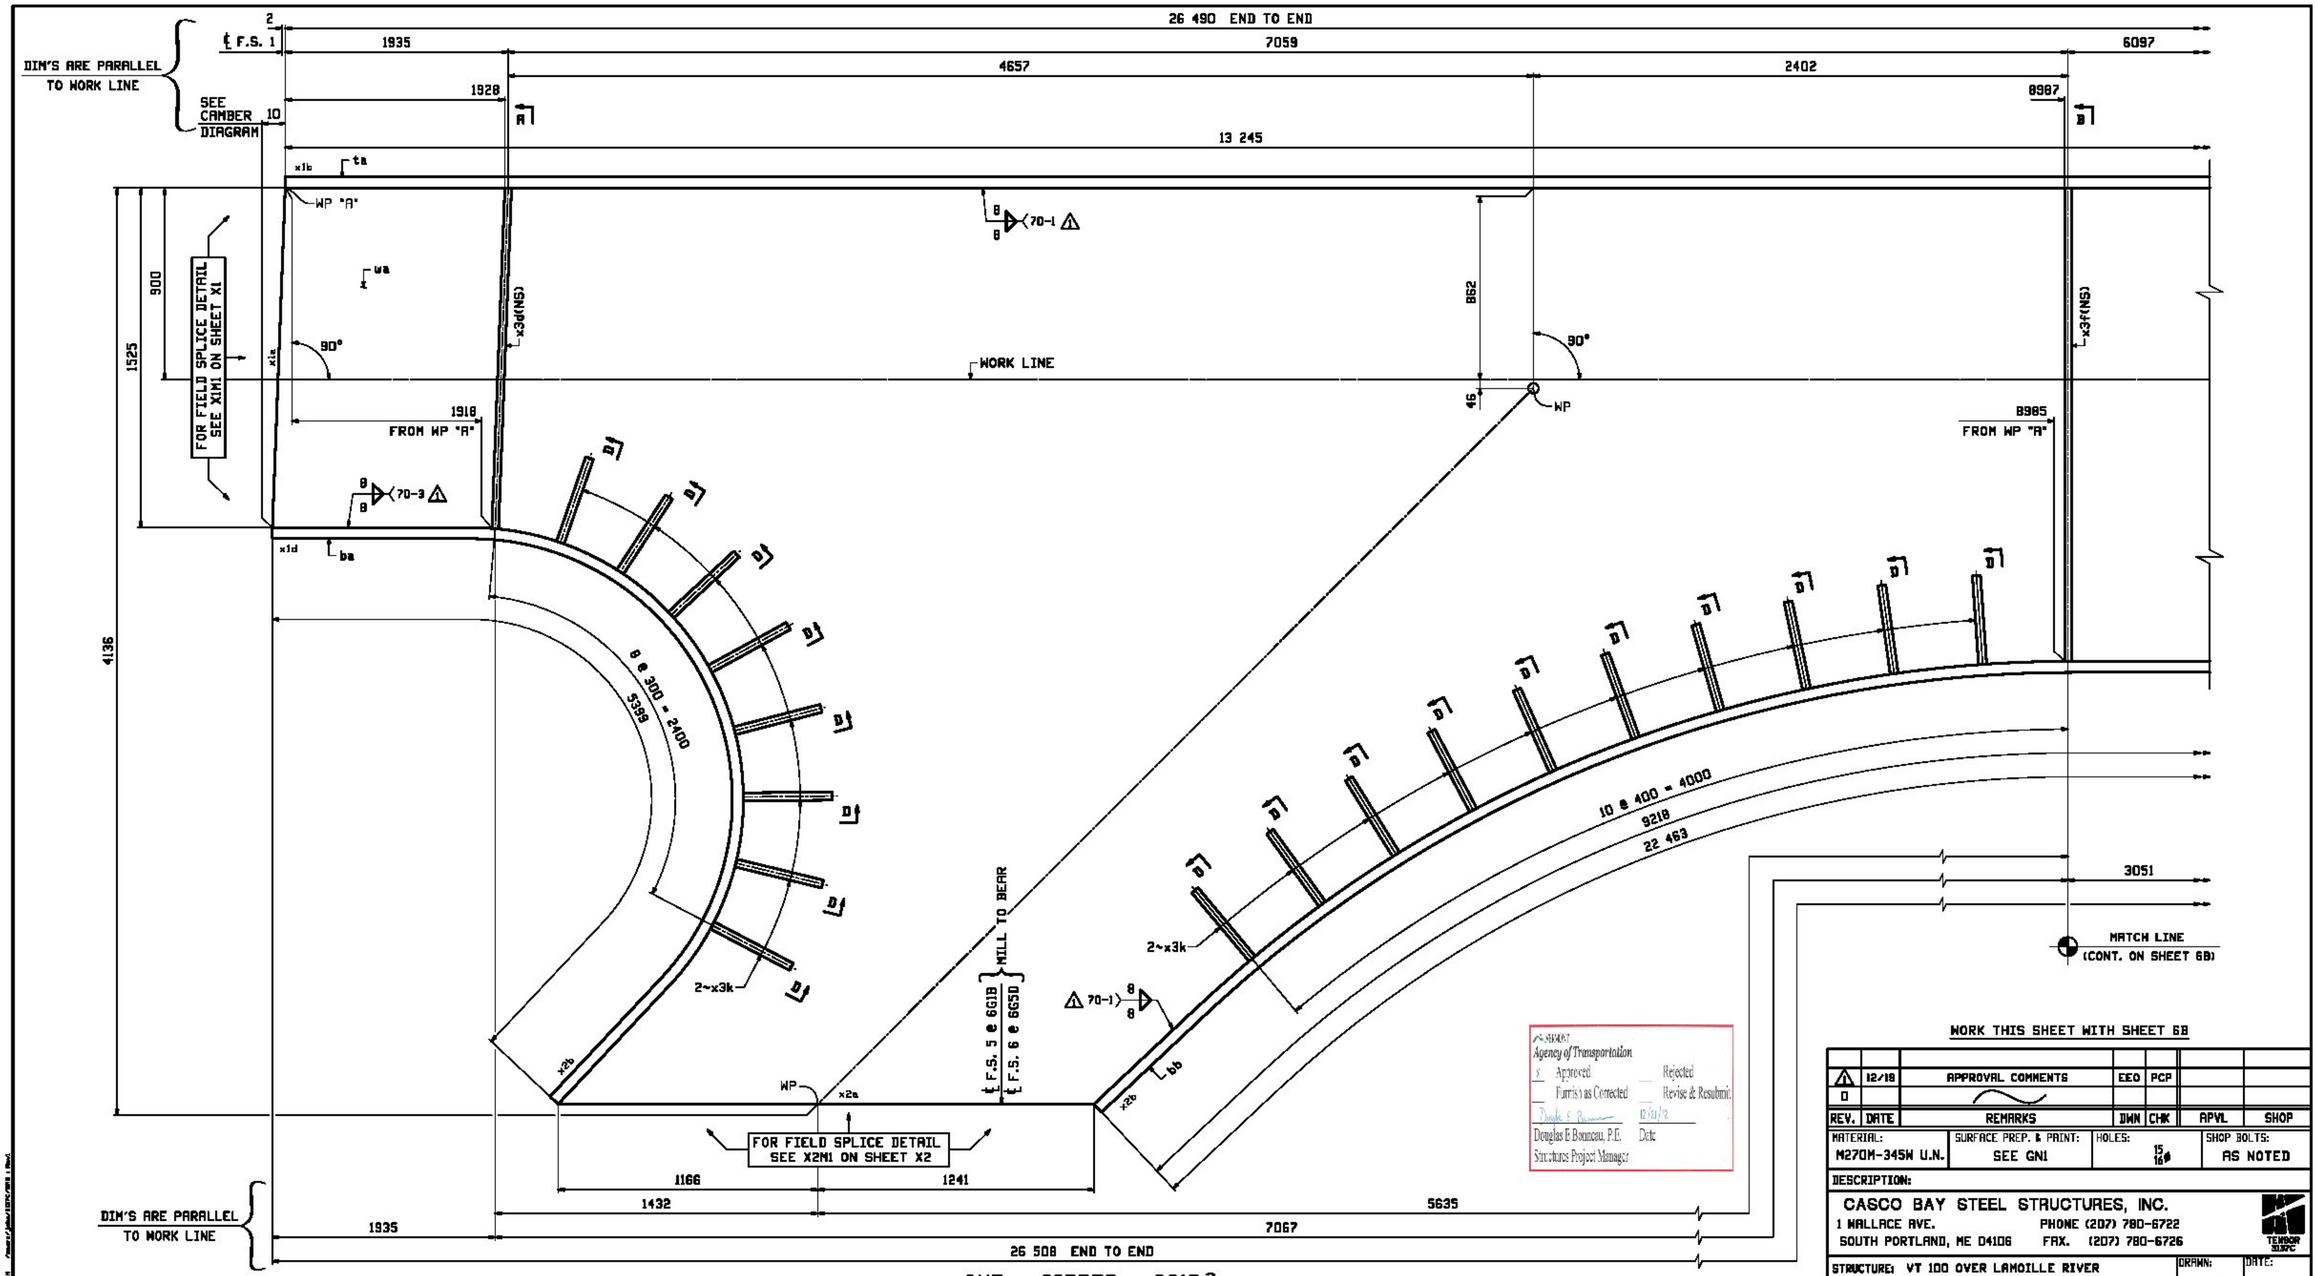

WORK THIS SHEET WITH SHEET 6B

Agency of Transportation
Approved — Rejected
Furnish as Corrected — Revise & Resubmit
Douglas E. Bonneau, P.E. — Date
Structures Project Manager

REV.	DATE	REMARKS	DWN	CHK	APVL	SHOP
1	12/18	APPROVAL COMMENTS	EEO	PCP		
0						

MATERIAL:	SURFACE PREP. & PRINT:	HOLES:	SHOP BOLTS:
M270M-345W U.N.	SEE GN1	15/16ø	AS NOTED

DESCRIPTION:

CASCO BAY STEEL STRUCTURES, INC.
1 WALLACE AVE. SOUTH PORTLAND, ME 04106
PHONE (207) 780-6722 FAX. (207) 780-6726
TEKBOR GROUP

STRUCTURE: VT 100 OVER LAMOILLE RIVER MORRISTOWN, VT LAMOILLE COUNTY STP F 029-1 (2) C/1	DRAWN: EEO	DATE: 08/23	
	CHKD: PCP	DATE: 09/17	
LOCATION: MORRISTOWN, VT	JOB NO.	DWG NO.	
PROJ NO. STP F 029-1(2)C/1	521	6AB	
CUSTOMER: WINTERSET, INC.		REV. 1	

ONE - GIRDER - 6G1B
ONE - GIRDER - 6G5D
} ALIKE EXCEPT AS NOTED

FOR FIELD SPLICE DETAILS SEE DRAWINGS X1 & X2.
FOR GIRDER STANDARD DETAILS SEE DRAWING X3 & X4.
FOR CAMBER & FLANGE DIAGRAMS SEE DRAWING C2.
FOR GENERAL NOTES SEE DRAWING GN1.
T2 DENOTES MATERIAL SUBJECT TO CHARPY V-NOTCH TESTING.