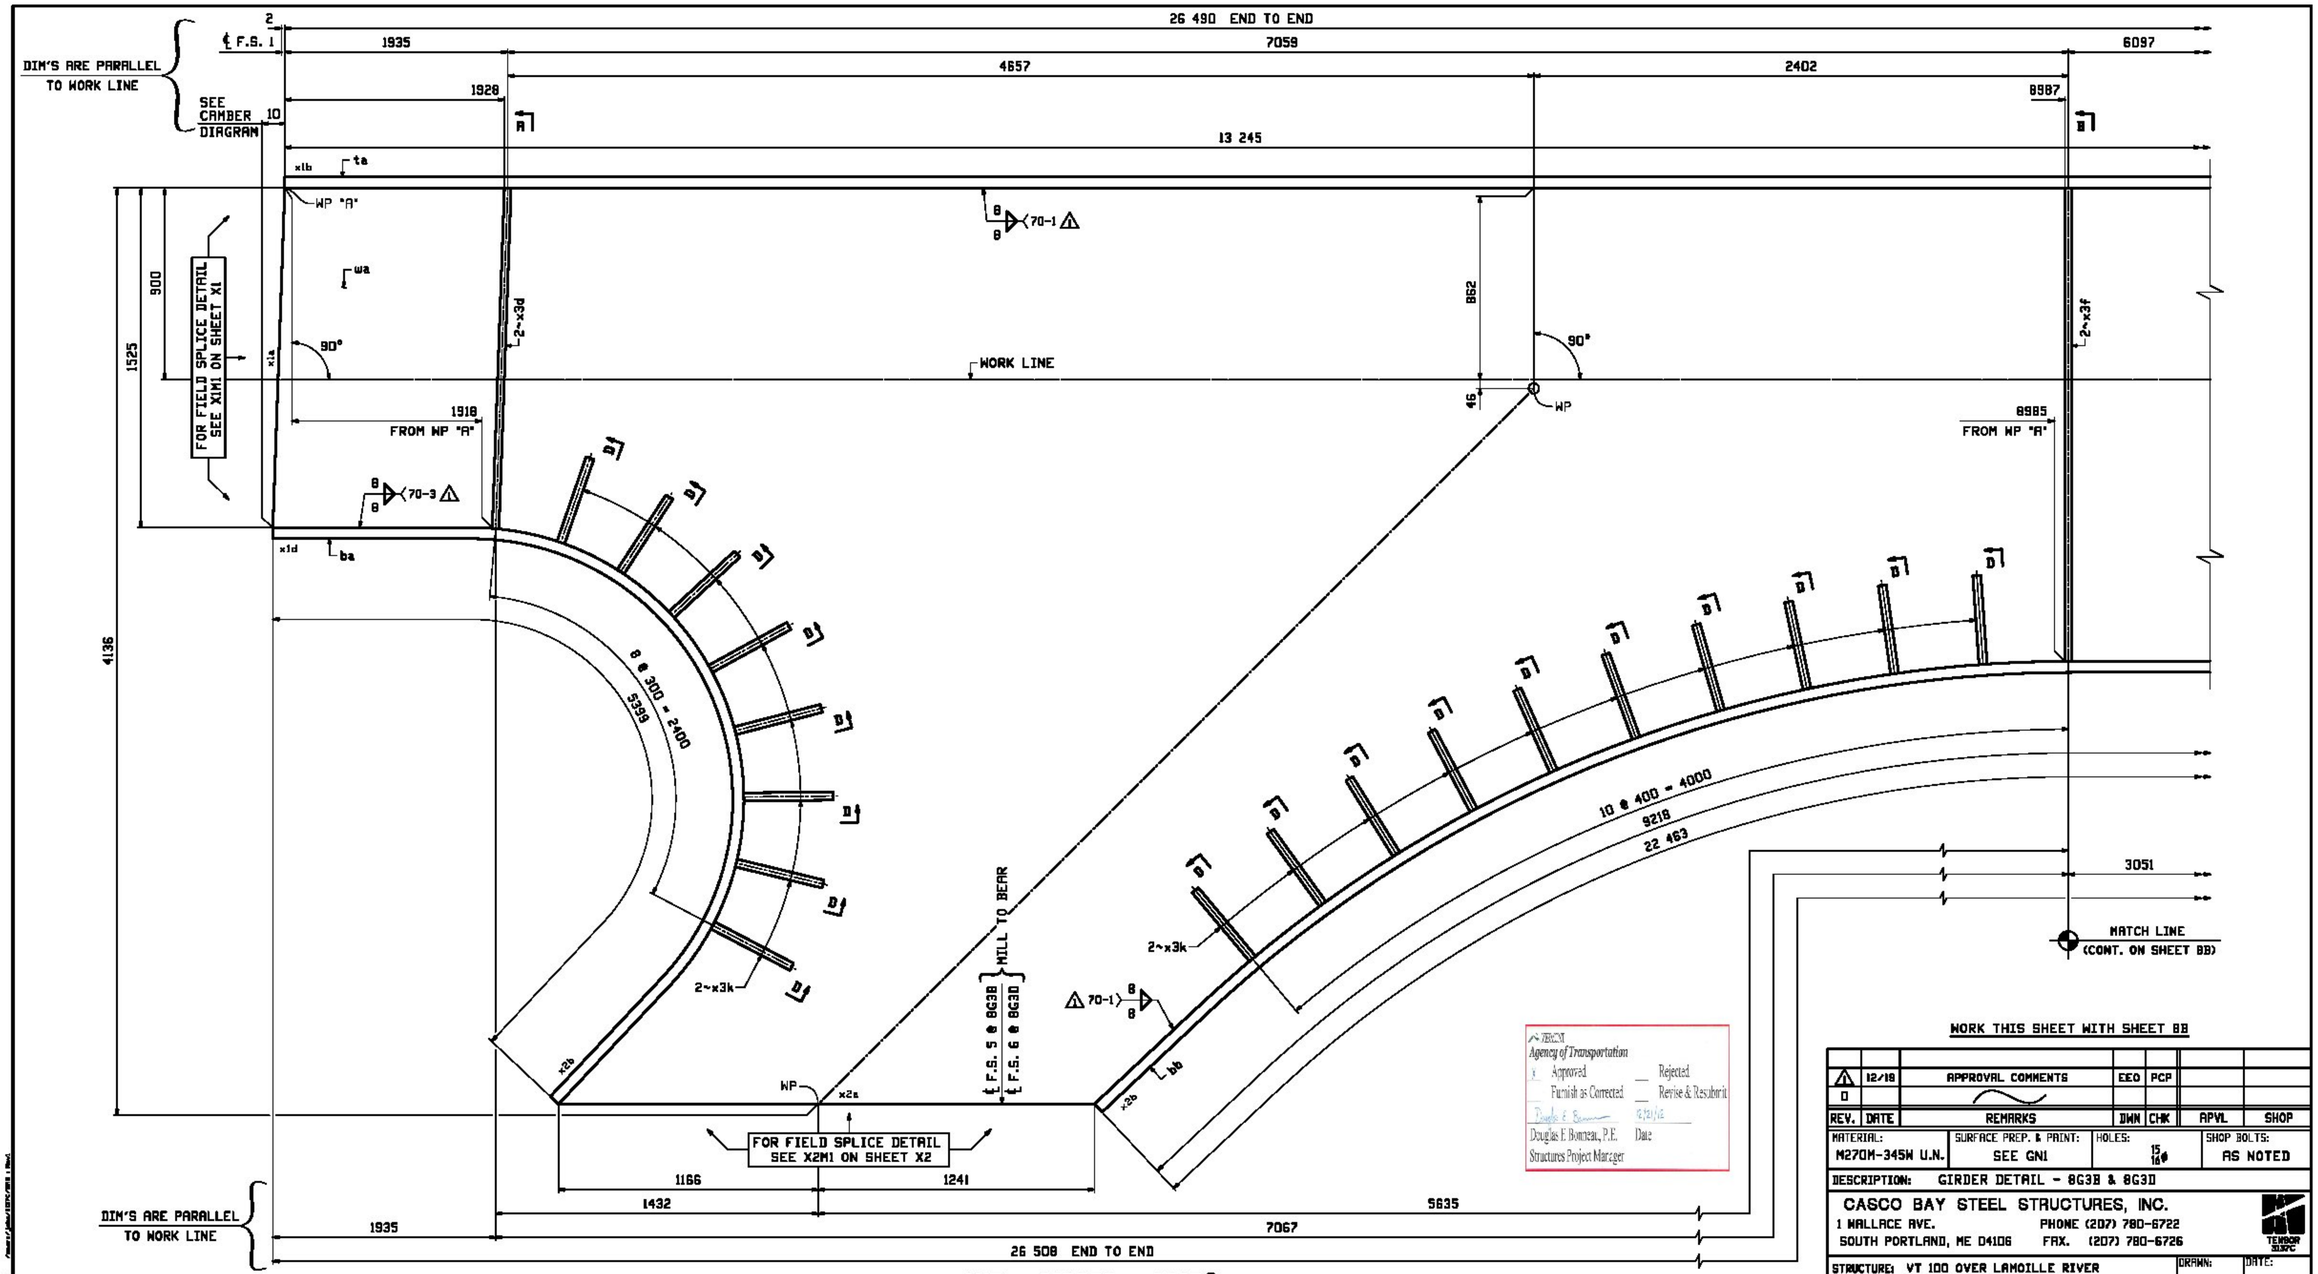

Agency of Transportation
Approved — Rejected
Furnish as Corrected — Revise & Resubmit
Douglas E. Bouneau, P.E. Date
Structures Project Manager

WORK THIS SHEET WITH SHEET BB

ONE - GIRDER - BG3B
ONE - GIRDER - BG3D
} ALIKE EXCEPT AS NOTED

FOR FIELD SPLICE DETAILS SEE DRAWINGS X1 & X2.
FOR GIRDER STANDARD DETAILS SEE DRAWING X3 & X4.
FOR CAMBER & FLANGE DIAGRAMS SEE DRAWING C2.
FOR GENERAL NOTES SEE DRAWING GN1.
T2 DENOTES MATERIAL SUBJECT TO CHARPY V-NOTCH TESTING.

REV.	DATE	REMARKS	DWN	CHK	APVL	SHOP
1	12/18	APPROVAL COMMENTS	EEO	PCP		
0						

MATERIAL: M270M-345W U.N.	SURFACE PREP. & PAINT: SEE GN1	HOLES: 15/16ø	SHOP BOLTS: AS NOTED

DESCRIPTION: GIRDER DETAIL - BG3B & BG3D

CASCO BAY STEEL STRUCTURES, INC.
1 WALLACE AVE. PHONE (207) 780-6722
SOUTH PORTLAND, ME 04106 FAX. (207) 780-6726

STRUCTURE: VT 100 OVER LAMOILLE RIVER MORRISTOWN, VT LAMOILLE COUNTY STP F 029-1 (2) C/1	DRAWN: EEO	DATE: 08/27
	CHKD: PCP	DATE: 09/17
LOCATION: MORRISTOWN, VT	JOB NO.	DWG NO.
PROJ NO. STP F 029-1(2)C/1	521	BAB
CUSTOMER: WINTERSET, INC.		REV. 1