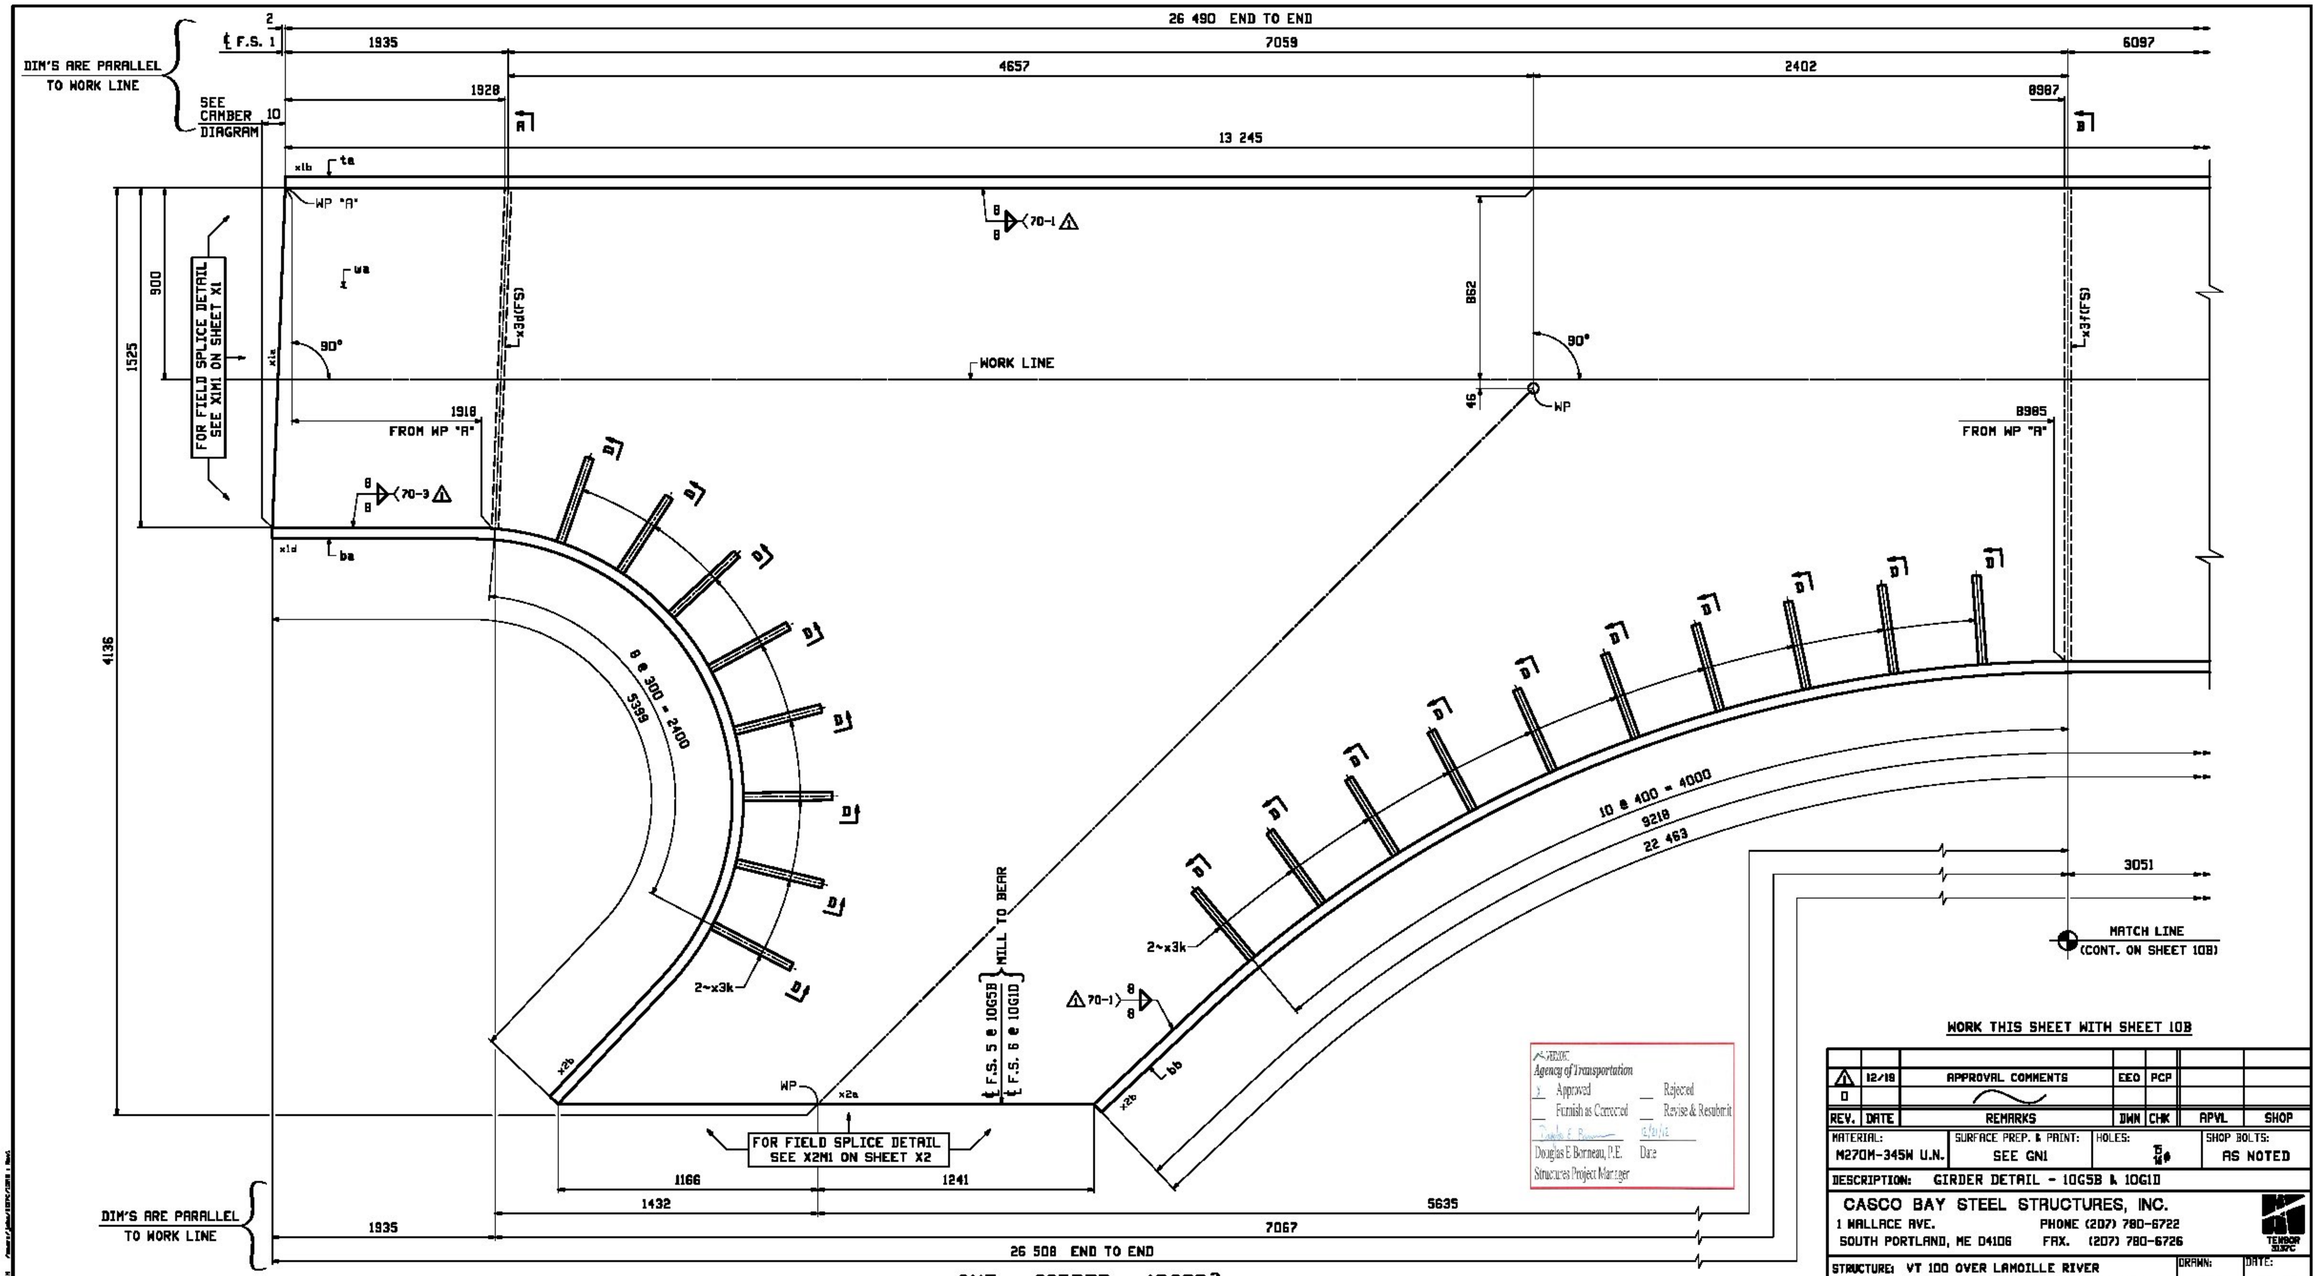

WORK THIS SHEET WITH SHEET 10B

REV.	DATE	REMARKS	DWN	CHK	APVL	SHOP
1	12/18	APPROVAL COMMENTS	EEO	PCP		
0						

MATERIAL: M270M-345W U.N. | SURFACE PREP. & PAINT: SEE GN1 | HOLES: 13/16ø | SHOP BOLTS: AS NOTED

DESCRIPTION: GIRDER DETAIL - 10G5B & 10G1D

CASCO BAY STEEL STRUCTURES, INC.
1 WALLACE AVE. SOUTH PORTLAND, ME 04106
PHONE (207) 780-6722 FAX. (207) 780-6726

STRUCTURE: VT 100 OVER LAMOILLE RIVER
MORRISTOWN, VT LAMOILLE COUNTY
STP F 029-1 (2) C/1

DRAWN: EEO DATE: 08/27
CHKD: PCP DATE: 09/17

LOCATION: MORRISTOWN, VT
PROJ NO. STP F 029-1(2)C/1
CUSTOMER: WINTERSET, INC.
JOB NO. 521
DWG NO. 10AB
REV. 1

ONE - GIRDER - 10G5B
ONE - GIRDER - 10G1D
} ALIKE EXCEPT AS NOTED

FOR FIELD SPLICE DETAILS SEE DRAWINGS X1 & X2.
FOR GIRDER STANDARD DETAILS SEE DRAWING X3 & X4.
FOR CAMBER & FLANGE DIAGRAMS SEE DRAWING C2.
FOR GENERAL NOTES SEE DRAWING GN1.
T2 DENOTES MATERIAL SUBJECT TO CHARPY V-NOTCH TESTING.

Agency of Transportation
Approved — Rejected
Furnish as Corrected — Revise & Resubmit
Douglas E. Bonneau, P.E. Date
Structures Project Manager