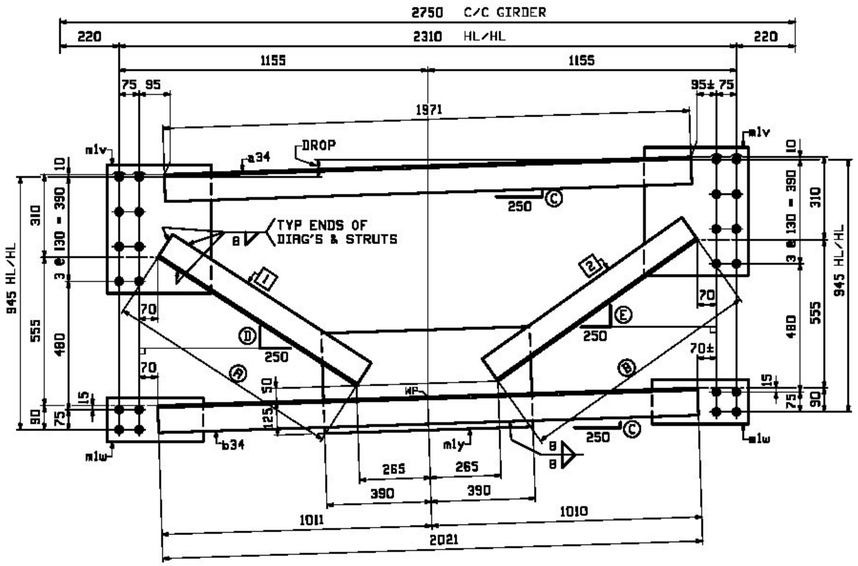

INT. CROSSFRAMES - MARK "A"

TYPE D6C

MARK "A"	QTY	DROP	Ⓐ	Ⓑ	Ⓒ	Ⓓ	Ⓔ	Ⓧ	Ⓨ	1	2
34CF1	2	66	885	915	8	162	177	2472	2522	c34	d34
34CF2	2	39	891	909	5	165	174	2481	2511	f34	g34

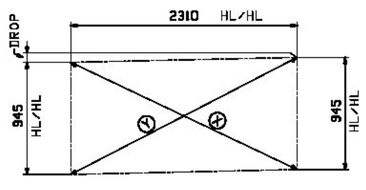

CROSS CHECK - MARK "A"

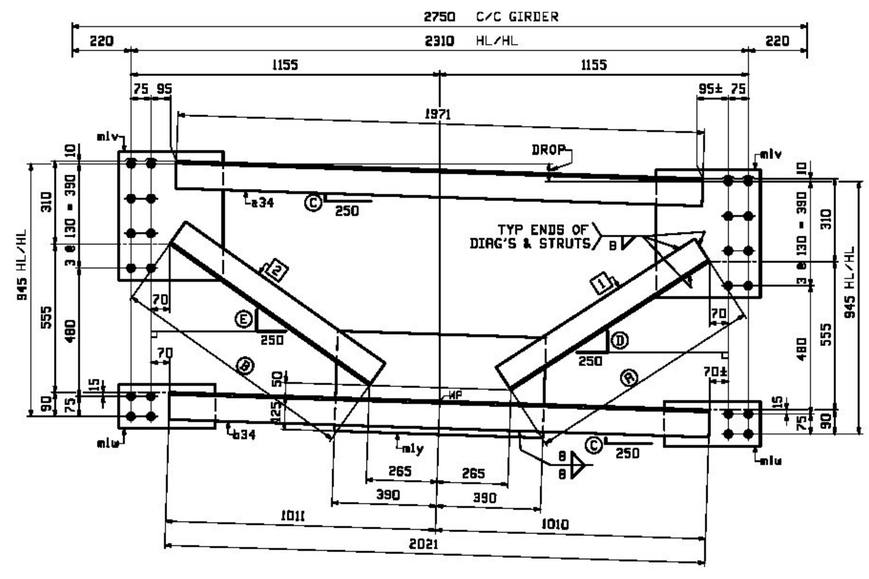

INT. CROSSFRAMES - MARK "B"

TYPE D6C

MARK "B"	QTY	DROP	Ⓐ	Ⓑ	Ⓒ	Ⓓ	Ⓔ	Ⓧ	Ⓨ	1	2
34CF3	2	66	885	915	8	162	177	2472	2522	c34	d34
34CF4	2	39	891	909	5	165	174	2481	2511	f34	g34

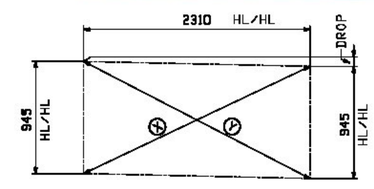

CROSS CHECK - MARK "B"

FORM INFO		SHOP	BILL OF MATERIAL					JOB NO. 521	DRAWING NO. 34	REV.
PAGE	LINE	MARK	QTY	MARK	MATERIAL	LENGTH m	LENGTH mm	REMARKS	WT	PROCUREMENT NOTES
		34CF1	2		CROSSFRAMES				165 kg 363 lb	
		34CF3	2		CROSSFRAMES				165 kg 363 lb	
5	B		4	a34	L 102x102x9.5	1	971		28 kg 61 lb	
5	C		4	b34	L 102x102x9.5	2	021		30 kg 66 lb	
5	N		4	c34	L 102x102x9.5	0	865		12 kg 26 lb	
5	N		4	d34	L 102x102x9.5	0	915		13 kg 28 lb	
5	D		8	mlv	PL 13x390	0	480		16 kg 35 lb	
5	E		8	mlw	PL 13x165	0	360		8 kg 17 lb	
5	F		4	mly	PL 13x375	0	780		30 kg 66 lb	
		34CF2	2		CROSSFRAMES				165 kg 363 lb	
		34CF4	2		CROSSFRAMES				165 kg 363 lb	
5	B		4	a34	L 102x102x9.5	1	971		28 kg 61 lb	
5	C		4	b34	L 102x102x9.5	2	021		30 kg 66 lb	
5	N		4	f34	L 102x102x9.5	0	891		12 kg 26 lb	
5	N		4	g34	L 102x102x9.5	0	909		13 kg 28 lb	
5	D		8	mlv	PL 13x390	0	480		16 kg 35 lb	
5	E		8	mlw	PL 13x165	0	360		8 kg 17 lb	
5	F		4	mly	PL 13x375	0	780		30 kg 66 lb	

VERMONT Agency of Transportation

X Approved — Rejected

Furnish as Corrected — Revise & Resubmit

Douglas E. Bonneau — 12/10/12

Douglas E Bonneau, P.E. — Date

Structures Project Manager

NOTE:
FOR GENERAL NOTES AND WELD TERMINATION DETAIL SEE DRAWING GN1.

REV.	DATE	REMARKS	DWN	CHK	APVL	SHOP
0						

MATERIAL:	SURFACE PREP. & PAINT:	HOLES:	SHOP BOLTS:
M270M-345W	SEE DWG GN1	15/16" ø	NONE

DESCRIPTION: CROSSFRAMES

CASCO BAY STEEL STRUCTURES, INC.
1 WALLACE AVE. SOUTH PORTLAND, ME 04106
PHONE (207) 780-6722 FAX. (207) 780-6726

STRUCTURE: VT 100 OVER LAMOILLE RIVER
MORRISTOWN, VT LAMOILLE COUNTY
STP F 029-1 (2) C/1

DRAWN: JTB	DATE: 08/21		
CHKD: PCP	DATE: 09/17		
LOCATION: MORRISTOWN, VT		JOB NO.	DWG NO.
PROJ NO. STP F 029-1(2)C/1		521	34
CUSTOMER: WINTERSET, INC.			REV. 0

McFarland Johnson

X Reviewed — Furnish As Corrected

Rejected — Revise and Resubmit

This review is only for general conformance with the design concept and the information given in the Construction Documents. Corrections or comments made on the shop drawings during the review do not relieve the Contractor from compliance with the requirements of the Plans and Specifications. Review of a specific item shall not include review of an assembly of which an item is a component. The Contractor is responsible for dimensions to be confirmed and corrected at the job site; information that pertains solely to the fabrication process or to the means, methods, techniques, sequences and procedures of construction; coordination of the Work with that of other trades and performing all Work in a safe and satisfactory manner.

Date October 24, 2012

By D. Kull