FORM INFO		SHOP	BILL OF MATERIAL					JOB NO. 521	DRAWING NO. 35	REV.
PAGE	LINE	MARK	QTY	MARK	MATERIAL	LENGTH m	LENGTH mm	REMARKS	WT	PROCUREMENT NOTES
					LATERAL BRACING					
6	B	35LB1	2		WT 155x19.35	3	018	PAINTED	88 kg 192 lbs	
6	B	35LB3	36		WT 155x19.35	3	036	NO PAINT	58 kg 130 lbs	
6	B	35LB5	2		WT 155x19.35	3	040	PAINTED	85 kg 192 lbs	
6	E	35LB6	24		WT 155x19.35	2	906	NO PAINT	38 kg 83 lbs	
6	E	35LB7	4		WT 155x19.35	2	883	NO PAINT	38 kg 83 lbs	
6	D	35LB8	4		WT 155x19.35	2	843	NO PAINT	88 kg 191 lbs	
6	E	35LB9	20		WT 155x19.35	2	778	NO PAINT	54 kg 118 lbs	
6	C	35LB10	4		WT 155x19.35	2	475	NO PAINT	48 kg 105 lbs	

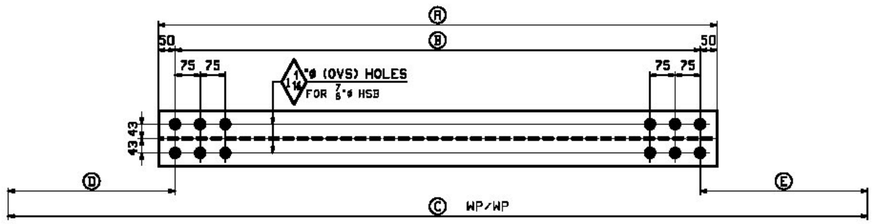

LATERALS - MARK "A"

	MARK "A"	QTY	Ⓐ	Ⓑ	Ⓒ	Ⓓ	Ⓔ
PAINTED (SEE DWG GN1) →	35LB1	2	3018	2918	4280	681	681
	35LB3	36	3036	2936	4298	681	681
PAINTED (SEE DWG GN1) →	35LB5	2	3040	2940	4302	681	681
	35LB6	24	2906	2806	4108	651	651
	35LB7	4	2883	2783	4147	648	716
	35LB8	4	2843	2743	4110	716	651
	35LB9	20	2778	2678	4110	716	716
	35LB10	4	2475	2375	3485	555	555

NOTE:
FOR GENERAL NOTES SEE DRAWING GN1.

REV.	DATE	REMARKS	DWN	CHK	APVL	SHOP
0						

MATERIAL:	SURFACE PREP. & PAINT:	HOLES:	SHOP BOLTS:
M270M-345W	SEE DWG GN1	AS NOTED	NONE

DESCRIPTION: LATERAL BRACING

CASCO BAY STEEL STRUCTURES, INC.
1 WALLACE AVE. PHONE (207) 780-6722
SOUTH PORTLAND, ME 04106 FAX. (207) 780-6726

TEMSOR 2030PC

STRUCTURE: VT 100 OVER LAMOILLE RIVER
MORRISTOWN, VT LAMOILLE COUNTY
STP F 029-1 (2) C/1

DRAWN:	DATE:
JTB	08/21
CHKD:	DATE:
PCP	09/17

LOCATION:	MORRISTOWN, VT	JOB NO.	DWG NO.
PROJ NO.	STP F 029-1(2)C/1	521	35
CUSTOMER:	WINTERSET, INC.		REV. △

X Reviewed ____ Furnish As Corrected
____ Rejected ____ Revise and Resubmit

This review is only for general conformance with the design concept and the information given in the Construction Documents. Corrections or comments made on the shop drawings during the review do not relieve the Contractor from compliance with the requirements of the Plans and Specifications. Review of a specific item shall not include review of an assembly of which an item is a component. The Contractor is responsible for dimensions to be confirmed and corrected at the job site; information that pertains solely to the fabrication process or to the means, methods, techniques, sequences and procedures of construction; coordination of the Work with that of other trades and performing all Work in a safe and satisfactory manner.

Date October 24, 2012

McFarland Johnson

By D. Kull

VERMONT
Agency of Transportation

X Approved ____ Rejected
____ Furnish as Corrected ____ Revise & Resubmit

Douglas E. Bonneau 12/10/12

Douglas E Bonneau, P.E. Date
Structures Project Manager