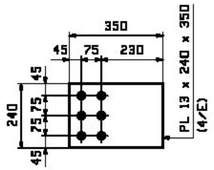

16 ~ mla
BTM GUSSET - TYPE D1

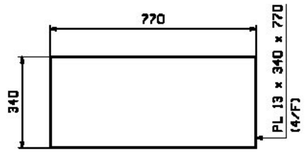

8 ~ mlb
CENTER GUSSET - TYPE D1

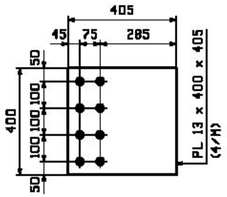

96 ~ mlc
TOP GUSSET - TYPES D2 & D3

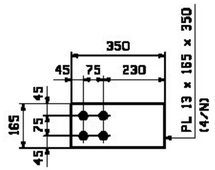

96 ~ mld
BTM GUSSET - TYPES D2 & D3

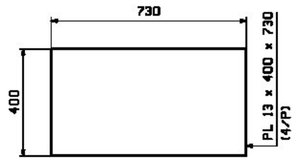

48 ~ mlf
CENTER GUSSET - TYPES D2 & D3

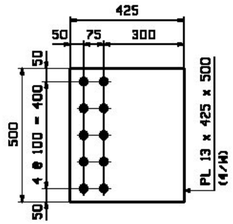

16 ~ mlg
TOP GUSSET - TYPE D4

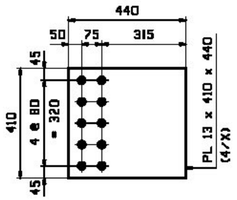

16 ~ mlk
BTM GUSSET - TYPE D4

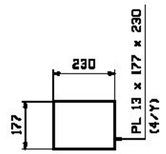

8 ~ mlm
CENTER GUSSET - TYPE D4

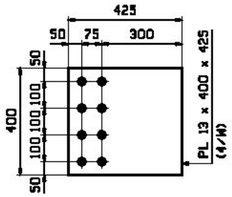

88 ~ mln
TOP GUSSET - TYPE D5

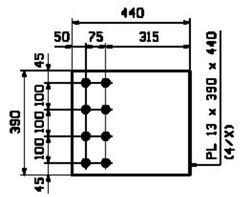

88 ~ mlp
BTM GUSSET - TYPE D5

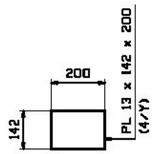

44 ~ mlt
CENTER GUSSET - TYPE D5

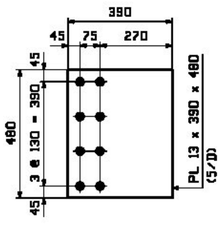

48 ~ mlv
TOP GUSSET - TYPE D6

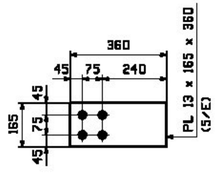

48 ~ mlw
BTM GUSSET - TYPE D6

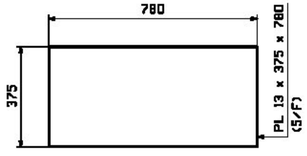

24 ~ mly
CENTER GUSSET - TYPE D6

NOTE:
FOR GENERAL NOTES SEE DRAWING GN1.

REV.	DATE	REMARKS	DWN	CHK	APVL	SHOP
0						

MATERIAL:	SURFACE PREP. & PAINT:	HOLES:	SHOP BOLTS:
M270-345W	SEE DWG GN1	15/16"ø	NONE

DESCRIPTION: CROSSFRAME STANDARDS

CASCO BAY STEEL STRUCTURES, INC.
1 WALLACE AVE. PHONE (207) 780-6722
SOUTH PORTLAND, ME 04106 FAX. (207) 780-6726

STRUCTURE: VT 100 OVER LAMOILLE RIVER MORRISTOWN, VT LAMOILLE COUNTY STP F 029-1 (2) C/1	DRAWN: JTB	DATE: 08/13	
	CHKD: PCP	DATE: 09/17	
LOCATION: MORRISTOWN, VT	JOB NO.	DWG NO.	
PROJ NO. STP F 029-1(2)C/1	521	M1	
CUSTOMER: MINTERSET, INC.		REV. △	

VERMONT
Agency of Transportation
X Approved
Furnish as Corrected
Rejected
Revise & Resubmit
Douglas E. Bonneau 12/10/12
Douglas E Bonneau, P.E. Date
Structures Project Manager

X Reviewed
Rejected
Furnish As Corrected
Revise and Resubmit

This review is only for general conformance with the design concept and the information given in the Construction Documents. Corrections or comments made on the shop drawings during the review do not relieve the Contractor from compliance with the requirements of the Plans and Specifications. Review of a specific item shall not include review of an assembly of which an item is a component. The Contractor is responsible for dimensions to be confirmed and corrected at the job site; information that pertains solely to the fabrication process or to the means, methods, techniques, sequences and procedures of construction; coordination of the Work with that of other trades and performing all Work in a safe and satisfactory manner.

Date October 24, 2012
McFarland Johnson
By D. Kull