DURABLE 4 INCH WHITE LINE, TYPE I TAPE
STA. 223+25 - STA. 237+75 (SOLID LT & RT)
STA. 223+25 - STA. 237+75 (DASHED RT)

DURABLE 4 INCH YELLOW LINE, TYPE I TAPE
STA. 223+25 - STA. 237+75 (CENTERLINE LT)

TEMPORARY 4 INCH WHITE LINE, PAINT
STA. 223+25 - STA. 237+75 (SOLID LT & RT)
STA. 223+25 - STA. 237+75 (DASHED RT)

TEMPORARY 4 INCH YELLOW LINE, PAINT
STA. 223+25 - STA. 237+75 (CENTERLINE LT)

REMOVING SIGNS
AS SHOWN - 14

ERECTING SALVAGED SIGNS
AS SHOWN - 1

NOT DONE
~~PLACE STONE FILL, TYPE IAT DOWNHILL END OF BITUMINOUS CONCRETE CURB, TYPE A SEE DETAIL ON SHEET 99~~

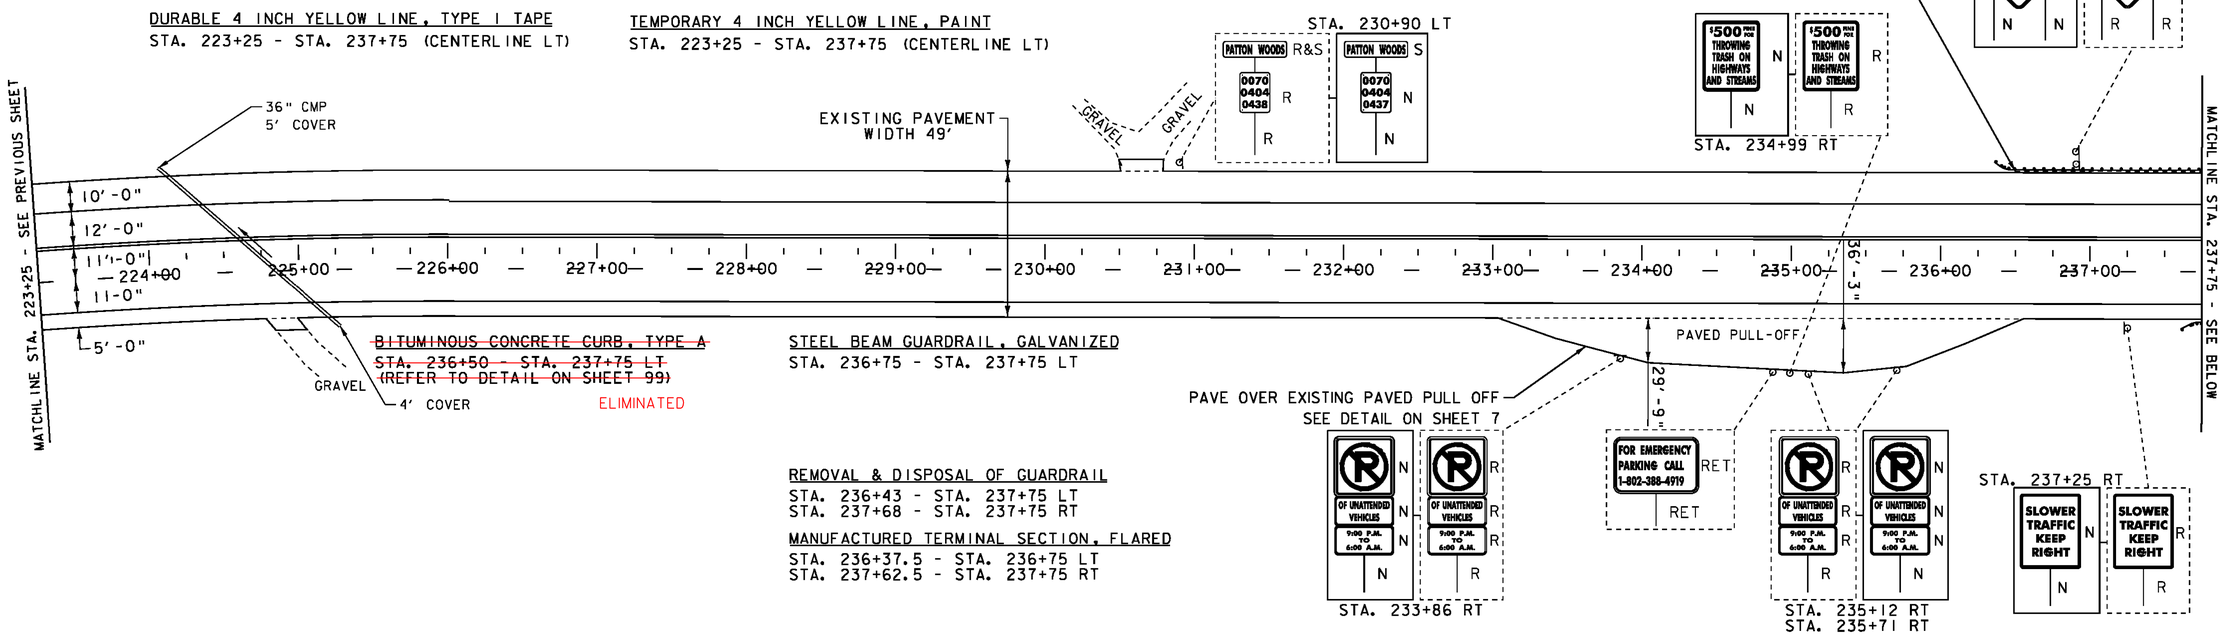

STEEL BEAM GUARDRAIL, GALVANIZED
STA. 236+75 - STA. 237+75 LT

REMOVAL & DISPOSAL OF GUARDRAIL
STA. 236+43 - STA. 237+75 LT
STA. 237+68 - STA. 237+75 RT

MANUFACTURED TERMINAL SECTION, FLARED
STA. 236+37.5 - STA. 236+75 LT
STA. 237+62.5 - STA. 237+75 RT

REHAB, DROP INLETS, CATCH BASINS, OR MANHOLES, CLASS I OR CLASS II
STA. 238+59 LT
STA. 239+74 RT

DURABLE 4 INCH WHITE LINE, TYPE I TAPE
STA. 237+75 - STA. 252+50 (SOLID LT & RT)
STA. 237+75 - STA. 252+50 (DASHED RT)

DURABLE 4 INCH YELLOW LINE, TYPE I TAPE
STA. 237+75 - STA. 252+50 (CENTERLINE LT)

TEMPORARY 4 INCH WHITE LINE, PAINT
STA. 237+75 - STA. 252+50 (SOLID LT & RT)
STA. 237+75 - STA. 252+50 (DASHED RT)

TEMPORARY 4 INCH YELLOW LINE, PAINT
STA. 237+75 - STA. 252+50 (CENTERLINE LT)

REMOVING SIGNS
AS SHOWN - 1

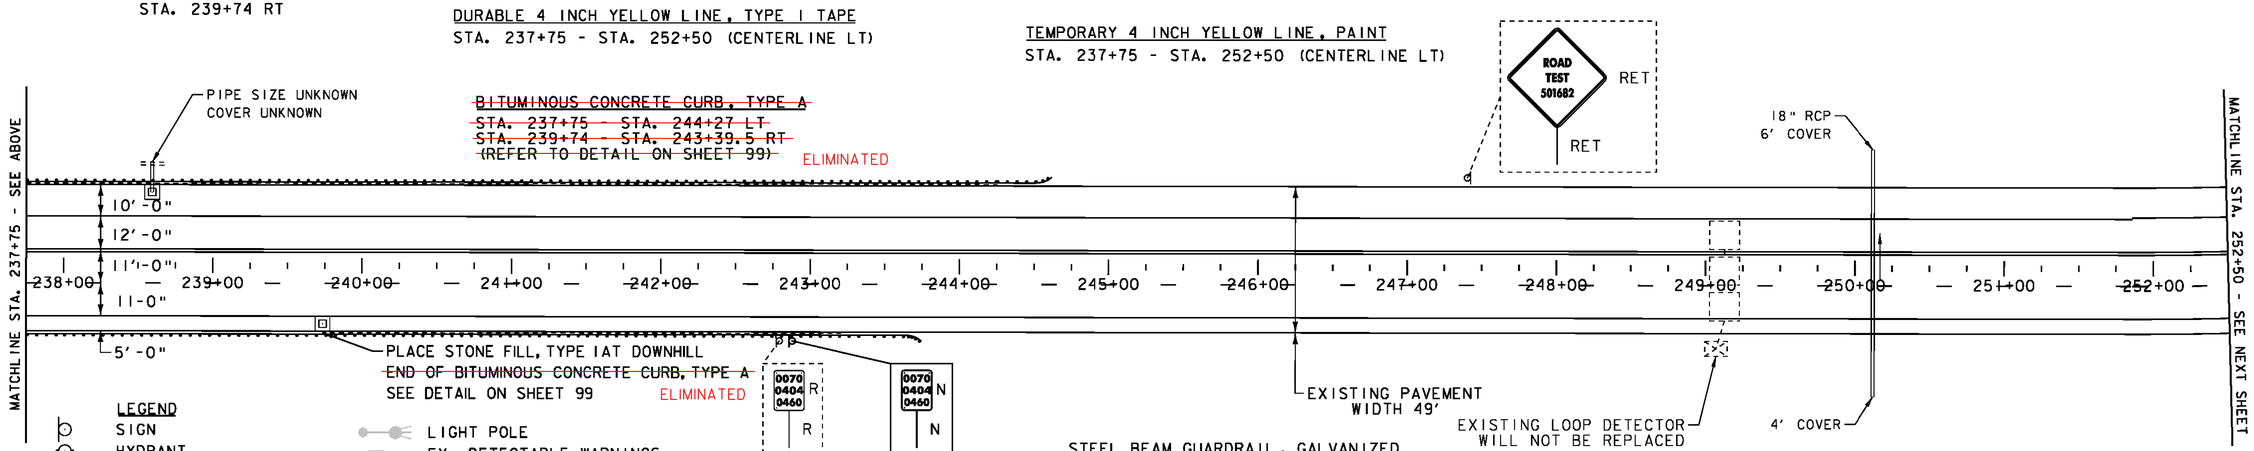

STEEL BEAM GUARDRAIL, GALVANIZED
STA. 237+75 - STA. 244+25 LT
STA. 238+00 - STA. 243+37.5 RT

MANUFACTURED TERMINAL SECTION, FLARED
STA. 237+75 - STA. 238+00 RT
STA. 243+37.5 - STA. 243+75 RT
STA. 244+25 - STA. 244+62.5 LT

REMOVAL & DISPOSAL OF GUARDRAIL
STA. 237+75 - STA. 244+56 LT
STA. 237+75 - STA. 243+68 RT

LEGEND

	SIGN		LIGHT POLE
	HYDRANT		EX. DETECTABLE WARNINGS
	MANHOLE		JUNCTION BOX
	VALVE		PED BUTTON
	GAS PIPELINE MARKER		ELECTRICAL BOX
	CATCH BASIN / DROP INLET		SIGNAL
	CURB INLET		PEDESTAL POST
	TRAFFIC CONTROL BOX		STRAIN POLE
	PARKING METER		CAMERA
	UTILITY POLE	VDZ	VIDEO DETECTION ZONE

SIGN LEGEND
R = REMOVE
R&S = REMOVE AND SALVAGE
RET = RETAIN
S = SALVAGE
N = NEW
B-B = BACK TO BACK

NOT TO SCALE

PROJECT LAYOUT SHEET 4

PROJECT NAME: CHARLOTTE-SOUTH BURLINGTON
PROJECT NUMBER: NH 2907(1)

FILE NAME: p108206.dgn
PROJECT LEADER: CDL
DESIGNED BY: BMB
PLOT FILE: p108206_20.1
PLOT DATE: 4/19/12
DRAWN BY: BMB
CHECKED BY: EPD
SHEET 20 OF 107