STATE OF VERMONT
AGENCY OF TRANSPORTATION

TRAFFIC SIGN SUMMARY SHEET 31

MILEMARKER, STATION, OR SIGN NUMBER	SIGN LEGEND	SIGN DIMENSIONS EA	WIDTH (in)	HEIGHT (in)	NEW & SALVAGED SIGNS "A"	"B"	SALV SIGN	SALV TIS	EXIST POST RETAIN	EXIST POST SALVAGE	NEW SIGN POSTS NO. OF POSTS	FLANGED CHANNEL lb/ft 1.12	2.0	3.0	SQUARE STEEL (in) lb/ft 1.75	2.0	2.5	ANCHOR	SLEEVE	TUBULAR ALUMINUM Ø (in) lb/ft 3.0	4.0	4.0 MOD	TUBULAR STEEL Ø (in) FOUND-ATION	lb/ft 3.0	3.5	4.0	5.0	W-SHAPE STEEL FTG. SIZE 24"	30"	WEIGHT	POST SIZE	SIGN FRAMEMENT REQUIRED	REMARKS • SHSM = FHWA STANDARD HIGHWAY SIGNS AND MARKINGS BOOK	SIGN DETAIL DETAIL IN •SHSM	DETAIL ON DWG. NUMBER	STD. SHEET NUMBER
STA 75+84 LT SOUTH BURLINGTON							1				1					13'-6" X		X																MOUNT SALVAGED SIGN ON NEW POST			
	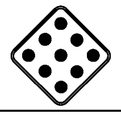						1																											MOUNT SALVAGED SIGN ON NEW POST			
		1	6	10	0.42																													VD-700 MOUNT MILEMARKER PLAQUE BENEATH OBJECT MARKER SIGN			E-138
STA. 76+06 RT SOUTH BURLINGTON	 	1 1	42 42	12 12	3.50 3.50						1					X 11'-0"		X																D3-1 SIGN SHALL BE WHITE LETTERS ON A BLUE BACKGROUND D3-1 SIGN SHALL BE WHITE LETTERS ON A BLUE BACKGROUND		95 96	
STA 76+74 RT SOUTH BURLINGTON		1	24	30	5.00						1					13'-6" X		X																R2-1	SHSM		
STA 78+41 LT SOUTH BURLINGTON		1	60	30	12.50						2					13'-3" X 13'-3"		X																VR-941			E-145A
STA. 79+14 RT SOUTH BURLINGTON		1	48	30	10.00						2					13'-0" X 13'-3"		X																VR-935L			E-145B
STA. 80+29 LT SOUTH BURLINGTON		1	36	30	7.50						2					13'-3" X 13'-9"		X																VR-922			E-145A
STA. 80+83 RT SOUTH BURLINGTON		1	36	12	3.00						1					X 11'-0"		X																D3-1 SIGN SHALL BE WHITE LETTERS ON A BLUE BACKGROUND		96	
STA 82+15 LT SOUTH BURLINGTON		1	60	30	12.50						2					13'-0" X 13'-0"		X																VR-941			E-145A
FINAL POST LENGTHS ARE TO BE DETERMINED IN THE FIELD. POST SIZES ARE COMPUTED BASED ON INFORMATION FURNISHED ON THE STANDARD SHEETS AND THE VTRANS "SIGN POST DESIGN GUIDELINE."												LF	LF	LF	LF -	LF 154.75 ~~180~~	LF -		EA.	LB	LB	LB		LB	LB	LB	LB									
TOTALS		SF 57.92	SF	EA. 2	SF							LF			LF 154.75 ~~180~~					LB			EA.	LB				EA.	EA.	LB						

TRAFFIC SIGN SUMMARY SHEET 31

PROJECT NAME: CHARLOTTE - SOUTH BURLINGTON
PROJECT NUMBER: NH 2907(1)

FILE NAME: p10B206.dgn
PROJECT LEADER: CDL
DESIGNED BY: BMB
PLOT FILE: p10B206_88.1
PLOT DATE: 4/19/12
DRAWN BY: BMB
CHECKED BY: EPD
SHEET 88 OF 107