LEGEND

ITEM 613.10 STONE FILL, TYPE I

~~646.402 DURABLE 4 INCH WHITE LINE, THERMOPLASTIC OR~~
646.404 DURABLE 4 INCH WHITE LINE, POLYUREA
(ALL LINES WILL INCLUDE EDGE LINE BREAKS AND RADIUS FOR TOWN HIGHWAYS)
STOCKBRIDGE:
STA 275+50.00 - STA 281+50.00 LT & RT

646.414 DURABLE 4 INCH YELLOW LINE, POLYUREA
(ALL LINES WILL INCLUDE C/L BREAKS FOR TOWN HIGHWAYS) S=SOLID, D=DASHED
STOCKBRIDGE:
STA 275+50.00 - STA 281+50.00 LT S ℄ RT D

646.602 TEMPORARY 4 INCH WHITE LINE, PAINT
(ALL LINES WILL INCLUDE EDGE LINE BREAKS AND RADIUS FOR TOWN HIGHWAYS)
STOCKBRIDGE:
STA 275+50.00 - STA 281+50.00 LT & RT

646.612 TEMPORARY 4 INCH YELLOW LINE, PAINT
(ALL LINES WILL INCLUDE C/L BREAKS FOR TOWN HIGHWAYS) S=SOLID, D=DASHED
STOCKBRIDGE:
STA 275+50.00 - STA 281+50.00 LT S ℄ RT D

~~213.10 MILLED RUMBLE STRIPS~~
~~(ALL CLRS WILL INCLUDE C/L BREAKS FOR TOWN HIGHWAYS)~~
~~STOCKBRIDGE:~~
~~STA 275+50.0 - STA 281+50.0 C/L (600.0 LF)~~

N
VT STATE PLANE GRID

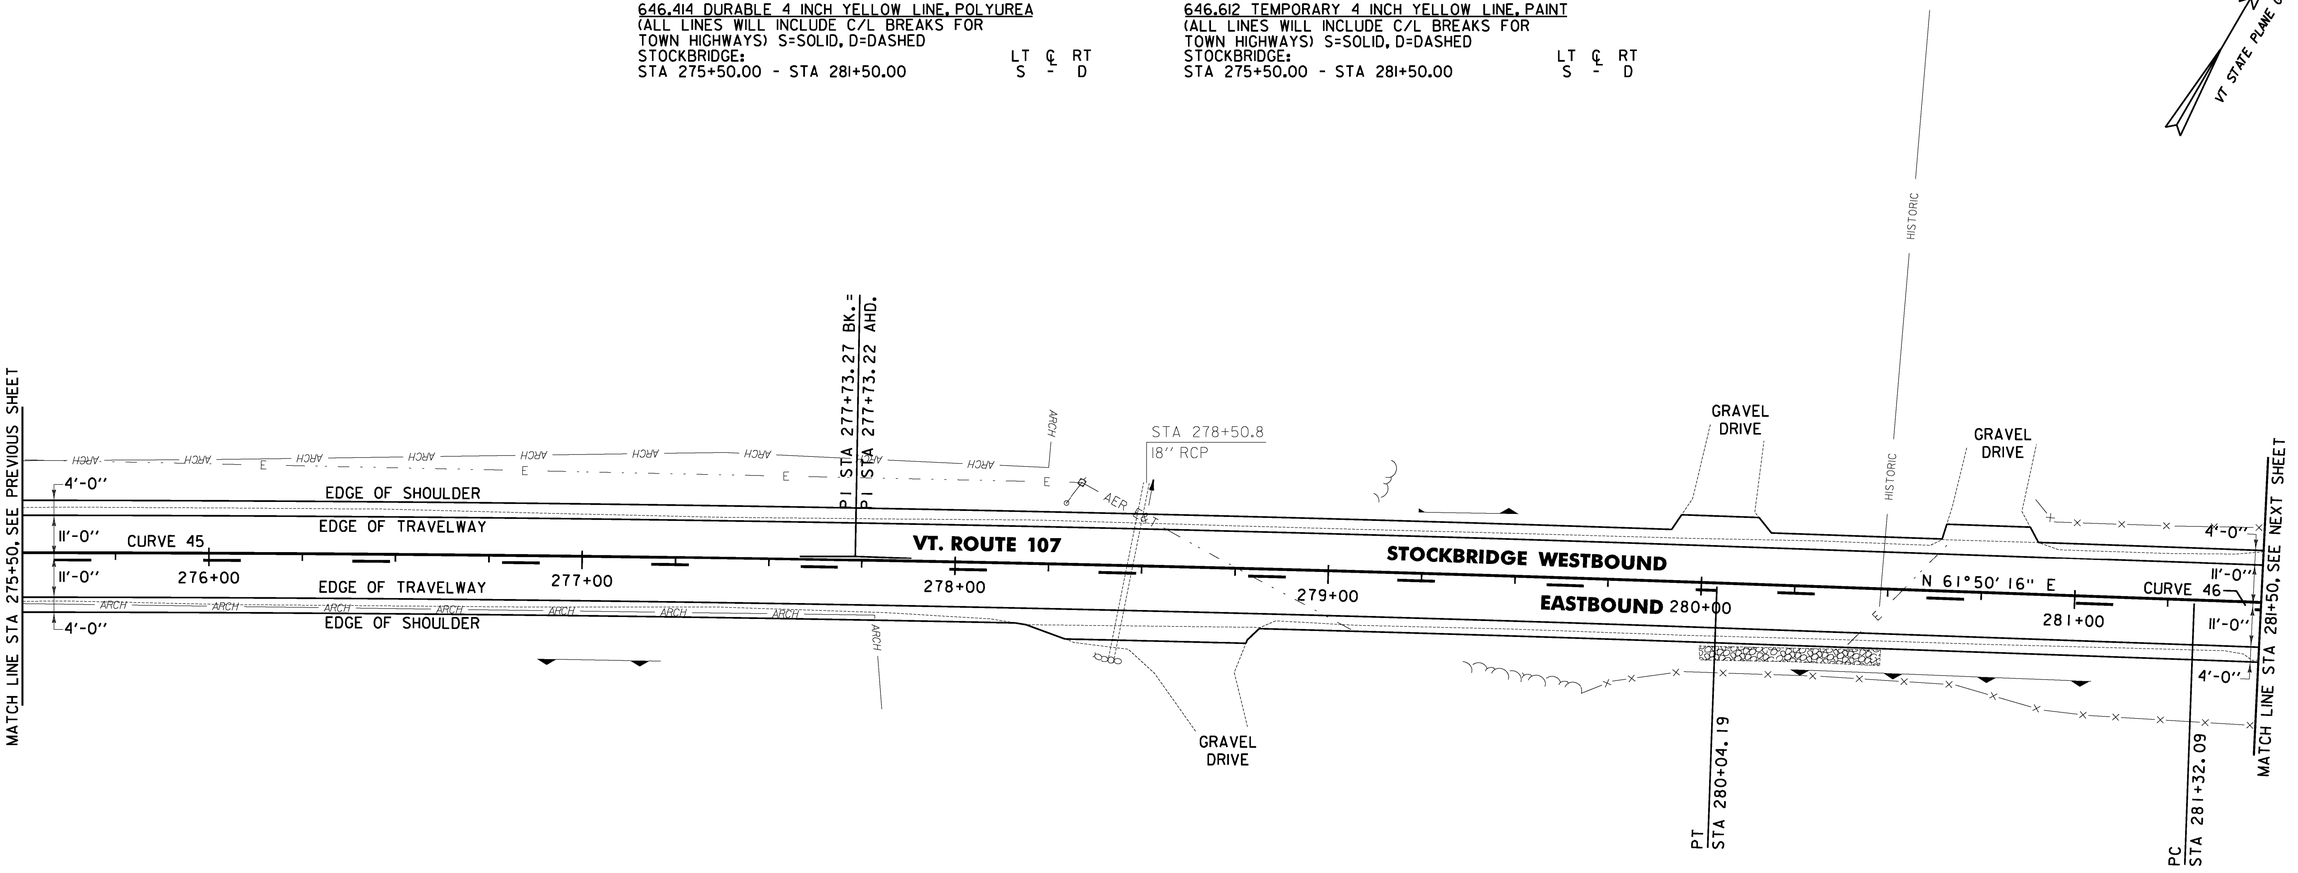

NOTE:

1. THE CONTRACTOR SHALL BE AWARE THAT AN UNDERGROUND FIBER OPTIC FACILITY EXISTS ALONG VT 107. THE LOCATION SHOWN ON THE PLANS IS APPROXIMATE, AND THE POTENTIAL EXISTS FOR CONFLICTS WITH THE FIBER OPTIC AND THE PROPOSED UNDERDRAIN AT VARIOUS LOCATIONS THROUGHOUT THE PROJECT. THE CONTRACTOR IS ADVISED THAT, PRIOR TO CONSTRUCTION, ALL PROPOSED UNDERDRAIN LOCATIONS SHALL BE FIELD VERIFIED WITH THE ENGINEER AND RELOCATED AS NECESSARY TO ELIMINATE ANY CONFLICTS WITH THE FIBER OPTIC FACILITY.

0 20 40
SCALE IN FEET

613.10 STONE FILL, TYPE I
STOCKBRIDGE: STA 278+25.0 - STA 278+50.0 LT (RPE)
STA ~~280+00.0~~ 279+56.0 - STA ~~280+50.0~~ 280+25.0 RT (11.0 CY)

651.40 GRUBBING MATERIAL (6")
STOCKBRIDGE:
STA ~~280+00.0~~ 279+56.0 - STA ~~280+50.0~~ 280+25.0 RT (26.4 SY)

653.20 TEMPORARY EROSION MATTING
STOCKBRIDGE:
STA 277+50.0 - STA 278+25.0 RT (23.9 SY)
STA 278+82.0 - STA 280+50.0 RT (57.8 SY)

CURVE 45		CURVE 46	
△	2°02'09"	△	3°07'11"
D	0°26'27"	D	0°42'58"
R	13000.00'	R	8000.00'
T	230.97'	T	217.85'
L	461.89'	L	435.60'
E	2.05'	E	2.97'
e	0.020 FT/FT	e	0.020 FT/FT

SIGN LEGEND
R = REMOVE
S = SALVAGE
N = NEW
RET = RETAIN
B-B = BACK TO BACK
EXISTING = ----------
NEW = ——————

PROJECT LAYOUT SHEET #47

PROJECT NAME: STOCKBRIDGE-BETHEL
PROJECT NUMBER: STP 2910(11)

FILE NAME: z10b214_bdr_nul_47.dgn
PROJECT LEADER: D.E.G.
DESIGNED BY: L.M.B.
IPARM FILE: z10b214147.i

PLOT DATE: 3/17/2014
DRAWN BY: W.G.P.
CHECKED BY: J.P.S.
SHEET 80 OF 397

FILE NAME = W:\Projects\VANTK2\22426\CADD\.MSTN\z10b214_bdr_nul_47.dgn
DATE/TIME = 3/17/2014
USER = 4916