646.402 DURABLE 4 INCH WHITE LINE, THERMOPLASTIC OR
646.404 DURABLE 4 INCH WHITE LINE, POLYUREA
(ALL LINES WILL INCLUDE EDGE LINE BREAKS AND RADIUS FOR TOWN HIGHWAYS)
STOCKBRIDGE:
STA 287+50.00 - STA 293+50.00 LT & RT

646.414 DURABLE 4 INCH YELLOW LINE, POLYUREA
(ALL LINES WILL INCLUDE C/L BREAKS FOR TOWN HIGHWAYS) S=SOLID, D=DASHED

| STOCKBRIDGE: | LT | ℄ | RT |
|---|---|---|---|
| STA 287+50.00 - STA 292+51.20 | D | - | S |
| STA 292+51.20 - STA 293+50.00 | S | - | S |

646.602 TEMPORARY 4 INCH WHITE LINE, PAINT
(ALL LINES WILL INCLUDE EDGE LINE BREAKS AND RADIUS FOR TOWN HIGHWAYS)
STOCKBRIDGE:
STA 287+50.00 - STA 293+50.00 LT & RT

646.612 TEMPORARY 4 INCH YELLOW LINE, PAINT
(ALL LINES WILL INCLUDE C/L BREAKS FOR TOWN HIGHWAYS) S=SOLID, D=DASHED

| STOCKBRIDGE: | LT | ℄ | RT |
|---|---|---|---|
| STA 287+50.00 - STA 292+51.20 | D | - | S |
| STA 292+51.20 - STA 293+50.00 | S | - | S |

213.10 MILLED RUMBLE STRIPS
(ALL CLRS WILL INCLUDE C/L BREAKS FOR TOWN HIGHWAYS)
STOCKBRIDGE:
STA 287+50.0 - STA 293+50.0 C/L (600.0 LF)

N
VT STATE PLANE GRID

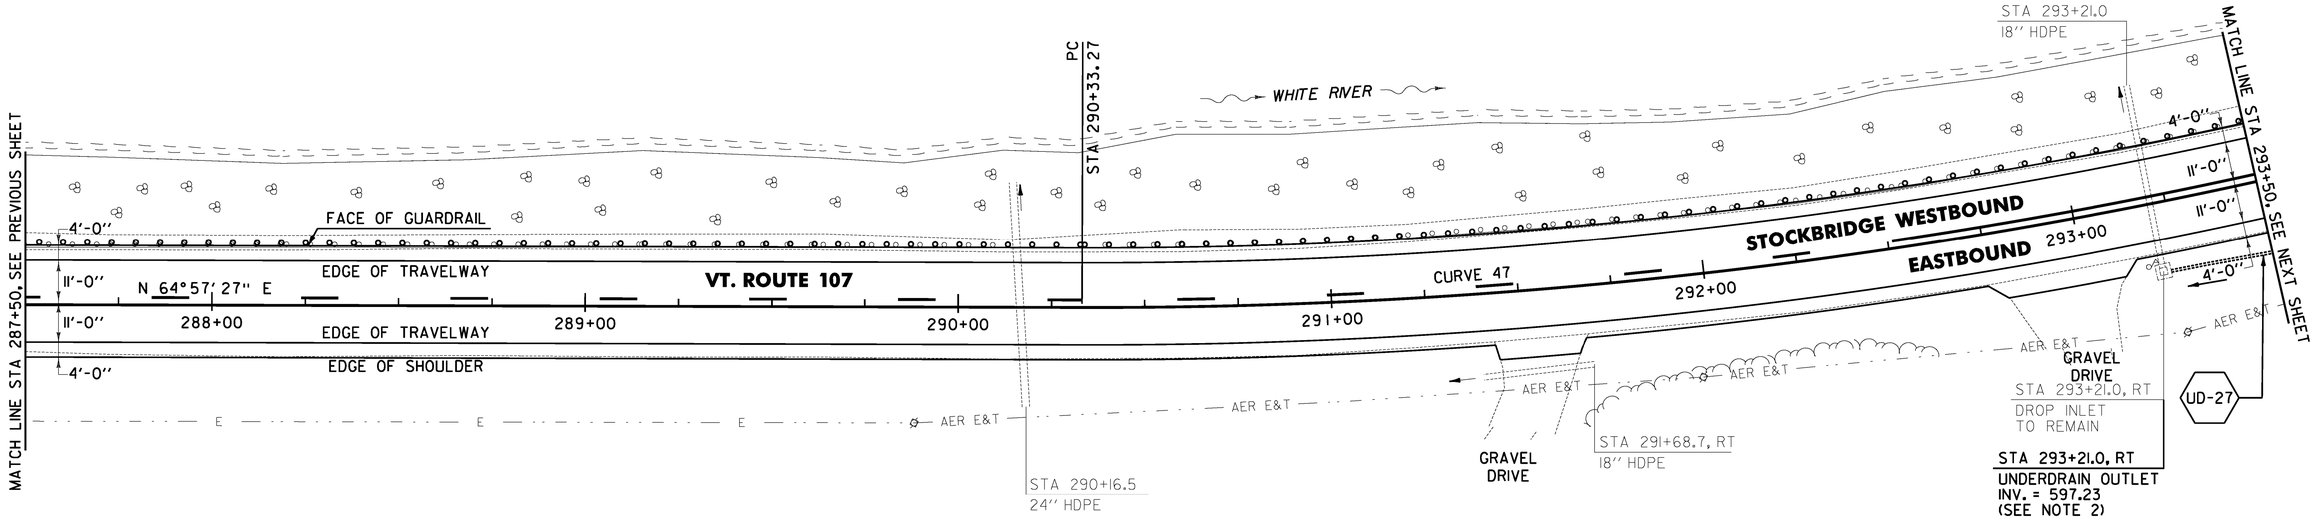


NOTES:

1. THE CONTRACTOR SHALL BE AWARE THAT AN UNDERGROUND FIBER OPTIC FACILITY EXISTS ALONG VT 107. THE LOCATION SHOWN ON THE PLANS IS APPROXIMATE, AND THE POTENTIAL EXISTS FOR CONFLICTS WITH THE FIBER OPTIC AND THE PROPOSED UNDERDRAIN AT VARIOUS LOCATIONS THROUGHOUT THE PROJECT. THE CONTRACTOR IS ADVISED THAT, PRIOR TO CONSTRUCTION, ALL PROPOSED UNDERDRAIN LOCATIONS SHALL BE FIELD VERIFIED WITH THE ENGINEER AND RELOCATED AS NECESSARY TO ELIMINATE ANY CONFLICTS WITH THE FIBER OPTIC FACILITY.
2. SEE SHEET 28 FOR UNDERDRAIN DETAILS.

0 20 40
SCALE IN FEET

621.75 REMOVE AND RESET GUARDRAIL
STOCKBRIDGE:
STA 287+50.0 - STA 293+50.0 LT (600.0 LF)

~~653.20 TEMPORARY EROSION MATTING~~
~~STOCKBRIDGE:~~
~~STA 292+00.0 - STA 292+75.0 RT (20.0 SY)~~
~~STA 293+15.0 - STA 293+50.0 RT (5.0 SY)~~

676.12 REMOVAL OF EXISTING DELINEATOR
STOCKBRIDGE:
STA 287+50.0 - STA 292+75.0 RT (6 EA)

CURVE 47
△ = 44° 34' 56"
D = 3° 57' 54"
R = 1445.00'
T = 592.38'
L = 1124.36'
E = 116.71'
e = 0.064 FT/FT

SIGN LEGEND
R = REMOVE
S = SALVAGE
N = NEW
RET = RETAIN
B-B = BACK TO BACK
EXISTING = ----------
NEW = ——————

**PROJECT LAYOUT SHEET #49**

PROJECT NAME: STOCKBRIDGE-BETHEL
PROJECT NUMBER: STP 2910(1)

| | |
|---|---|
| FILE NAME: z10b214_bdr_nul_49.dgn | PLOT DATE: 3/17/2014 |
| PROJECT LEADER: D.E.G. | DRAWN BY: W.G.P. |
| DESIGNED BY: L.M.B. | CHECKED BY: J.P.S. |
| IPARM FILE: z10b214149.i | SHEET 82 OF 397 |

FILE NAME = W:\Projects\ANY\K2\22426\CADD_MSTN\z10b214_bdr_nul_49.dgn
DATE/TIME = 3/17/2014
USER = 4916