LEGEND

ITEM 613.10 STONE FILL, TYPE I

~~646.402 DURABLE 4 INCH WHITE LINE, THERMOPLASTIC OR~~
646.404 DURABLE 4 INCH WHITE LINE, POLYUREA
(ALL LINES WILL INCLUDE EDGE LINE BREAKS AND RADIUS FOR TOWN HIGHWAYS)
BETHEL:
STA B 5+50.00 - STA B 11+50.00 LT & RT

646.414 DURABLE 4 INCH YELLOW LINE, POLYUREA
(ALL LINES WILL INCLUDE C/L BREAKS FOR TOWN HIGHWAYS) S=SOLID, D=DASHED

BETHEL:	LT	℄	RT
STA B 5+50.00 - STA B 10+03.20	S	-	D
STA B 10+03.20 - STA B 10+82.40	S	-	S
STA B 10+82.40 - STA B 11+50.00	D	-	S

646.602 TEMPORARY 4 INCH WHITE LINE, PAINT
(ALL LINES WILL INCLUDE EDGE LINE BREAKS AND RADIUS FOR TOWN HIGHWAYS)
BETHEL:
STA B 5+50.00 - STA B 11+50.00 LT & RT

646.612 TEMPORARY 4 INCH YELLOW LINE, PAINT
(ALL LINES WILL INCLUDE C/L BREAKS FOR TOWN HIGHWAYS) S=SOLID, D=DASHED

BETHEL:	LT	℄	RT
STA B 5+50.00 - STA B 10+03.20	S	-	D
STA B 10+03.20 - STA B 10+82.40	S	-	S
STA B 10+82.40 - STA B 11+50.00	D	-	S

213.10 MILLED RUMBLE STRIPS
(ALL CLRS WILL INCLUDE C/L BREAKS FOR TOWN HIGHWAYS)
BETHEL:
STA B 5+50.0 - STA B 11+50.0 C/L (600.0 LF)

675.50 REMOVING SIGNS
AS SHOWN - 1

VT STATE PLANE GRID N

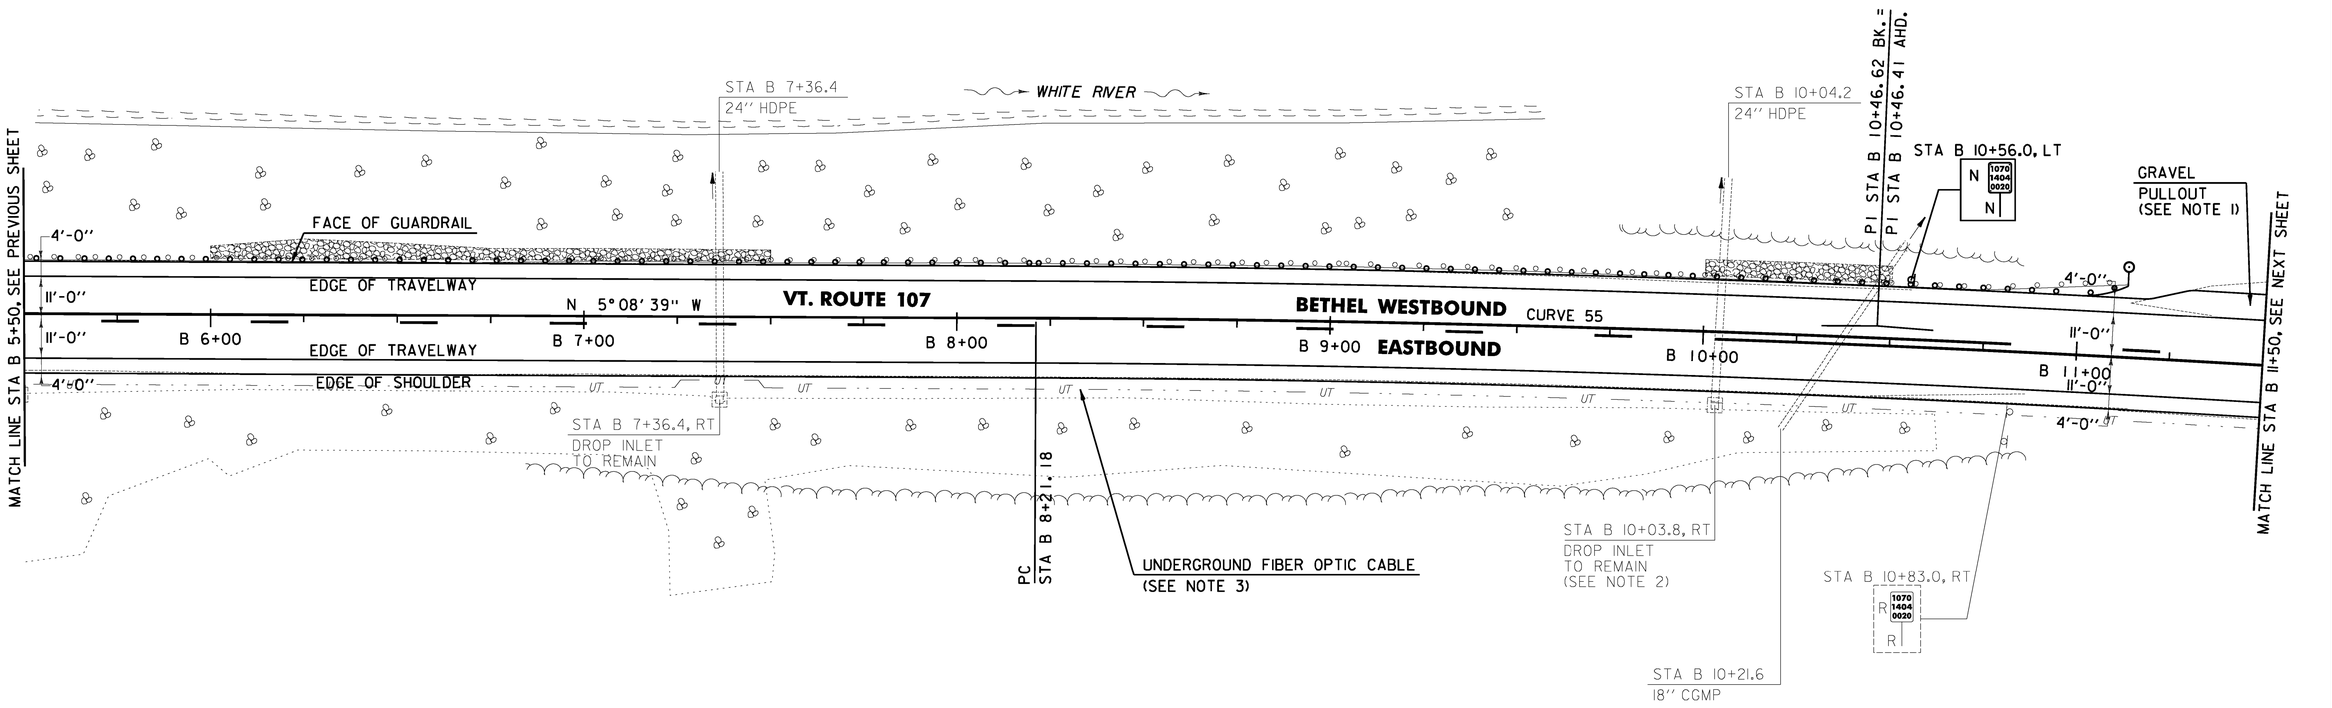

NOTES:

1. PROVIDE A 4 FT WIDE, 1½" TYPE IVS APRON FOR THE EXISTING ASPHALT PULLOUT. ANY REQUIRED EXCAVATION SHALL BE PERFORMED AS DIRECTED BY THE ENGINEER AND PAID FOR UNDER ITEM 608.25 ALL PURPOSE EXCAVATOR RENTAL, TYPE I.
2. THE CONTRACTOR SHALL ADJUST THE PROPOSED SIDE SLOPE TO AVOID FILLING IN THE EXISTING DROP INLET AS DIRECTED BY THE ENGINEER.
3. THE CONTRACTOR SHALL BE AWARE THAT AN UNDERGROUND FIBER OPTIC FACILITY EXISTS ALONG VT 107. THE LOCATION SHOWN ON THE PLANS IS APPROXIMATE, AND THE POTENTIAL EXISTS FOR CONFLICTS WITH THE FIBER OPTIC AND THE PROPOSED UNDERDRAIN AT VARIOUS LOCATIONS THROUGHOUT THE PROJECT. THE CONTRACTOR IS ADVISED THAT, PRIOR TO CONSTRUCTION, ALL PROPOSED UNDERDRAIN LOCATIONS SHALL BE FIELD VERIFIED WITH THE ENGINEER AND RELOCATED AS NECESSARY TO ELIMINATE ANY CONFLICTS WITH THE FIBER OPTIC FACILITY.

0 20 40
SCALE IN FEET

621.20 STEEL BEAM GUARDRAIL
STA B 11+03.0 LT

621.60 ANCHOR FOR STEEL BEAM GUARDRAIL
STA B 11+03.0 LT

~~613.10 STONE FILL, TYPE I~~
~~BETHEL:~~
~~STA B 6+00.0 - STA B 7+50.0 LT (7.9 CY)~~
~~STA B 10+00.0 - STA B 10+50.0 LT (6.4 CY)~~

621.75 REMOVE AND RESET GUARDRAIL
BETHEL: 10+50.0
STA B 5+50.0 - STA B ~~11+13.0~~ LT (563.0 LF)

~~651.40 GRUBBING MATERIAL (6")~~
~~BETHEL:~~
~~STA B 6+00.0 - STA B 7+50.0 LT (20.3 SY)~~
~~STA B 10+00.0 - STA B 10+50.0 LT (14.4 SY)~~

~~653.20 TEMPORARY EROSION MATTING~~
~~BETHEL:~~
~~STA B 5+50.0 - STA B 8+00.0 LT (35.8 SY)~~
~~STA B 10+00.0 - STA B 10+50.0 LT (14.4 SY)~~

676.10 DELINEATOR WITH STEEL POST
BETHEL:
STA B 11+13.0 LT

CURVE 55
△ = 4° 18' 13"
D = 0° 57' 18"
R = 6000.00'
T = 225.44'
L = 450.67'
E = 4.23'
e = 0.020 FT/FT

SIGN LEGEND
R = REMOVE
S = SALVAGE
N = NEW
RET = RETAIN
B-B = BACK TO BACK
EXISTING = ----------
NEW = ——————

PROJECT LAYOUT SHEET #61

PROJECT NAME: STOCKBRIDGE-BETHEL
PROJECT NUMBER: STP 2910(11)
FILE NAME: z10b214_bdr_nul_61.dgn
PROJECT LEADER: D.E.G.
DESIGNED BY: L.M.B.
IPARM FILE: z10b214161.i
PLOT DATE: 3/17/2014
DRAWN BY: W.G.P.
CHECKED BY: J.P.S.
SHEET 94 OF 397

FILE NAME = V:\Projects\ANY\K21\22426\CADD_MSTN\z10b214_bdr_nul_61.dgn
DATE/TIME = 3/17/2014
USER = 4916