TEMPORARY 4 INCH WHITE LINE, PAINT
DURABLE 4 INCH WHITE LINE, POLYUREA
296+50 TO 302+50 SOLID LT & RT

TEMPORARY 4 INCH YELLOW LINE, PAINT
DURABLE 4 INCH YELLOW LINE, POLYUREA
296+50 TO 300+40 SOLID LT & RT
300+40 TO 302+50 SOLID LT, DASHED RT

STEEL BEAM GUARDRAIL, GALVANIZED
300+32.5 TO 300+45 LT
302+16.5 TO 302+29 RT
STEEL BEAM GUARDRAIL,
GALVANIZED W/8 FEET POSTS
296+50 TO 300+32.5 LT
296+50 TO 302+16.5 RT
ANCHOR FOR STEEL BEAM RAIL
1 (SEE STANDARD G-1d)

REMOVAL AND DISPOSAL OF GUARDRAIL
296+50 TO 302+29 RT
296+50 TO 300+46 LT
301+11 TO 302+50 LT

DELINEATOR WITH STEEL POST
300+45 LT

MILLED RUMBLE STRIPS
296+50 TO 302+50 CL

PROJECT DEMARCATION FENCE
299+50 TO 301+70 RT

REMOVING SIGNS
AS SHOWN - 1

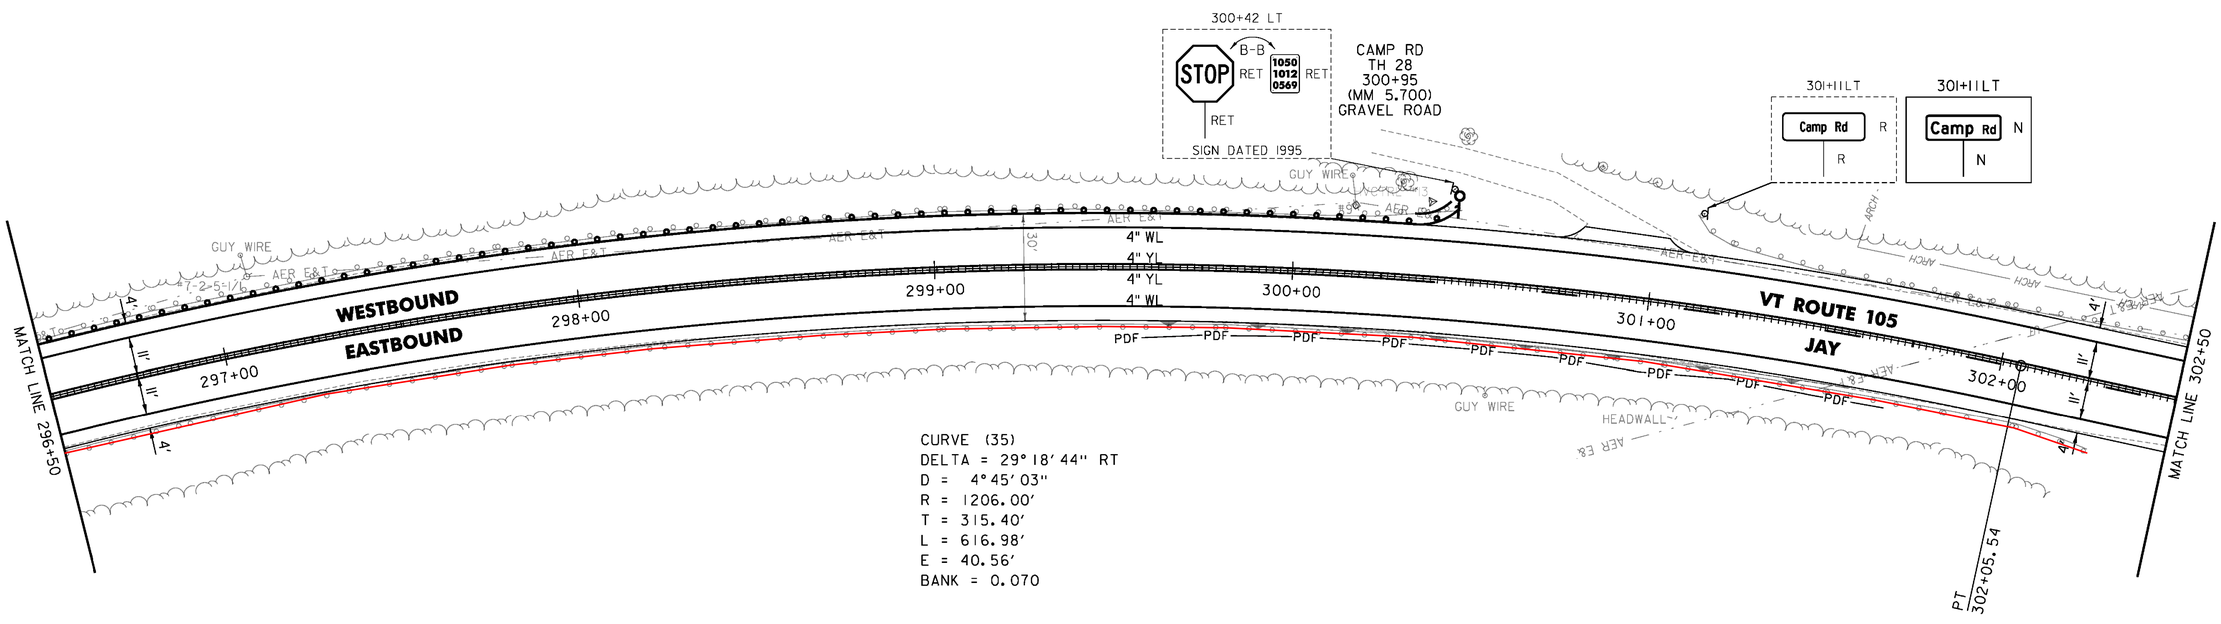

CURVE (35)
DELTA = 29° 18′ 44" RT
D = 4° 45′ 03"
R = 1206.00′
T = 315.40′
L = 616.98′
E = 40.56′
BANK = 0.070

0 20 40
SCALE IN FEET

PROJECT NAME: JAY-TROY	
PROJECT NUMBER: STP 2915(1)	
FILE NAME: z10b232bdr.dgn	PLOT DATE: 5/16/2014
PROJECT LEADER: P. SHEDD	DRAWN BY: W. GORDON
DESIGNED BY: N. LEMAY	CHECKED BY: P. SHEDD
PLAN SHEET 45	SHEET 78 OF 244