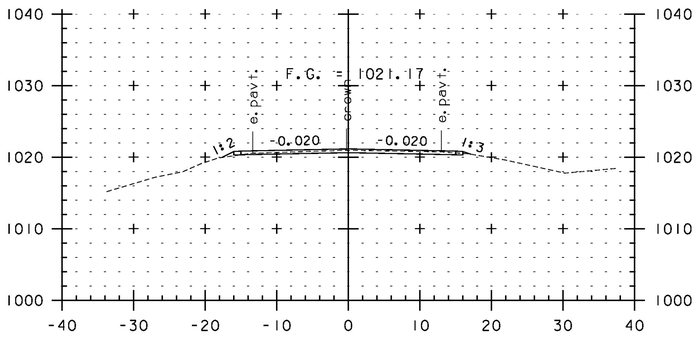

376+50

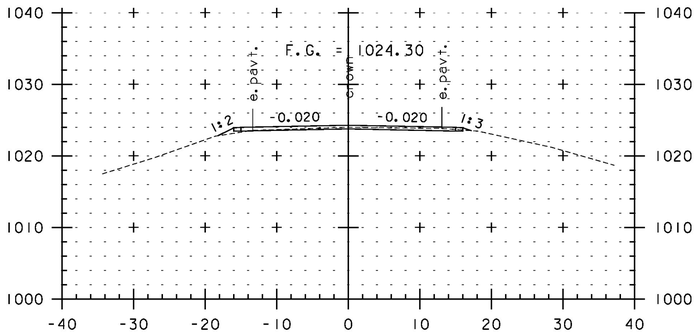

376+00

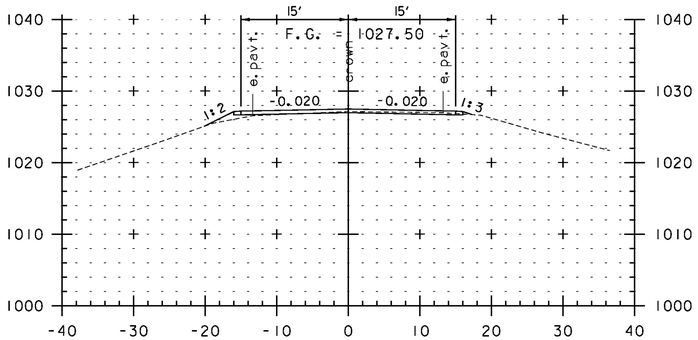

375+50

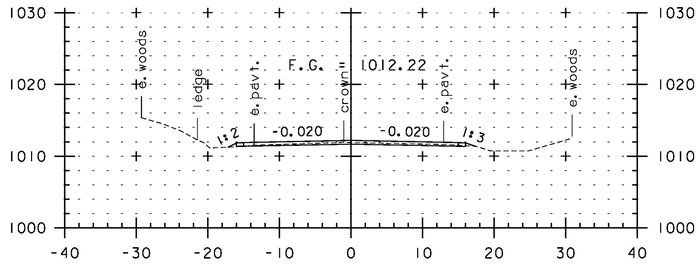

378+00

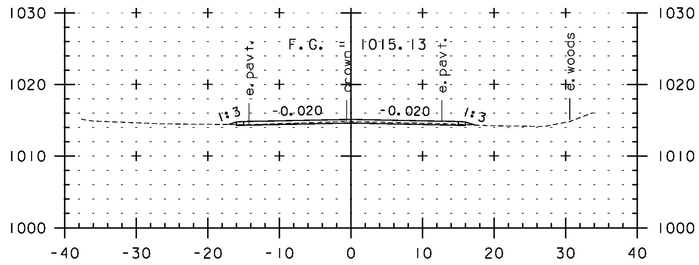

377+50

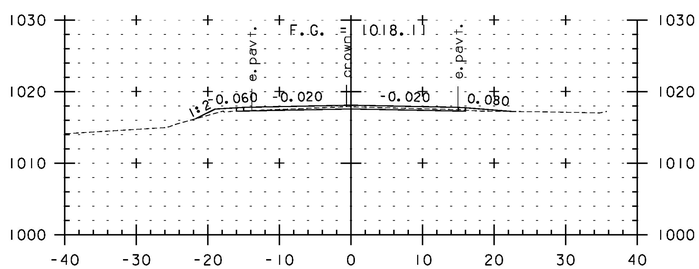

377+00

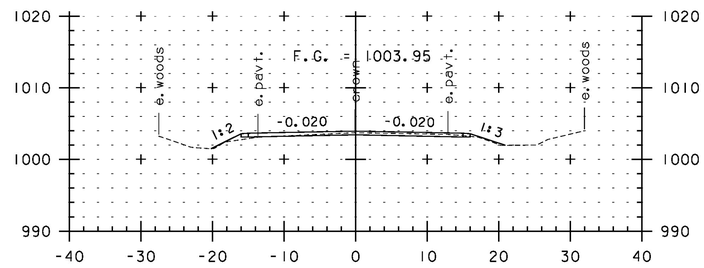

379+50

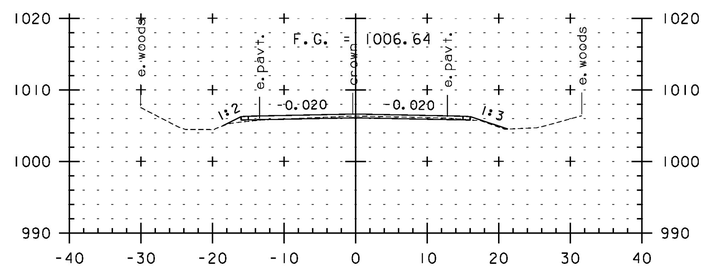

379+00

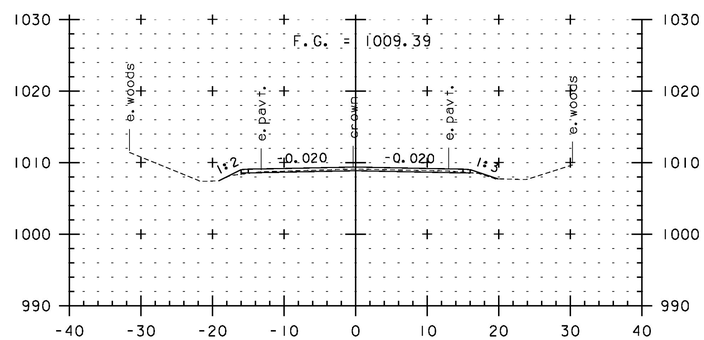

378+50

0 10 20
SCALE IN FEET

STA. 375+50 TO STA. 379+50

PROJECT NAME: JAY-TROY	
PROJECT NUMBER: STP 2315(1)	
FILE NAME: z10b232xs.dgn	PLOT DATE: 5/16/2014
PROJECT LEADER: P. SHEDD	DRAWN BY: W. GORDON
DESIGNED BY: N. LEMAY	CHECKED BY: P. SHEDD
CROSS SECTION SHEET 86	SHEET 222 OF 244