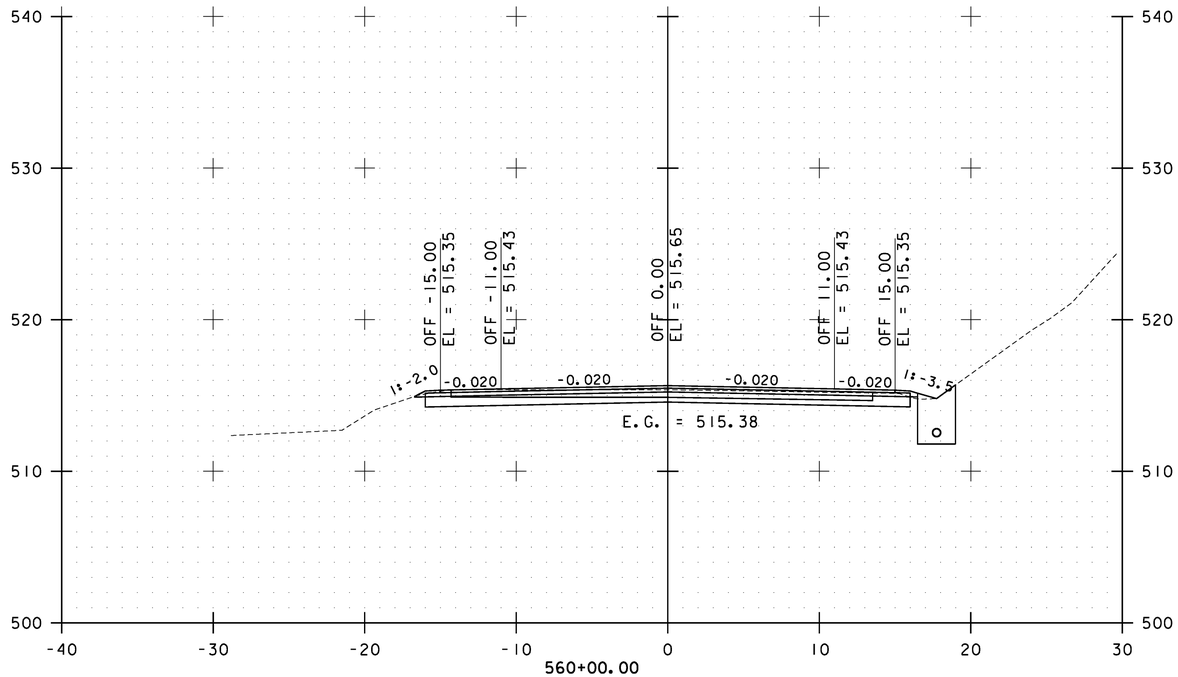

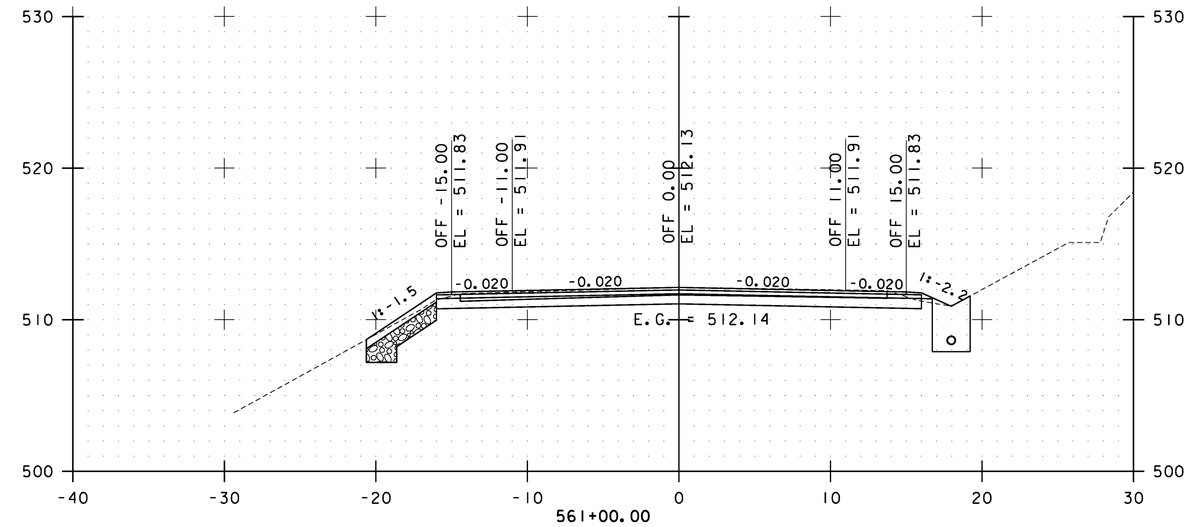

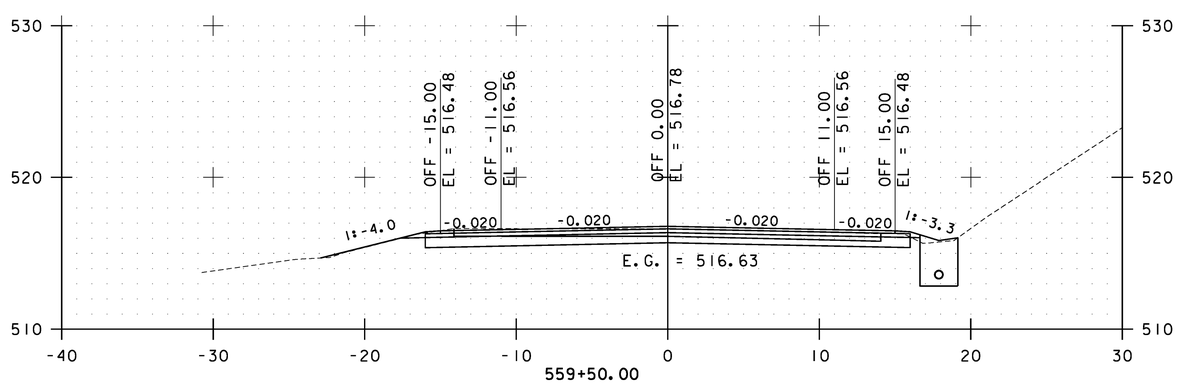

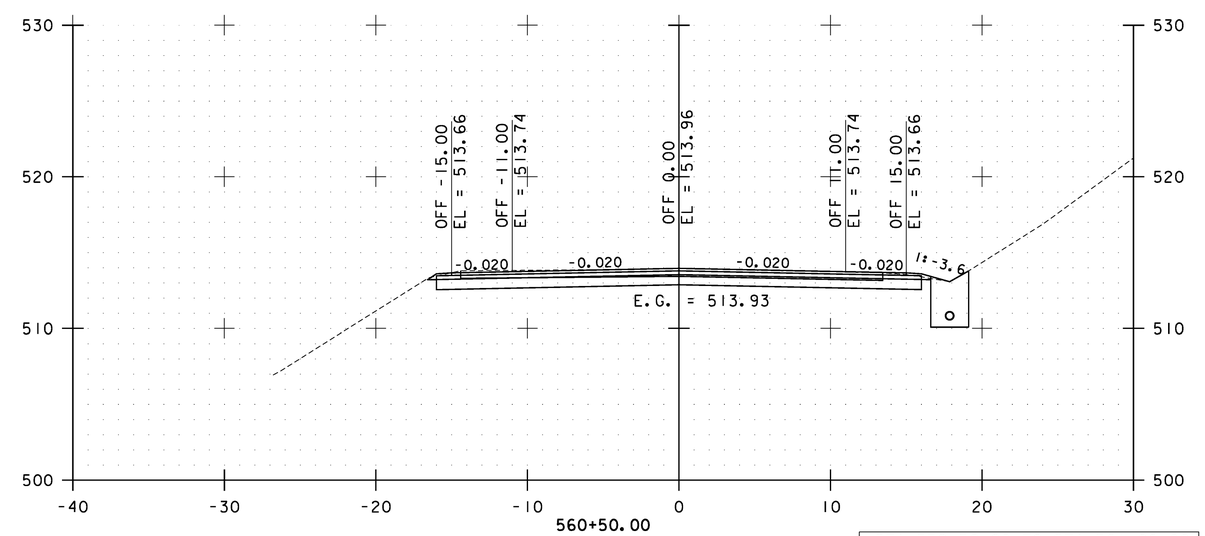

STA. 559+50.00 TO STA. 561+00.00

0 10 20
SCALE

Stantec

CAMBRIDGE CROSS SECTIONS SHEET #28

PROJECT NAME: CAMBRIDGE-BAKERSFIELD
PROJECT NUMBER: STP 2926(I)

FILE NAME: p10b258.dgn
PROJECT LEADER: JLL
DESIGNED BY: STANTEC
IPARM FILE: p10b258xs28.i

PLOT DATE: 11/15/2012
DRAWN BY: STANTEC
CHECKED BY: STANTEC
SHEET 163 OF 387