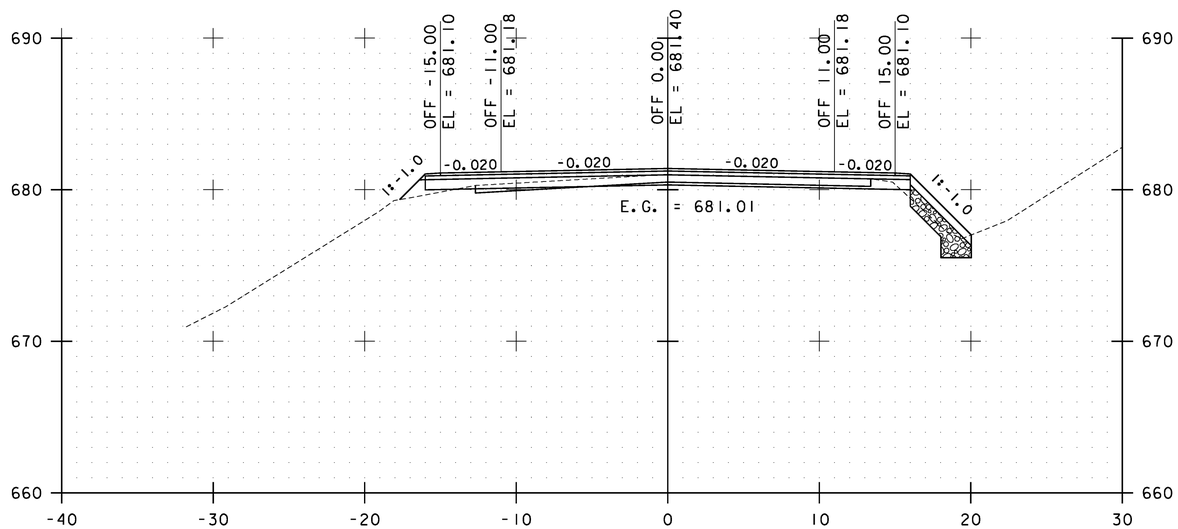

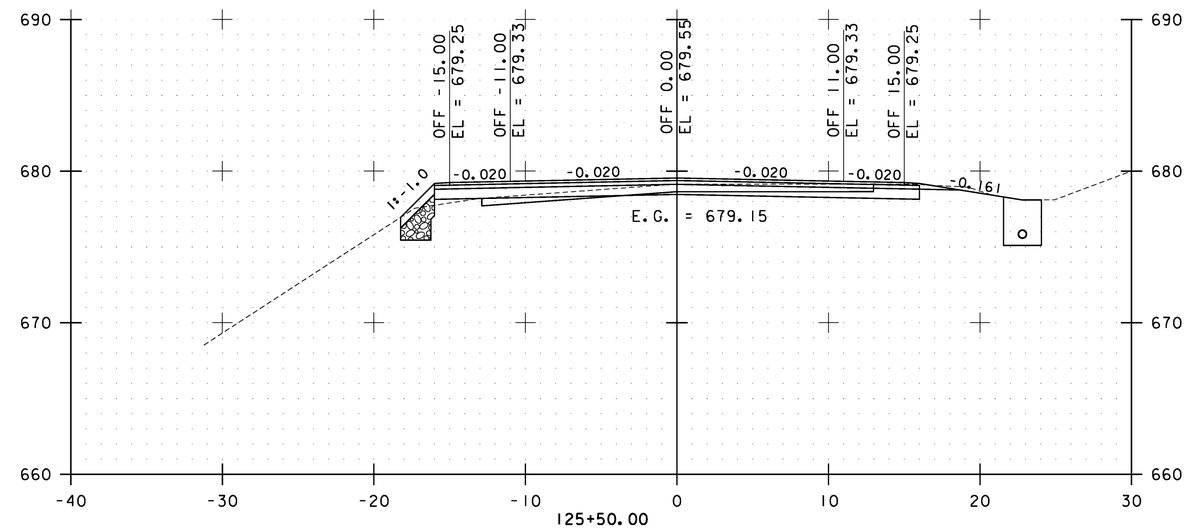

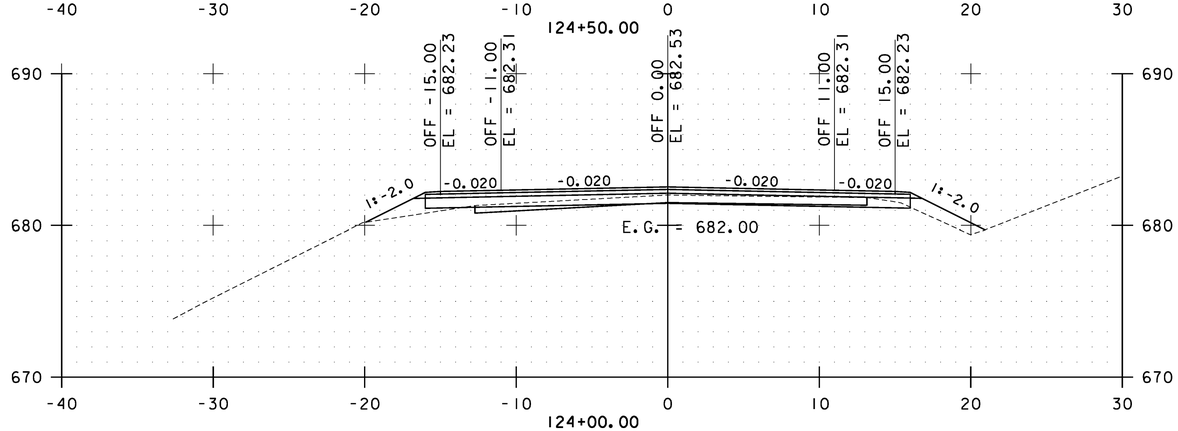

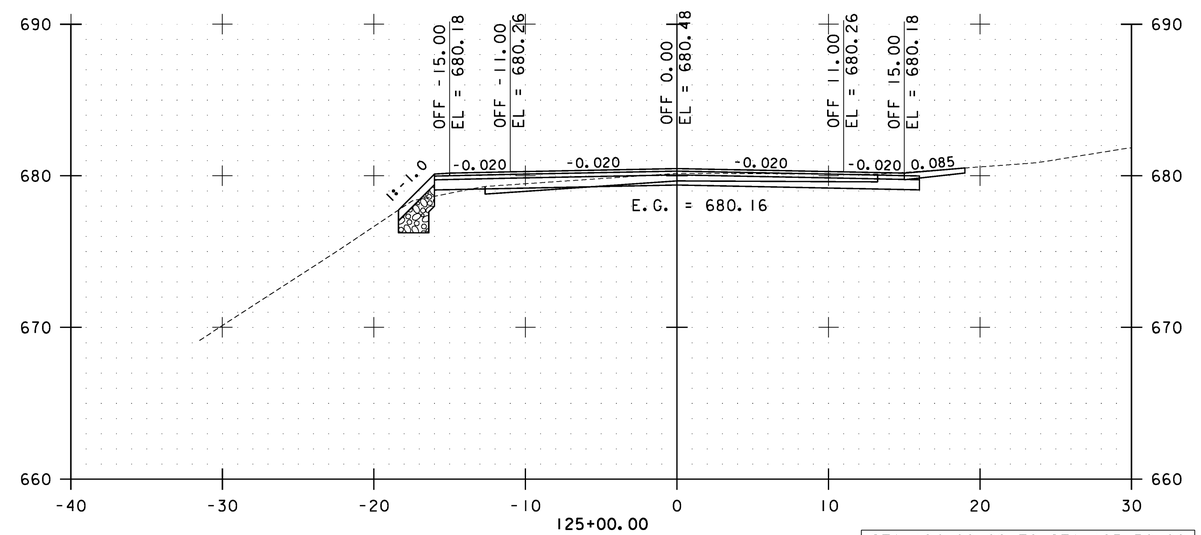

STA. 124+00.00 TO STA. 125+50.00

0 10 20
SCALE

Stantec

BAKERSFIELD CROSS SECTIONS SHEET #52

PROJECT NAME: CAMBRIDGE-BAKERSFIELD
PROJECT NUMBER: STP 2926(I)

FILE NAME: p10b258.dgn
PROJECT LEADER: JLL
DESIGNED BY: STANTEC
IPARM FILE: p10b258xs52.i

PLOT DATE: 11/15/2012
DRAWN BY: STANTEC
CHECKED BY: STANTEC
SHEET 322 OF 387