STATE OF VERMONT
AGENCY OF TRANSPORTATION

TRAFFIC SIGN SUMMARY SHEET 19

MILEMARKER, STATION, OR SIGN NUMBER	SIGN LEGEND	SIGN DIMENSIONS EA	WIDTH (in)	HEIGHT (in)	NEW & SALVAGED SIGNS "A"	"B"	SALV SIGN	SALV TIS	EXIST POST RETAIN	SALVAGE	NEW SIGN POSTS NO. OF POSTS	FLANGED CHANNEL lb/ft 1.12	2.0	3.0	SQUARE STEEL (in) 1.75 lb/ft 1.88	2.0 lb/ft 2.42	2.5 lb/ft 3.35	ANCHOR	SLEEVE	TUBULAR ALUMINUM Ø (in) 3.0 lb/ft 1.3	4.0 lb/ft 1.7	4.0 MOD lb/ft 1.7	TUBULAR STEEL Ø (in) FOUNDATION	3.0 lb/ft 7.6	3.5 lb/ft 9.0	4.0 lb/ft 10.8	5.0 lb/ft 14.6	W-SHAPE STEEL FTG. SIZE 24"	30"	WEIGHT	POST SIZE	SIGN FRAME REQUIRED	REMARKS	SIGN DETAIL DETAIL IN SHSM BOOK	DETAIL ON SHEET NUMBER	STD. SHEET NUMBER
HINESBURG																																					
235+44, RT	SPEED LIMIT 30	1	24	30	5.00						1					X		X																R2-1	X		
236+83, RT	← Charlotte 7	1	72	12	6.00						2					X		X																VD1-1a		114	
238+00, LT	SPEED LIMIT 30	1	24	30	5.00						1					X		X																R2-1	X		
238+62, RT	DO NOT BLOCK DRIVE	1	24	30	5.00						1					X		X																VR-656			E-140
239+47, LT	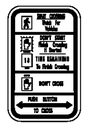	1	9	15	0.94																													R10-3e MOUNT ON SIGNAL POLE USING NEW MOUNTING HARDWARE (INCIDENTAL TO SIGN)	X		
239+48, RT	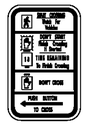	1	9	15	0.94																													R10-3e MOUNT ON SIGNAL POLE USING NEW MOUNTING HARDWARE (INCIDENTAL TO SIGN)	X		
239+62, LT	Charlotte 7 / VT Rte 116 / 1160 0407 0454	1 1 1	42 42 6	12 12 10	3.50 3.50 0.42						1					X		X																D3-1 INSTALL STREET SIGNS 90 DEGREES TO EACH OTHER D3-1 VD-700		114 112	 E-138
239+69, LT	ONLY ONLY	1	36	30	7.50						1					X		X																VR-925			E-145A
TOTALS					SF 37.80	SF	EA.	SF				FT	FT	FT	FT	FT ~~105~~ 88.5	FT		EA	LB	LB	LB	EA.	LB	LB	LB	LB	EA.	EA.	LB						

"SHSM"-STANDARD HIGHWAY SIGNS AND MARKINGS

FINAL POST LENGTHS ARE TO BE DETERMINED IN THE FIELD. POST SIZES ARE COMPUTED BASED ON INFORMATION FURNISHED ON THE STANDARD SHEETS AND THE VTRANS "SIGN POST DESIGN GUIDELINE."

TRAFFIC SIGN SUMMARY SHEET #19

PROJECT NAME: STARKSBORO-HINESBURG
PROJECT NUMBER: STP 2930(I)

FILE NAME: p10b266.dgn
PROJECT LEADER: JLL
DESIGNED BY: STANTEC
IPARM FILE: p10b266tss19.i
PLOT DATE: 28-NOV-2012
DRAWN BY: STANTEC
CHECKED BY: STANTEC
SHEET 102 OF 119