DIRECTION	MILEPOINT	LOCATION CODE (SHEET 2)	SIGN CODE	WIDTH (IN)	HEIGHT (IN)	SHEETING REMARKS	SIGN LEGEND	NEW SIGNS "A"	NEW SIGNS "B"	EXISTING SIGNS RETAIN	EXISTING SIGNS SALVAGE FROM	EXISTING SIGNS SALVAGE TO	EXISTING SIGNS REMOVE	EXIST POST RETAIN	EXIST POST REMOVE	NUMBER OF NEW POSTS	SQUARE STEEL (IN) 1.75 (LB / FT) 1.88	SQUARE STEEL (IN) 2.00 (LB / FT) 2.42	SQUARE STEEL (IN) 2.50 (LB / FT) 3.35	TUBULAR STEEL Ø (IN) FOUNDATION	TUBULAR STEEL Ø (IN) 3.0 (LB / FT) 7.6	TUBULAR STEEL Ø (IN) 3.50 (LB / FT) 9.00	TUBULAR STEEL Ø (IN) 4.00 (LB / FT) 10.80	TUBULAR STEEL Ø (IN) 5.00 (LB / FT) 14.60	SIGN FRAME REQUIRED	REMARKS	SIGN DETAIL LOCATION SHSM	SIGN DETAIL LOCATION PROJECT SHEET #	SIGN DETAIL LOCATION STANDARD SHEET #
WOODFORD WB							FY-FLUORESCENT YELLOW FYG-FLUORESCENT YELLOW GREEN																			"SHSM"-STANDARD HIGHWAY SIGNS AND MARKINGS			
WB	2.500	F	W1-2L	30	30		CURVE LEFT						1		X													
		F	W13-1	18	18		45 MPH ADVISORY						1															
WB	2.438	F	W1-2L	30	30	FY		6.25								1		X									INSTALL 325 FEET WEST OF EXISTING LEFT CURVE WARNING SIGN ASSEMBLY.	X		
WB	2.395	F	W1-8L	18	24		CHEVRON						1		X													
WB	2.377	F	W1-8L	18	24		CHEVRON																					
		F	W1-6L	48	24	FY	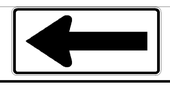	8.00								2		X										X		
WB	2.355	F	W1-8L	18	24		CHEVRON						1		X													
WB	2.278	F	M3-4	24	12								1		X													
		F	M1-5	24	24								1															
		F	M3-4	24	12			2.00								1		X										E-136B	
		F	M1-5	24	24			4.00																				E-136B	
		F	VM-120	18	24		MOLLY STARK BYWAY				1	1	1														REINSTALL ON THE NEW POST BELOW ROUTE MARKER.			
WB	2.165	F	VW-619	30	30								1		X													
		F	VW-619	30	30			6.25								1		X										8	
WB	1.640	F	R2-5A	24	30		REDUCED SPEED AHEAD						1		X													
							SHEET TOTALS	26.50	0.00	0	1	1	~~9~~ 10	0	0	5		75		0	0.0	0.0	0.0	0.0				
								SF	SF	EA	EA	EA	EA	EA	EA	EA		FT		EA	LB	LB	LB	LB				
							TOWN DIRECTIONAL TOTALS	260.8	0.0	9.0	4.0	4.0	60	0.0	0.0	48		720.0		0		0.0						

SIGN SUMMARY SHEET

VERMONT AGENCY OF TRANSPORTATION

PROJECT NAME: **WOODFORD-MARLBORO**
PROJECT NUMBER: **STPG SIGN(35)**

FILE NAME: **10B336**
PROJECT MANAGER: **A. GAMBLE**
DESIGNED BY: **J. KELLY**
WOODFORD WB SHEET 6

PLOT DATE: **4/10/2012**
DRAWN BY: **J. KELLY**
CHECKED BY: **A. GAMBLE**
SHEET **26** OF **80**