DIRECTION	MILEPOINT	LOCATION CODE (SHEET 2)	SIGN CODE	WIDTH (IN)	HEIGHT (IN)	SHEETING REMARKS	SIGN LEGEND	NEW SIGNS "A"	NEW SIGNS "B"	EXISTING SIGNS RETAIN	EXISTING SIGNS SALVAGE FROM	EXISTING SIGNS SALVAGE TO	EXISTING SIGNS REMOVE	EXIST POST RETAIN	EXIST POST REMOVE	NUMBER OF NEW POSTS	SQUARE STEEL (IN) 1.75 (LB / FT) 1.88	SQUARE STEEL (IN) 2.00 (LB / FT) 2.42	SQUARE STEEL (IN) 2.50 (LB / FT) 3.35	TUBULAR STEEL Ø (IN) FOUNDATION	TUBULAR STEEL Ø (IN) 3.0 (LB / FT) 7.6	TUBULAR STEEL Ø (IN) 3.50 (LB / FT) 9.00	TUBULAR STEEL Ø (IN) 4.00 (LB / FT) 10.80	TUBULAR STEEL Ø (IN) 5.00 (LB / FT) 14.60	SIGN FRAME REQUIRED	REMARKS	SIGN DETAIL LOCATION SHSM	SIGN DETAIL LOCATION PROJECT SHEET #	SIGN DETAIL LOCATION STANDARD SHEET #
MARLBORO EB							FY-FLUORESCENT YELLOW FYG-FLUORESCENT YELLOW GREEN																			"SHSM"-STANDARD HIGHWAY SIGNS AND MARKINGS			
EB	1.338	A	VW-092	36	36		UNSAFE TO PASS			1				X														
EB	1.653	A	W1-2R	36	36					~~1~~			I	X							RETAIN POST						RETAIN POST	
		A	W13-1	24	24					~~1~~			I															
		A	W1-2R	36	36			9.00																			X		
		A	W13-1	24	24			4.00																			X		
EB	1.765	A	W1-10R	30	30		RIGHT CURVE / CROSSROAD						1		X														
		A	S3-1	30	30		SCHOOL BUS STOP AHEAD						1																
		A	S3-1	36	36	FYG		9.00								2		X									X	TRIM BRUSH	
EB	1.803	A	W2-1	30	30		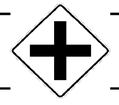	6.25								1		X									INSTALL 200 FEET EAST OF NEW SCHOOL BUS STOP SIGN.	X		
EB	1.877	C	VR-017	24	30								1	X							RETAIN POST						BUTTERFIELD RD (TH-5)		RETAIN POST	
		C	VR-017	24	30			5.00																				7	
		C	R2-1	24	30		SPEED LIMIT 35 (TOWN OWNED)			1																	REINSTALL BELOW NEW LEGAL LOAD SIGN.			
EB	1.886	D	R1-1	30	30								1	X							RETAIN POST						BUTTERFIELD RD (TH-5)		RETAIN POST	
		D	R1-1	30	30			6.25																			X		
EB	1.926	A	M3-2	24	12								1	X							RETAIN POST								RETAIN POST	
SIGN SUMMARY SHEET							SHEET TOTALS	39.50	0.00	4	0	0	~~7~~ 5	0	0	3		45		0	0.0	0.0	0.0	0.0				
								SF	SF	EA	EA	EA	EA	EA	EA	EA		FT		EA	LB	LB	LB	LB				
VERMONT AGENCY OF TRANSPORTATION							TOWN DIRECTIONAL TOTALS	634.4	0.0	28.0	1.0	1.0	127	0.0	0.0	88		1320.0		0		0.0						

PROJECT NAME: **WOODFORD-MARLBORO**
PROJECT NUMBER: **STPG SIGN(35)**

FILE NAME: **10B336**
PROJECT MANAGER: **A. GAMBLE**
DESIGNED BY: **J. KELLY**
MARLBORO EB SHEET 4

PLOT DATE: **4/10/2012**
DRAWN BY: **J. KELLY**
CHECKED BY: **A. GAMBLE**
SHEET **49** OF **80**