DIRECTION	MILEPOINT	LOCATION CODE (SHEET 2)	SIGN CODE	WIDTH (IN)	HEIGHT (IN)	SHEETING REMARKS	SIGN LEGEND	NEW SIGNS "A"	NEW SIGNS "B"	EXISTING SIGNS RETAIN	EXISTING SIGNS SALVAGE FROM	EXISTING SIGNS SALVAGE TO	EXISTING SIGNS REMOVE	EXIST POST RETAIN	EXIST POST REMOVE	NUMBER OF NEW POSTS	SQUARE STEEL (IN) 1.75 (LB / FT) 1.88	SQUARE STEEL (IN) 2.00 (LB / FT) 2.42	SQUARE STEEL (IN) 2.50 (LB / FT) 3.35	TUBULAR STEEL Ø (IN) FOUNDATION	TUBULAR STEEL Ø (IN) 3.0 (LB / FT) 7.6	TUBULAR STEEL Ø (IN) 3.50 (LB / FT) 9.00	TUBULAR STEEL Ø (IN) 4.00 (LB / FT) 10.80	TUBULAR STEEL Ø (IN) 5.00 (LB / FT) 14.60	SIGN FRAME REQUIRED	REMARKS	SIGN DETAIL LOCATION SHSM	SIGN DETAIL LOCATION PROJECT SHEET #	SIGN DETAIL LOCATION STANDARD SHEET #
MARLBORO WB							FY-FLUORESCENT YELLOW FYG-FLUORESCENT YELLOW GREEN																			"SHSM"-STANDARD HIGHWAY SIGNS AND MARKINGS			
WB	8.104	F	W1-2L	30	30		LEFT CURVE						1		X														
		F	W13-1P	18	18		35 MPH ADVISORY						1																
WB	8.047	F	W1-2L	30	30	FY		6.25								1		X								INSTALL 300 FEET WEST OF EXISTING LEFT CURVE SIGN ASSEMBLY.	X		
		F	W13-1P	18	18	FY		2.25																			X		
WB	8.005	F	W1-6L	48	24								1		X														
		F	W1-6L	48	24	FY		8.00								2		X									X		
WB	8.004	E	W1-6R	48	24								1		X														
WB	8.003	E	W1-6R	48	24	FY		8.00								2		X								MAINTAIN 10 FEET CLEAR SPACE BETWEEN SIGNS.	X		
WB	7.971	F	W1-6L	48	24								1		X														
		F	W1-6L	48	24	FY	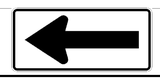	8.00								2		X									X		
WB	7.970	E	W1-6R	48	24								1		X														
WB	7.969	E	W1-6R	48	24	FY		8.00								2		X								MAINTAIN 10 FEET CLEAR SPACE BETWEEN SIGNS.	X		
WB	7.945	F	VW-538RM	48	48		MODIFIED RIGHT ACUTE CURVE						1		X														
		F	W13-1	24	24		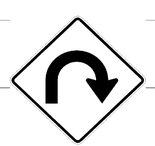						1																	
		F	W1-11R	36	36	FY		9.00								2			X								SEE SHEET 2.	X		
SIGN SUMMARY SHEET							SHEET TOTALS	49.50	0.00	0	0	0	8	0	0	11		165		0	0.0	0.0	0.0	0.0				
								SF	SF	EA	EA	EA	EA	EA	EA	EA		FT		EA	LB	LB	LB	LB				
VERMONT AGENCY OF TRANSPORTATION							TOWN DIRECTIONAL TOTALS	607.1	0.0	23.0	1.0	1.0	117	0.0	0.0	70		1050.0		0			0.0					

PROJECT NAME: **WOODFORD-MARLBORO**
PROJECT NUMBER: **STPG SIGN(35)**

FILE NAME: **10B336**
PROJECT MANAGER: **A. GAMBLE**
DESIGNED BY: **J. KELLY**
MARLBORO WB SHEET 1

PLOT DATE: **4/10/2012**
DRAWN BY: **J. KELLY**
CHECKED BY: **A. GAMBLE**
SHEET **64** OF **80**