SPLICE BAR - FIXED

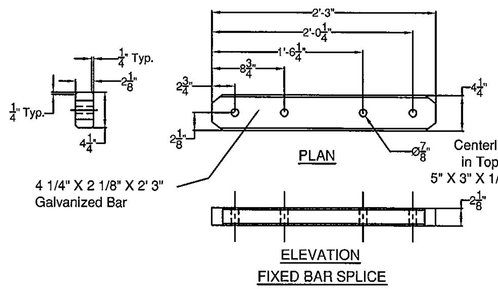

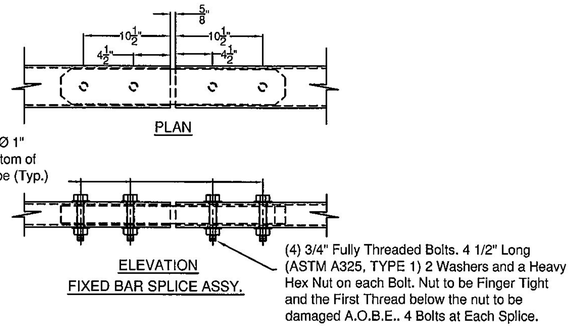

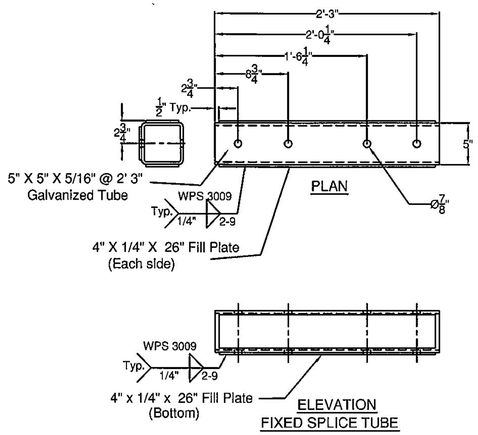

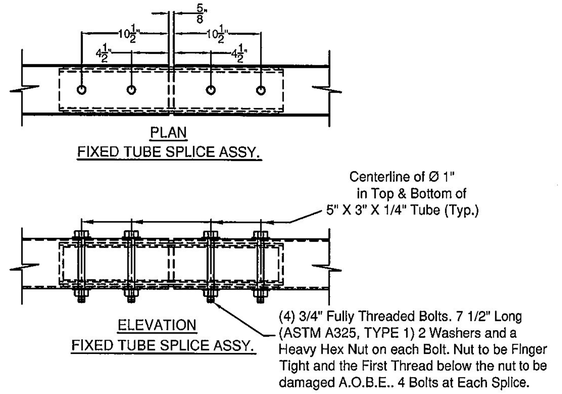

SPLICE TUBE - FIXED

Vermont Agency of Transportation

RECEIVED

ON: April 28, 2014

and Checked for

CONFORMANCE

BY: Rob Young DATE: 05/16/2014

__X__ Approved _____ Approved As Noted

_____ Rejected

This review is only for general conformance with the design concept and the information given in the Construction Documents. Corrections or comments made on the shop drawings during the review do not relieve the Contractor from compliance with the requirements of the Plans and Specifications. Review of a specific item shall not include review of an assembly of which an item is a component. The Contractor is responsible for dimensions to be confirmed and corrected at the job site; information that pertains solely to the fabrication process or to the means, methods, techniques, sequences and procedures of construction; coordination of the Work with that of other trades and performing all Work in a safe and satisfactory manner.

McFarland Johnson

Date 5/16/2014

By D. Kull

BRIDGE POST DETAIL

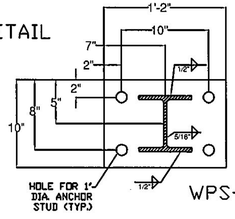

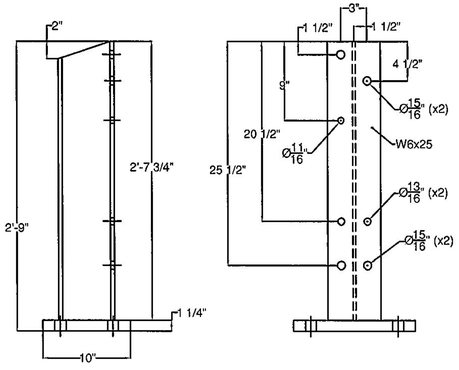

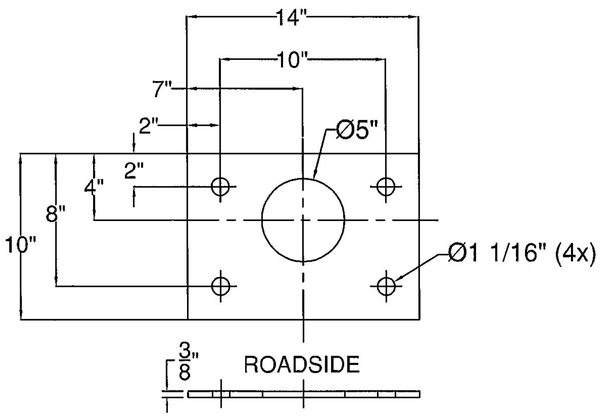

ANCHOR PLATE

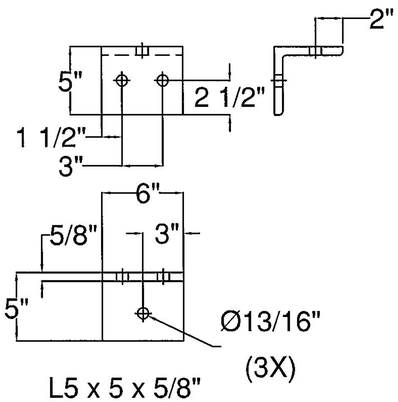

L5 x 5 x 5/8"
RAILING ANGLE

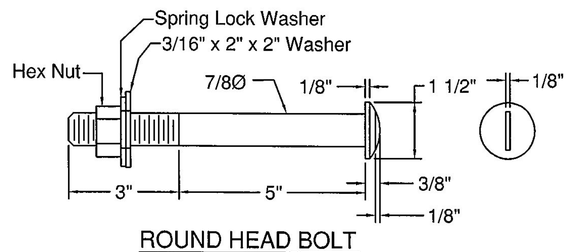

ROUND HEAD BOLT

ITEM #: 525.335

APPROVED BY:

SHEET 2 OF 2

BRIDGE RAIL DETAILS SHEET

WARREN BRF 013-4 (32), VT ROUTE 100 (MINOR ARTERIAL) BRIDGE # 166

TOWN OF WARREN, COUNTY OF WASHINGTON, VT.

REV	NO.	DATE	DESCRIPTION	BY

REV	NO.	DATE	DESCRIPTION	BY

ELDERLEE, INC.
OAKS CORNERS, NEW YORK 14518
E-Mail: dlong@elderlee.com
Tel:315-789-6670 Fax:315-789-6615

CERTIFIED FABRICATOR

DRAWN	E.P.	4/24/14
CHECKED	D.L.	4/24/14
APPROVED	.	.
SCALE	SCHEMATIC	
DRAWING NO.	F.R. LaFAYETTE-WARREN	