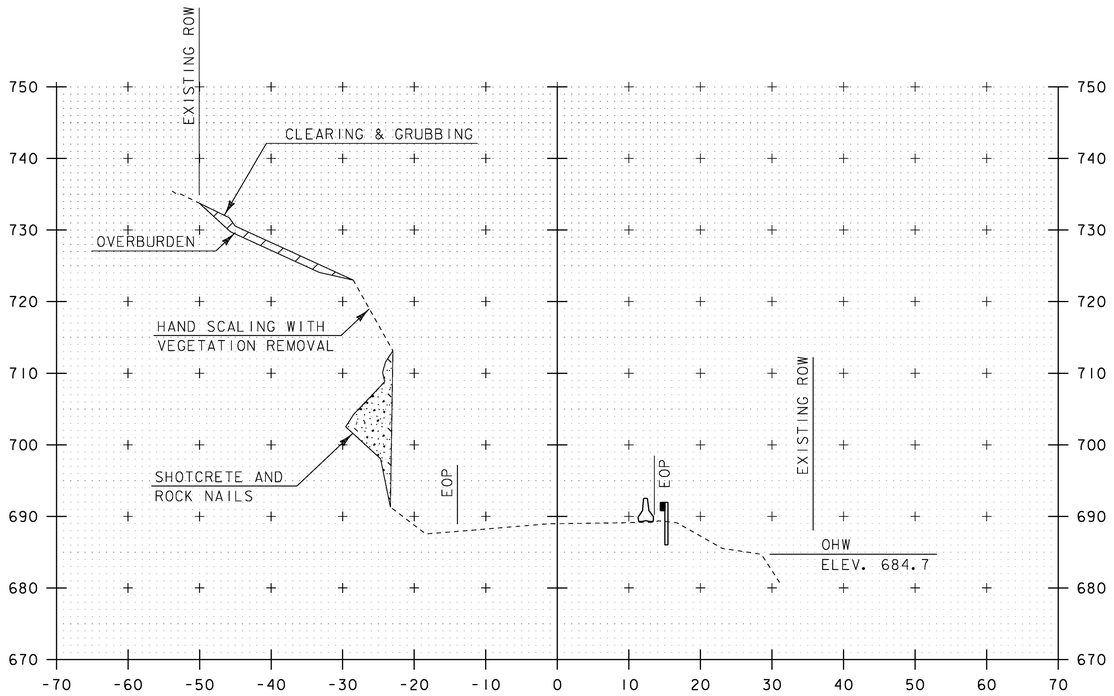

176+25

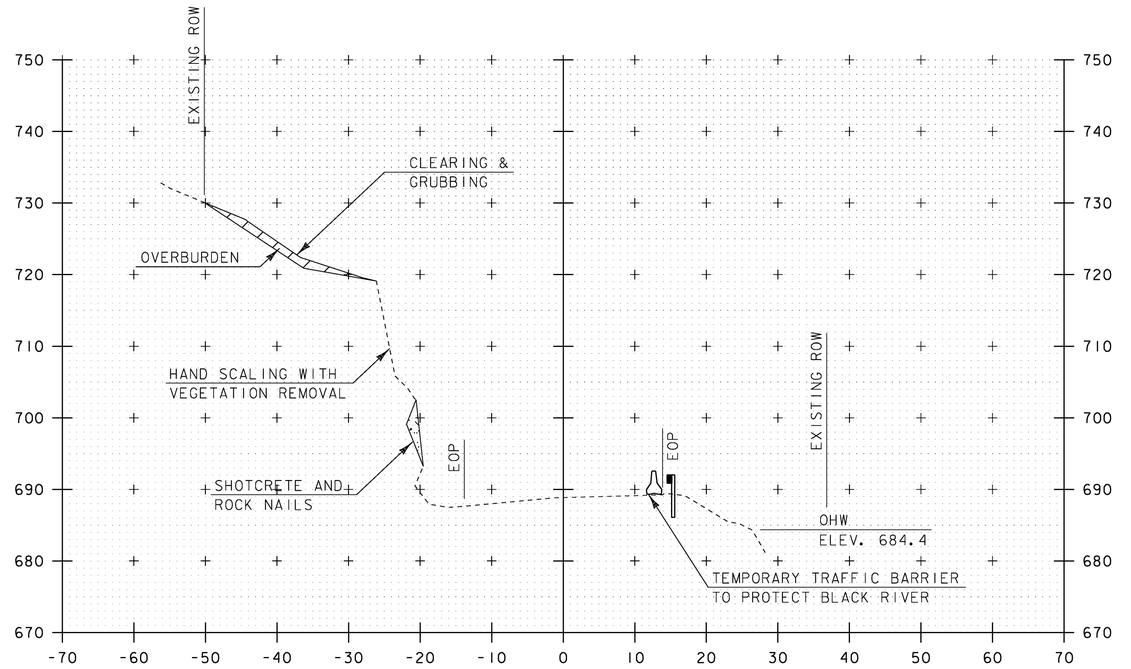

176+50

STA. 176+25 TO STA. 176+50

PROJECT NAME: COVENTRY
PROJECT NUMBER: STP 0113(66)

FILE NAME: d10cl14xsc.dgn
PROJECT LEADER: K. UPMAL
DESIGNED BY: S. ZWICK
CROSS SECTION SHEET 4

PLOT DATE: 15-FEB-2017
DRAWN BY: S. ZWICK
CHECKED BY: C. LEACH
SHEET 20 OF 29