DURABLE 4 INCH WHITE LINE (SEE OPTION ITEMS)
STA. 22+25 - STA. 27+50 (SOLID LT & RT)

DURABLE 4 INCH YELLOW LINE (SEE OPTION ITEMS)
STA. 22+25 - STA. 27+50 (SOLID LT & RT)

TEMPORARY 4 INCH WHITE LINE, PAINT
STA. 22+25 - STA. 27+50 (SOLID LT & RT)

TEMPORARY 4 INCH YELLOW LINE, PAINT
STA. 22+25 - STA. 27+50 (SOLID LT & RT)

6 INCH UNDERDRAIN PIPE
STA. ~~26+00~~ 24+26 - STA. ~~27+50~~ 27+46 RT

REMOVING SIGNS
AS SHOWN - 3

STONE FILL, TYPE I
STA. 23+67 - STA. 24+26 RT
STA. 23+75 - STA. 25+25 LT

GRUBBING MATERIAL
STA. 23+67 - STA. 24+26 RT
STA. 23+75 - STA. 25+25 LT

GEOTEXTILE UNDER STONE FILL
STA. 23+67 - STA. 24+26 RT
STA. 23+75 - STA. 25+25 LT

GEOTEXTILE FOR SILT FENCE
STA. 23+67 - STA. 24+26 RT
STA. 23+75 - STA. 25+25 LT

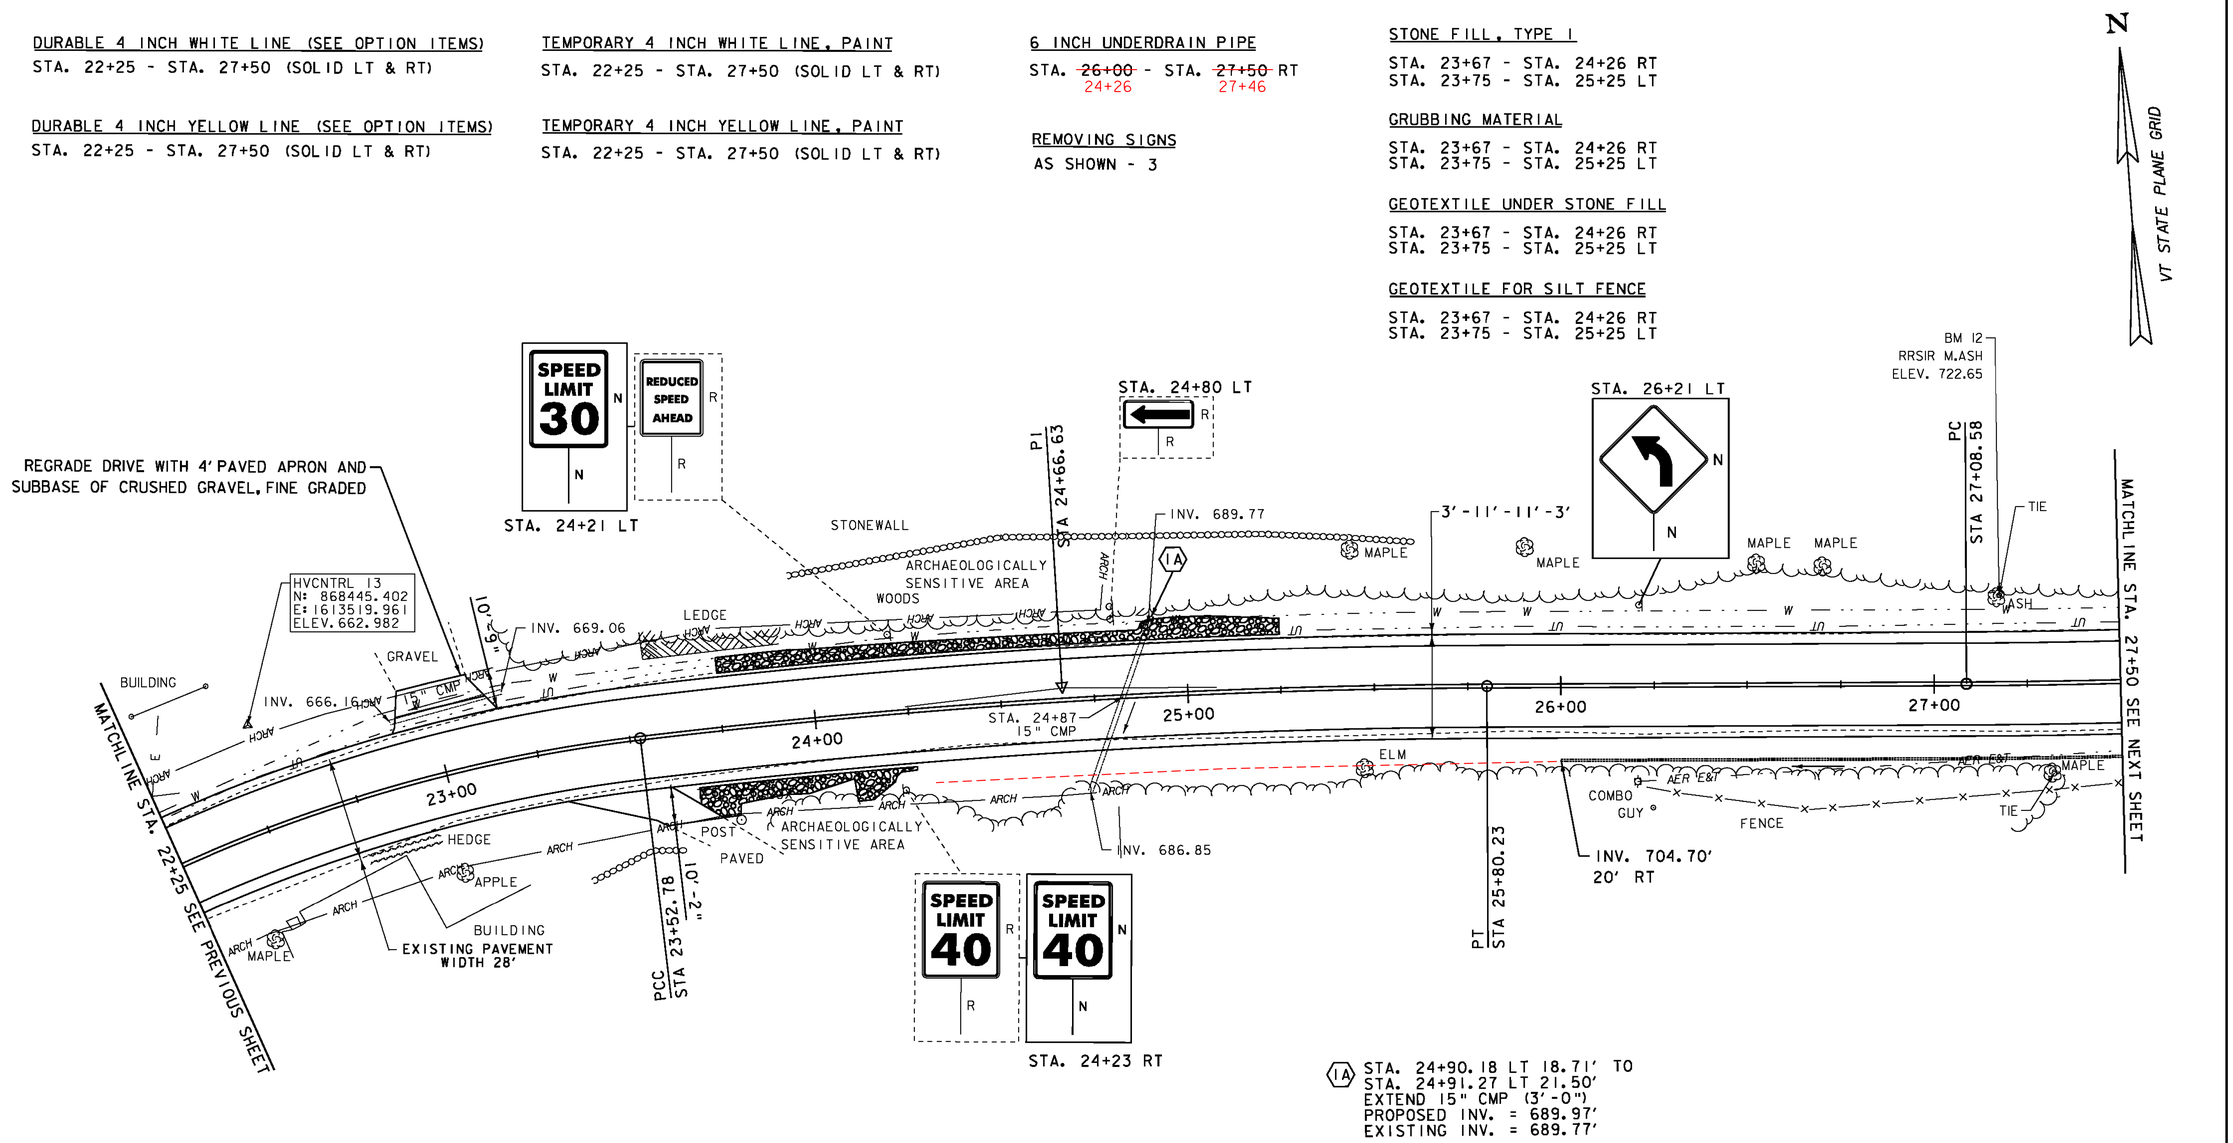

LEGEND
- MAILBOX
- BORING
- SIGN
- HYDRANT
- MANHOLE
- WATER SHUT OFF (WSO)
- GAS PIPELINE MARKER
- CATCH BASIN / DROP INLET
- CURB INLET
- TRAFFIC CONTROL BOX
- PARKING METER
- UTILITY POLE

SIGN LEGEND
R = REMOVE
R&S = REMOVE AND SALVAGE
RET = RETAIN
S = SALVAGED
N = NEW
B-B = BACK TO BACK
---- = EXISTING
—— = NEW

DATUM
NAVD 88
NAD 83

SCALE IN FEET
20 0 20

SEH
2-20-14

PROJECT LAYOUT SHEET 5

PROJECT NAME: MONTGOMERY-WESTFIELD
PROJECT NUMBER: STP 2906(1)

FILE NAME: p10C190.dgn
PROJECT LEADER: CDL
DESIGNED BY: SJL
PLOT FILE: p10C190_26.1

PLOT DATE: 9/5/12
DRAWN BY: SJL
CHECKED BY: EPD
SHEET 26 OF 178