STATE OF VERMONT
AGENCY OF TRANSPORTATION

TRAFFIC SIGN SUMMARY SHEET 3

MILEMARKER, STATION, OR SIGN NUMBER	SIGN LEGEND	SIGN DIMENSIONS			NEW & SALVAGED SIGNS				EXIST POST		NEW SIGN POSTS																				SIGN FRAME REQUIRED	REMARKS	SIGN DETAIL		
												FLANGED CHANNEL			SQUARE STEEL (in.)					TUBULAR ALUMINUM dia. (in.)				TUBULAR STEEL dia. (in.)				W-SHAPE STEEL FTG. SIZE									
		EA	WIDTH (in.)	HEIGHT (in.)	"A"	"B"	SALV SIGN	SALV TIS	RETAIN	SALVAGE	NO. OF POSTS	lb/ft			1.75	2.0	2.5	ANCHOR	SLEEVE	3.0	4.0	4.0 MOD.	FOUNDATION	3.0	3.5	4.0	5.0	24"	30"	WEIGHT	POST SIZE			"SHSM" STANDARD HIGHWAY SIGNS AND MARKINGS	DETAIL ON SHEET NUMBER	STD. SHEET NUMBER
												1.12	2.0	3.0	lb/ft 1.88	2.42	3.35			lb/ft 1.3	1.7	1.7		lb/ft 7.6	9.0	10.8	14.6								
SUDBURY											OPTION ITEMS																							
~~54+13, R.T.~~ 53+00, R.T.		2	18	24	6.00						2					~~13.0~~ 13.0		X															W1-8L	X		
~~54+13, L.T.~~ 53+00, L.T.		1	30	30	6.25						1					~~13.0~~ 13.0		X															W1-1R	X		
		1	18	18	2.25																												W13-1P	X		
~~54+96, R.T.~~ 53+84, L.T.		1	6	10	0.42						1				~~9.0~~ 5			X															VD-700			E-138
~~55+78, L.T.~~ 54+65, L.T.		1	30	30	6.25						1					~~14.0~~ 9.5		X															VW-054		94	
~~57+73, L.T.~~ 57+35, L.T.	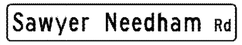	1	72	12	6.00						2					13.0 ~~16~~ 13.0		X															D3-1 DOUBLE-SIDED		93	
~~57+76, L.T.~~ 56+80, L.T.		1	30	30	6.25						1					~~15.0~~ 9.5		X															R1-1	X		
		1	6	10	0.42																												VD-700			E-138
~~58+30, L.T.~~ 57+30, L.T.		1	24	30	5.00						1					~~12.0~~ 11		X															VR-017		94	
~~61+35, R.T.~~ 60+18, R.T.		1	24	30	5.00						1					~~15.0~~ 9.5		X															R2-1	X		
~~65+04, R.T.~~ 64+01, R.T.		1	6	10	0.42						1				~~10.0~~ 5			X															VD-700			E-138

TOTALS	SF	~~SF~~ SF OF TYPE A INSTALL	EA	SF	FT	FT	FT	FT	FT	FT	EA	LB	LB	LB	LB	LB	LB	LB	EA	EA	LB
					0	0	0	10	83.5	0		0	0	0		0	0	0	0			
SHEET 1	78.8				0				135.5			0				0						
SHEET 2	37.9				0				92.5			0				0						
SHEET 3	~~44.3~~	44.26			0				~~93.5~~	140.0		0				0						
SHEET 4	64.6				0				76.5			0				0						
SHEET 5	56.6				0				138			0				0						
SHEET 6	54.1				0				106			0				0						
SHEET 7	29.6				0				81			0				0						
SHEET 8	39.3				0				67			0				0						
SHEET 9	18.3				0				34.5			0				0						
PROJECT TOTAL	423.3				0				824.5			0				0						

FINAL POST LENGTHS ARE TO BE DETERMINED IN THE FIELD. POST SIZES ARE COMPUTED BASED ON INFORMATION FURNISHED ON THE STANDARD SHEETS AND VTRANS "SIGN POST DESIGN GUIDELINE."

PROJECT NAME: SUDBURY-BRANDON
PROJECT NUMBER: STP 0158(3)

FILE NAME: dl0c204_frm.dgn
PROJECT LEADER: K. UPMAL
DESIGNED BY: B. MCADAMS
TRAFFIC SIGN SUMMARY SHEET 3

PLOT DATE: 13-FEB-2013
DRAWN BY: C. LEACH
CHECKED BY: B. MCADAMS
SHEET 85 OF 137