INDEX OF SHEETS
SEE SHEET 2

STATE OF VERMONT
AGENCY OF TRANSPORTATION

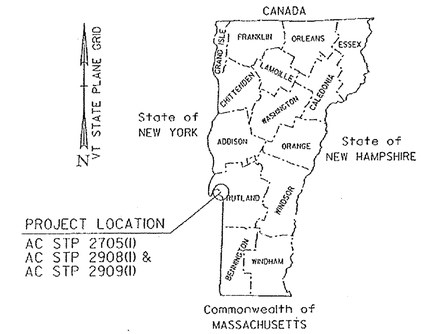

PROPOSED IMPROVEMENT
TOWNS OF CASTLETON, IRA, & WEST RUTLAND
COUNTY OF RUTLAND
VT. ROUTE 4A & VT. ROUTE 30

CASTLETON-WEST RUTLAND
AC STP 2705(1)
SEE SHEET 12
FOR ADDITIONAL PROJECT INFORMATION
AND THE SUPERPAVE DESIGN CRITERIA

CASTLETON CLASS I
AC STP 2908(1)
SEE SHEET 90
FOR ADDITIONAL PROJECT INFORMATION
AND THE SUPERPAVE DESIGN CRITERIA

CASTLETON
AC STP 2909(1)
SEE SHEET 120
FOR ADDITIONAL PROJECT INFORMATION
AND THE SUPERPAVE DESIGN CRITERIA

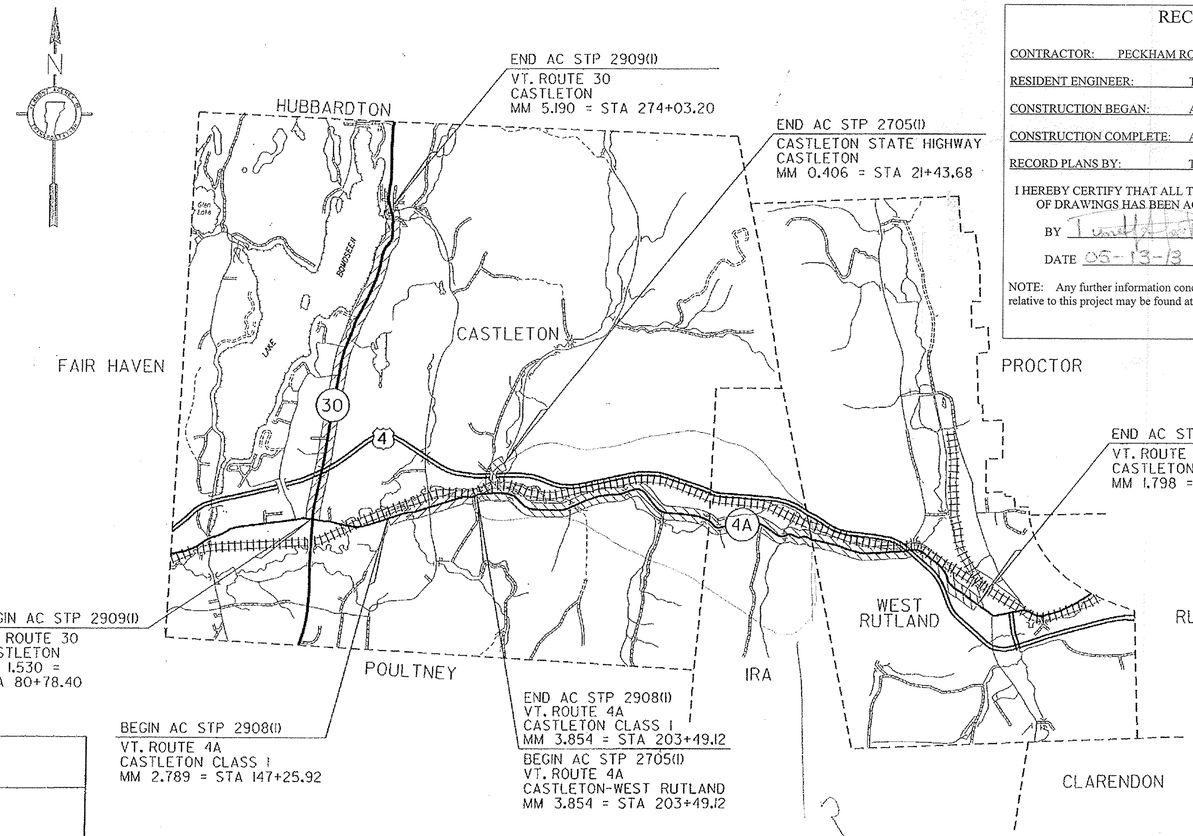

RECORD PLANS

CONTRACTOR: PECKHAM ROAD CORPORATION. -WHITE PLAINS, NY
RESIDENT ENGINEER: TIM POCKETTE
CONSTRUCTION BEGAN: APRIL 30, 2012
CONSTRUCTION COMPLETE: AUGUST 17, 2012
RECORD PLANS BY: TIM POCKETTE & STEPHEN KENT

I HEREBY CERTIFY THAT ALL THE CONSTUCTION REQUIRED BY THIS SET OF DRAWINGS HAS BEEN ACCOMPLISHED AS INDICATED HEREIN.

BY [signature] RESIDENT ENGINEER

DATE 05-13-13

NOTE: Any further information concerning final quantities, amounts or other details relative to this project may be found at Central Files in the electronic archives.

STATE OF VERMONT
RODNEY A. BASSO
No. 6581
CIVIL
LICENSED PROFESSIONAL ENGINEER

PLANS PREPARED BY

[signature]

CHA

QUALITY ASSURANCE PROGRAM: LEVEL 3

CONVENTIONAL SYMBOLS

COUNTY LINE
TOWN LINE
LIMITS OF ACCESS
POINT OF ACCESS
FENCE LINE
STONE WALL
TRAVELED WAY
GUARD RAIL
RAILROAD
SURVEY LINE
CULVERT
POWER POLE
TELEPHONE POLE
TREES
CONTROL OF ACCESS
PROPERTY LINE
R.O.W. TAKING LINE
SLOPE RIGHTS
TOP OF CUT
TOE OF SLOPE

SURVEYED BY : NA
SURVEYED DATE : NA

DATUM
VERTICAL NA
HORIZONTAL NA

DEPARTMENT OF TRANSPORTATION
FEDERAL HIGHWAY ADMINISTRATOR
APPROVED [signature] 9-22-11

DIRECTOR OF PROGRAM DEVELOPMENT
APPROVED [signature] DATE 9/19/11

PROJECT MANAGER : MIKE FOWLER

PROJECT NAME : CASTLETON-WEST RUTLAND & CASTLETON

PROJECT NUMBER : AC STP 2705 (1) , AC STP 2908 (1) & AC STP 2909 (1)

SHEET 1 OF 152 SHEETS

FILE NAME = N:\Projects\ANY\K22234\CADD_MSTN\07C188 Contract Plans.dgn
DATE/TIME = 9/16/2011
USER = 1459