STATE OF VERMONT
AGENCY OF TRANSPORTATION

TRAFFIC SIGN SUMMARY SHEET 7

MILEMARKER, STATION, OR SIGN NUMBER	SIGN LEGEND	SIGN DIMENSIONS EA	WIDTH (in)	HEIGHT (in)	NEW & SALVAGED SIGNS "A"	"B"	SALV SIGN	SALV TIS	EXIST POST RETAIN	EXIST POST SALVAGE	NEW SIGN POSTS NO. OF POSTS	FLANGED CHANNEL lb/ft 1.12	2.0	3.0	SQUARE STEEL (in) lb/ft 1.75 1.88	2.0 2.42	2.5 3.35	ANCHOR	SLEEVE	TUBULAR ALUMINUM Ø (in) lb/ft 3.0 1.3	4.0 1.7	4.0 MOD 1.7	FOUNDATION	TUBULAR STEEL Ø (in) lb/ft 3.0 7.6	3.5 9.0	4.0 10.8	5.0 14.6	W-SHAPE STEEL FTG. SIZE 24"	30"	WEIGHT	POST SIZE	SIGN FRAME REQUIRED	REMARKS SHS = FHWA STANDARD HIGHWAY SIGNS BOOK	SIGN DETAIL DETAIL IN SHS	DETAIL ON DWG. NUMBER	STD. SHEET NUMBER
CASTLETON: 286+30.0, RT		1	30	30	6.25						1					~~X~~ 14' 0"		X															SIGN ID CODE WI-2R	X		
291+50.0, LT		1	30	30	6.25						1					~~X~~ 14' 0"		X															SIGN ID CODE WI-2L	X		
295+50.0, LT		1	6	10	0.42																												SIGN ID CODE VD-700 NEW SIGN TO BE MOUNTED ON EXISTING SIGN POST.			E-138
302+33.0, RT		1	6	8	0.33						1					~~X~~ 6' 9"		X															SIGN ID CODE VD-701			E-134
302+91.0, LT		1	6	8	0.33						1					~~X~~ 8' 3"		X															SIGN ID CODE VD-701			E-134
306+24.0, RT		1	6	10	0.42						1					~~X~~ 8' 0"		X															SIGN ID CODE VD-700			E-138
307+75.0, RT		1	30	30	6.25						1					~~X~~ 16' 3"		X															SIGN ID CODE WI-2R	X		
		1	18	18	2.25																												SIGN ID CODE WI3-1P	X		
311+57.0, LT	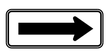	1	48	24	8.00						2					12' 9" ~~X~~ 13' 0"		X															SIGN ID CODE WI-6R	X		
											LF	LF	LF	LF	LF	LF	LF		EA.	LB	LB	LB		LB	LB	LB	LB									
														~~42~~	~~70~~																						
														23.0																						
TOTALS		SF 30.50	SF	EA.	SF						LF			LF ~~112~~ 93.0					LB			EA.	LB				EA.	EA.	LB						

FINAL POST LENGTHS ARE TO BE DETERMINED IN THE FIELD. POST SIZES ARE COMPUTED BASED ON INFORMATION FURNISHED ON THE STANDARD SHEETS AND THE VTRANS "SIGN POST DESIGN GUIDELINE."

TRAFFIC SIGN SUMMARY SHEET #7

PROJECT NAME: CASTLETON - WEST RUTLAND
PROJECT NUMBER: STP 2705(I)

FILE NAME: p07c168.dgn
PROJECT LEADER: D.E.G.
DESIGNED BY: M.J.M.
IPARM FILE: p07c168tss7.i
PLOT DATE: 04-JUN-2013 09:5
DRAWN BY: W.G.P.
CHECKED BY: D.E.G.
SHEET 63 OF 152