646.402 DURABLE 4 INCH WHITE LINE, THERMOPLASTIC OR
646.403 DURABLE 4 INCH WHITE LINE, EPOXY PAINT OR
646.404 DURABLE 4 INCH WHITE LINE, POLYUREA
(ALL LINES WILL INCLUDE EDGE LINE BREAKS AND RADIUS FOR TOWN HIGHWAYS)
CASTLETON:
STA 92+50.00 - STA 98+50.00 EDGE LINE LT & RT

646.412 DURABLE 4 INCH YELLOW LINE, THERMOPLASTIC OR
646.413 DURABLE 4 INCH YELLOW LINE, EPOXY PAINT OR
646.414 DURABLE 4 INCH YELLOW LINE, POLYUREA
(ALL LINES WILL INCLUDE C/L BREAKS FOR TOWN HIGHWAYS) S=SOLID, D=DASHED
CASTLETON:

	LT	℄	RT
STA 92+50.00 - STA 98+50.00	S	-	S

646.602 TEMPORARY 4 INCH WHITE LINE, PAINT
(ALL LINES WILL INCLUDE EDGE LINE BREAKS AND RADIUS FOR TOWN HIGHWAYS)
CASTLETON:
STA 92+50.00 - STA 98+50.00 EDGE LINE LT & RT

646.612 TEMPORARY 4 INCH YELLOW LINE, PAINT
(ALL LINES WILL INCLUDE C/L BREAKS FOR TOWN HIGHWAYS) S=SOLID, D=DASHED
CASTLETON:

	LT	℄	RT
STA 92+50.00 - STA 98+50.00	S	-	S

646.442 DURABLE 8 INCH WHITE LINE, THERMOPLASTIC OR
646.443 DURABLE 8 INCH WHITE LINE, EPOXY PAINT OR
646.444 DURABLE 8 INCH WHITE LINE, POLYUREA
CASTLETON:
STA 93+53.0 - STA 93+65.0 FIRE HYDRANT NO PARKING ZONE RT

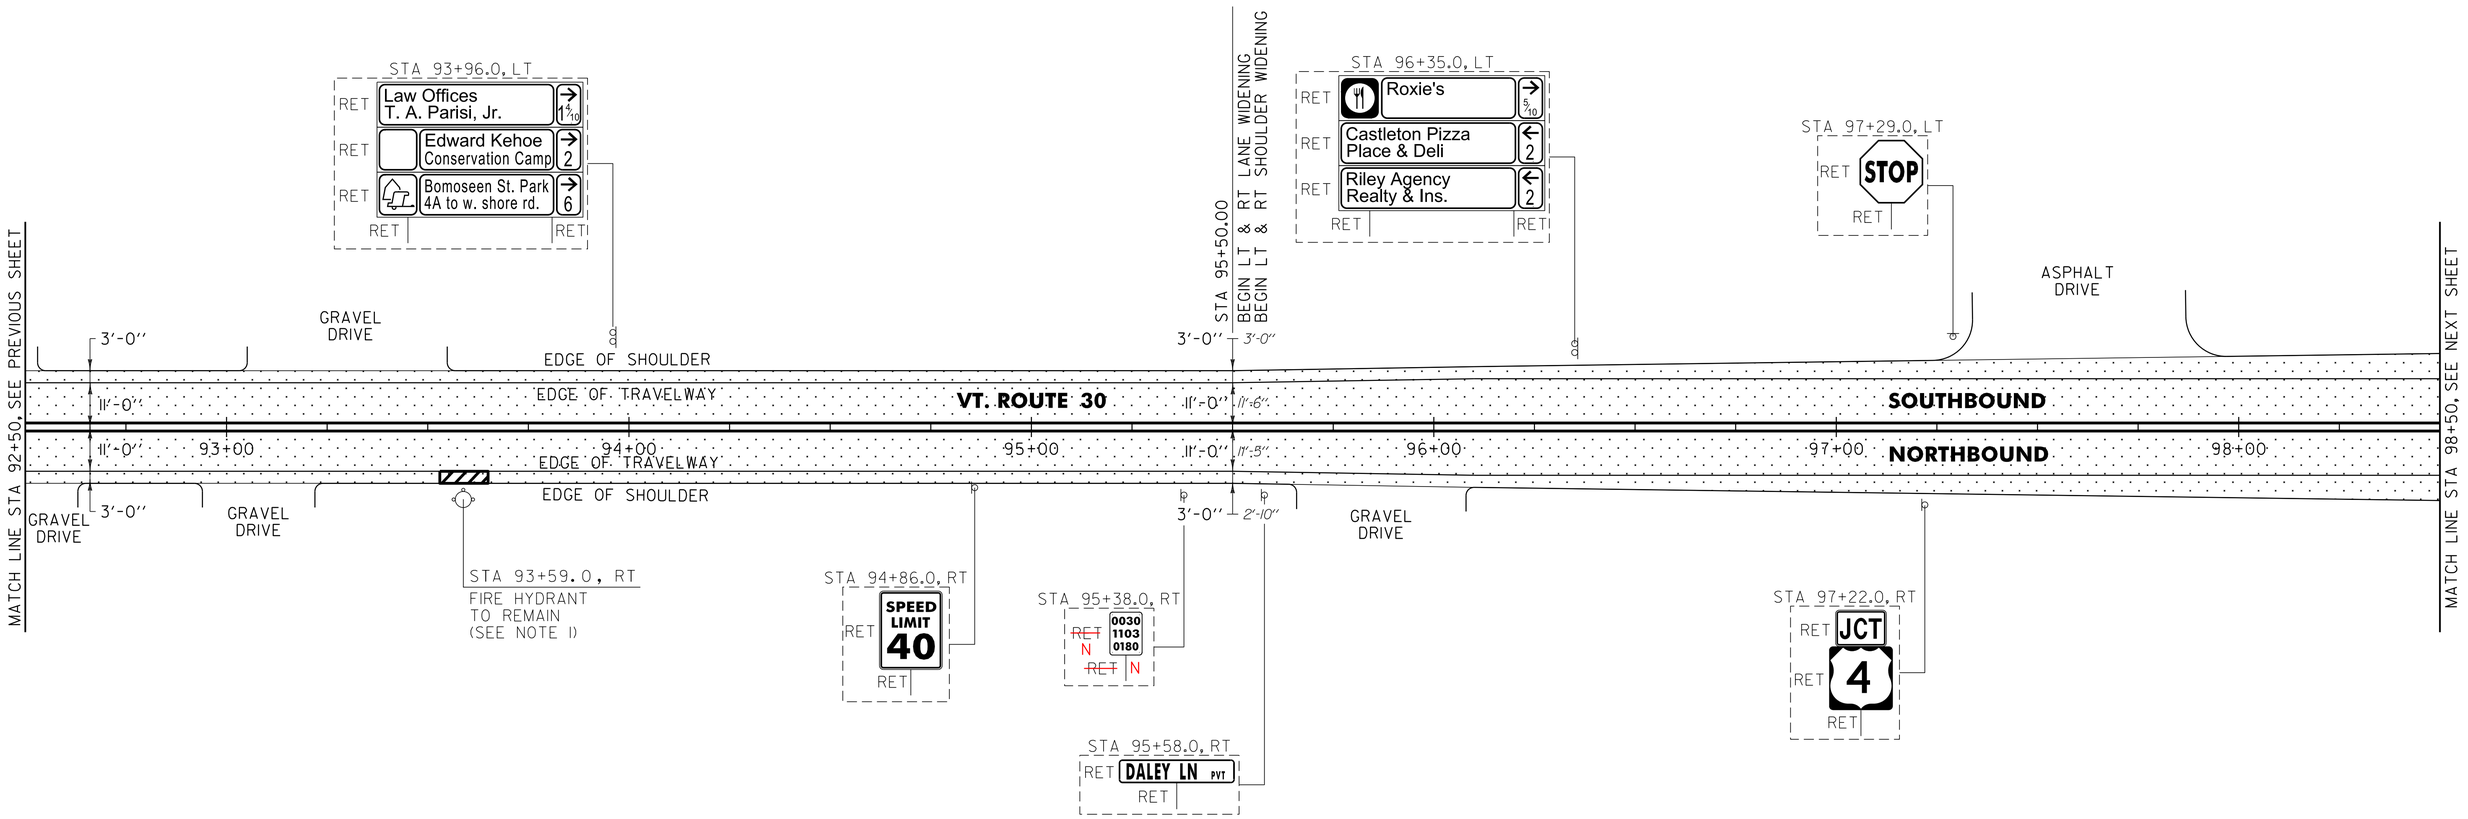

NOTE:

1. SEE SHEET 8 FOR FIRE HYDRANT PAVEMENT MARKING DETAIL.

AREA TO BE COLD PLANED

SIGN LEGEND

R = REMOVE
S = SALVAGE
N = NEW
RET = RETAIN
B-B = BACK TO BACK
EXISTING = - - - - - -
NEW = ————

NOT TO SCALE

PROJECT LAYOUT SHEET #3

PROJECT NAME: CASTLETON
PROJECT NUMBER: STP 2909(1)

FILE NAME: pl0c212.dgn
PROJECT LEADER: D.E.G.
DESIGNED BY: M.J.M.
IPARM FILE: pl0c212103.i
PLOT DATE: 04-JUN-2013 09:1
DRAWN BY: W.G.P.
CHECKED BY: D.E.G.
SHEET 131 OF 152