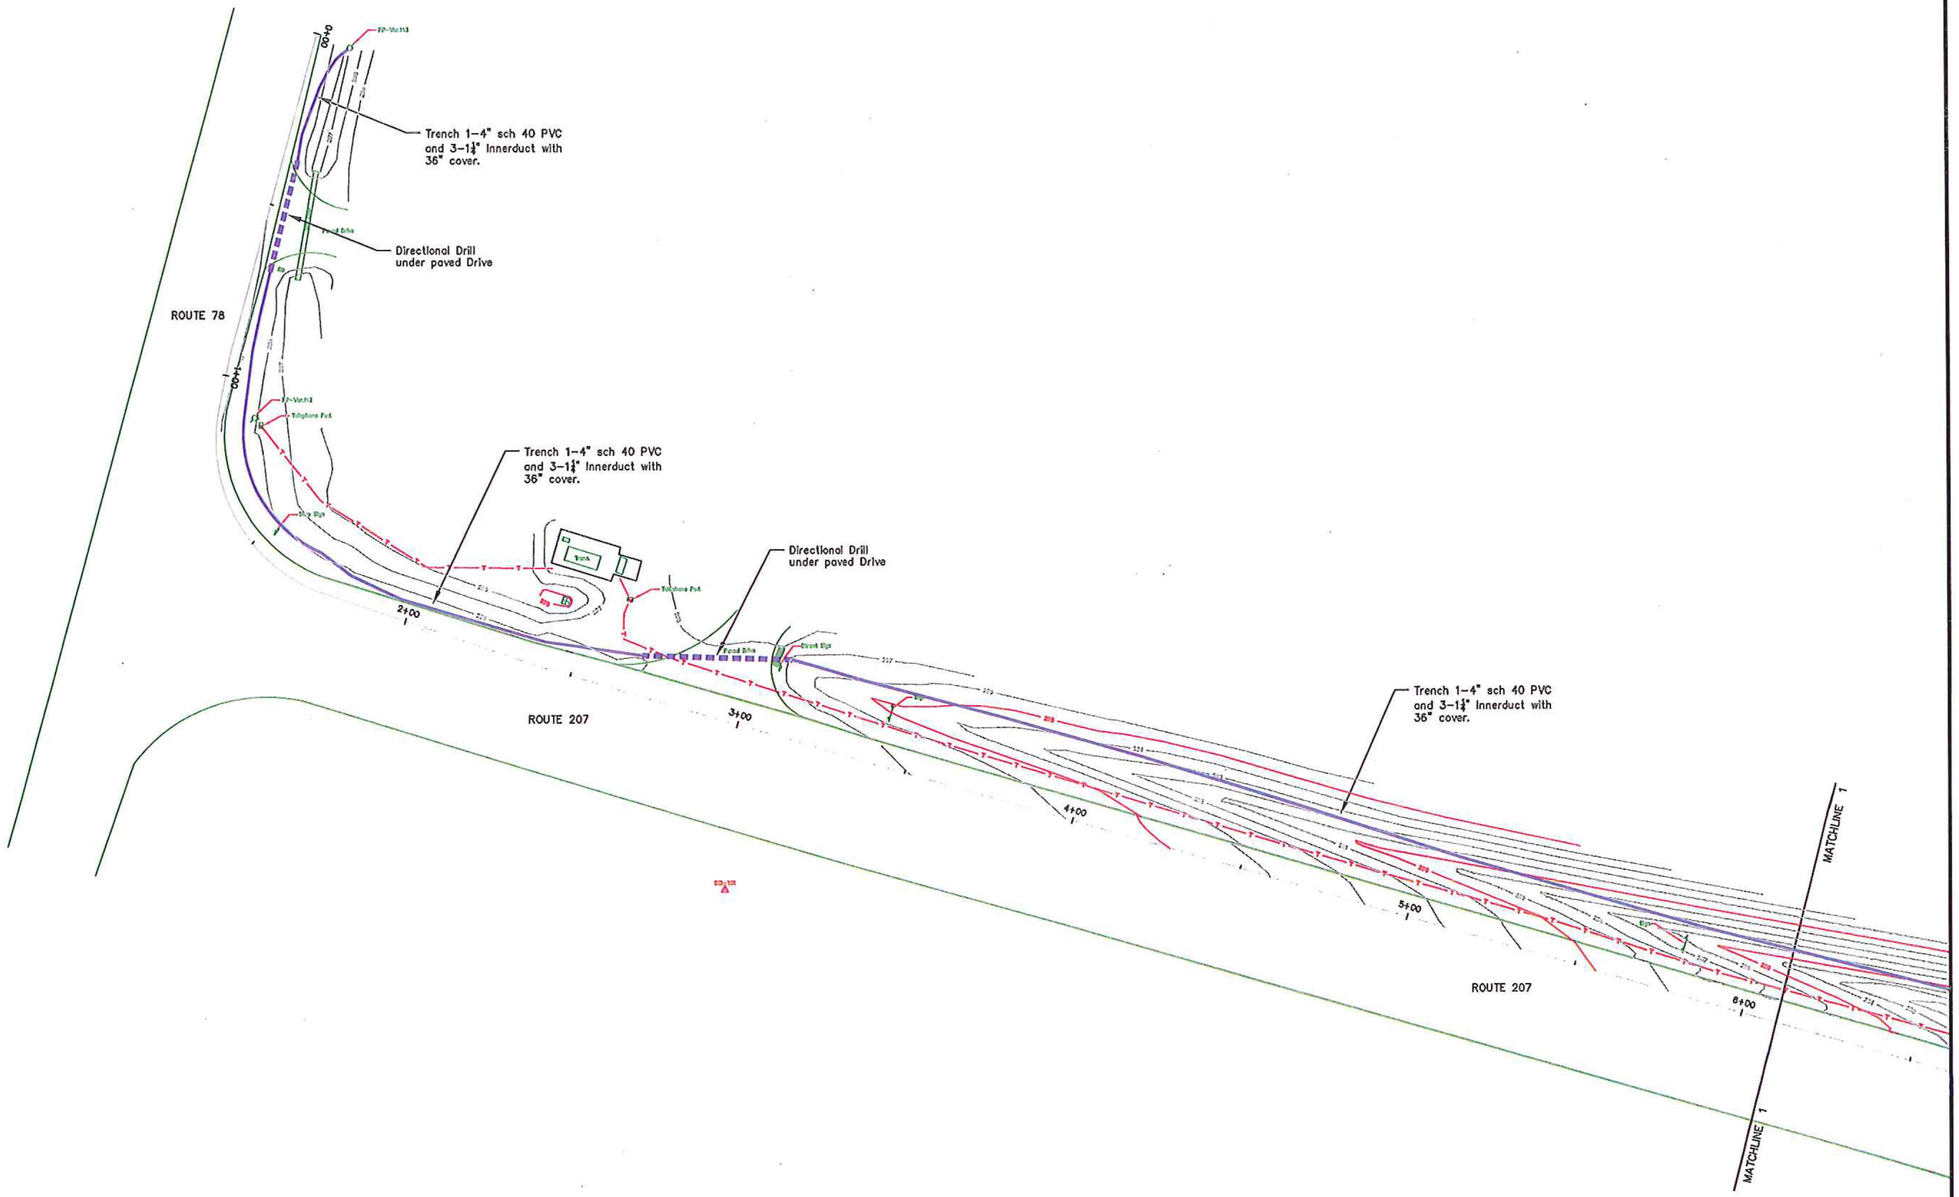

Legend:

- Trench 1–4" PVC and 3–1¼" Innerduct
- Directionally Drill 1–4" SDR 13.5 HDPE and 3–1¼" Innerduct Conduits

Note: Datum is USGS Topography

HIGHGATE STP 0297(8) RE-AD.

ECI
ENGINEERS CONSTRUCTION, INC.
P.O. BOX 2187
SOUTH BURLINGTON, VT 05407
(802) 863 – 6389

TITLE:
FAIRPOINT COMMUNICATIONS
Route 207
Highgate, Vermont

DRAWN BY: NKP	SCALE: 1" = 20'	DATE: 6/20/11	SHEET: 1 OF 5	
CHECKED BY: AWP	DWG NO.: RECORD LOCATION DRAWING			REV –
APPROVED BY: AWP				