Vermont Agency of Transportation
RECEIVED

CK'D BY FDB OK'D BY CLB

May 29, 2015

RESUBMIT No **Approved AsNoted**

BY Carolyn Carlson DATE 06/02/15

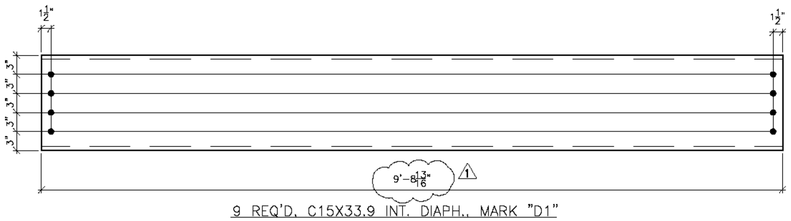

9 REQ'D. C15X33.9 INT. DIAPH., MARK "D1"

BILL OF MATERIAL

SHIP	SHIP MARK	NO. PCS.	PIECE MARK	DESCRIPTION	LENGTH	REMARKS	WT.	
		16	p1	PL 3/4X7 1/2	2'-4 5/16		712	
		3	p2	PL 1/2X5	2'-4 5/16		59	
		9	p3	PL 1/2X5	2'-4 5/16		177	
		3	p4	PL 1/2X5	2'-4 5/16		59	
		3	p5	PL 1/2X5	2'-4 5/16		59	
		2	dp1	PL 1/4X2 5/8	0'-7 3/4		2	
1	D1	9		C15X33.9	9'-8 13/16		2975	

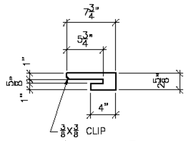

2 REQ'D. 1/4" DRIP PL, MARK "dp1"

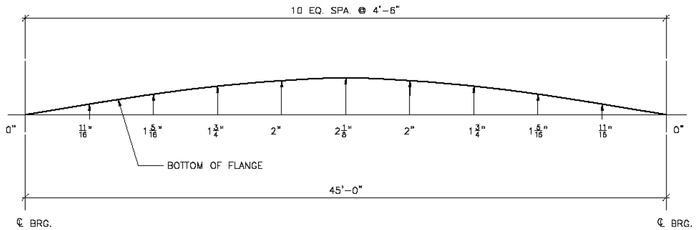

CAMBER DIAGRAM

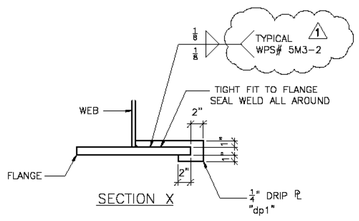

SECTION X

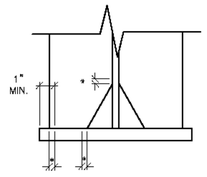

WELD TERMINATION DETAIL

* NO WELD FOR 3/8" MIN. 7/8" MAX.

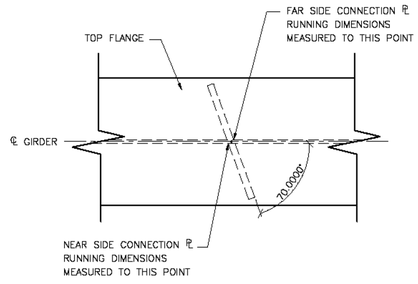

RUNNING DIMENSIONS DETAIL

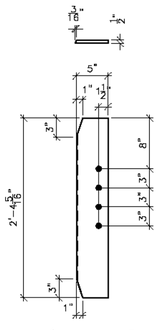

3 REQ'D. 1/2" CONN. PL, MARK "p2"

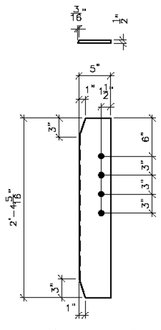

9 REQ'D. 1/2" CONN. PL, MARK "p3"

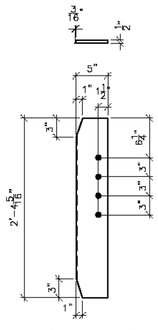

3 REQ'D. 1/2" CONN. PL, MARK "p4"

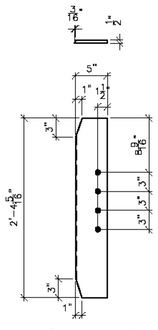

3 REQ'D. 1/2" CONN. PL, MARK "p5"

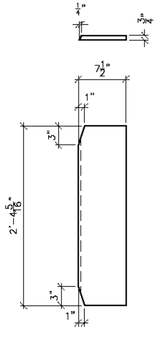

16 REQ'D. 3/4" STIFF. PL, MARK "p1"

FINISH	GALVANIZED				
MATERIAL	ASTM A709 GRADE 50 U.O.N.				
HOLES	15/16"ø U.O.N.				
ELECTRODES					
WELDS	PER WPS				
SURFACE PREP	SSPC SP6	1	5/27/15	PER APPROVAL	JAC
		NO	DATE	DESCRIPTION	BY

REVISIONS

ARC ENTERPRISES, INC.

ADVANCED RESOURCES & CONST. ENTERPRISES, INCORPORATED
P.O. BOX 120 KINGFIELD, ME. 04947
PHONE: (207) 265-2646 – FAX: (207) 265-4054

DRAFTER JAC	MISC. DETAILS		PROJECT NO.
DATE 5/11/15	TOWN OF MIDDLESEX, VT 12 (RURAL MAJOR COLLECTOR)		15-114
CHECKED JS	PROJECT NUMBER BRF 024-1(37)		DWG. NO.
DATE 5/14/15	CUSTOMER: AL ST. ONGE CONTRACTOR, INC.		M1