TEMPORARY 4 INCH WHITE LINE, PAINT
DURABLE 4 INCH WHITE LINE (OPTION BID ITEM)
F54+50 TO F66+50 SOLID RT
F54+50 TO F66+50 SOLID LT

TEMPORARY 4 INCH YELLOW LINE, PAINT
DURABLE 4 INCH YELLOW LINE (OPTION BID ITEM)
F54+50 TO F66+50 SOLID LT & RT

REMOVAL AND DISPOSAL OF GUARDRAIL
F61+80 TO F66+04 LT

6" UNDERDRAIN
F 54+70 TO 55+90 RT
F 56+00 TO 58+40 RT

REMOVING SIGNS
AS SHOWN - 6

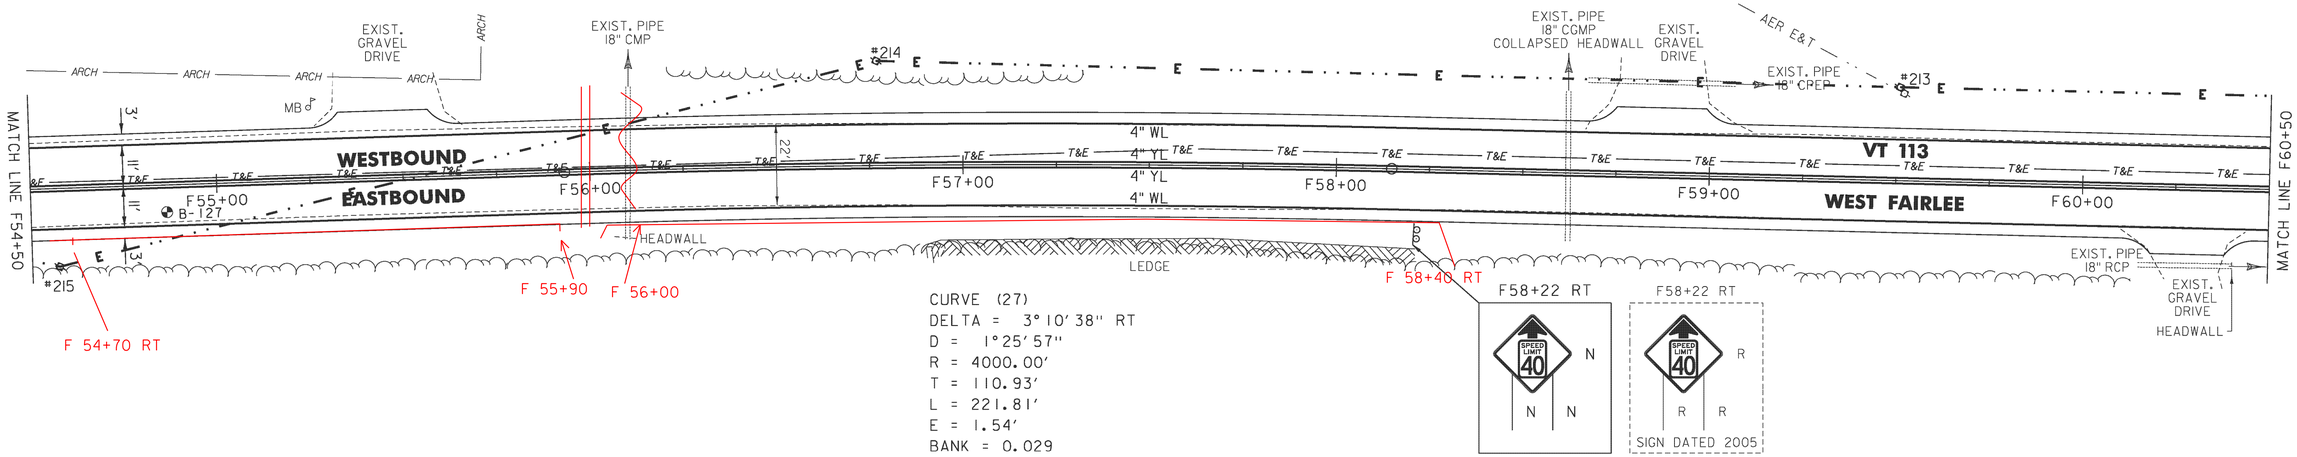

CURVE (27)
DELTA = 3° 10' 38" RT
D = 1° 25' 57"
R = 4000.00'
T = 110.93'
L = 221.81'
E = 1.54'
BANK = 0.029

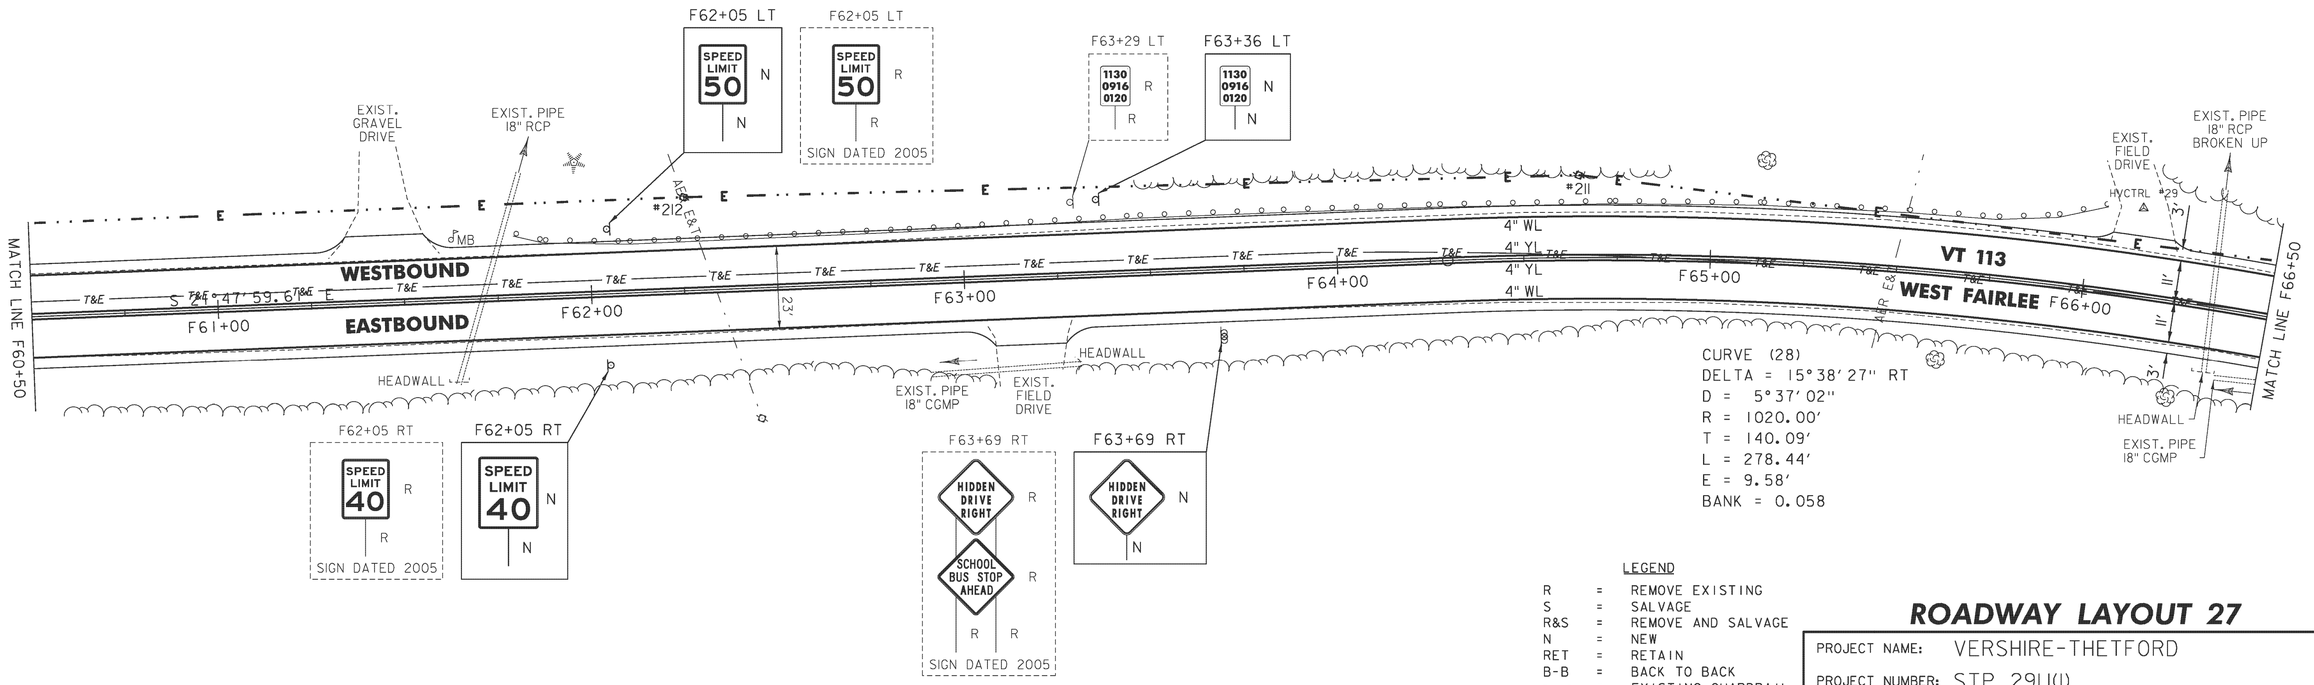

CURVE (28)
DELTA = 15° 38' 27" RT
D = 5° 37' 02"
R = 1020.00'
T = 140.09'
L = 278.44'
E = 9.58'
BANK = 0.058

LEGEND

R	=	REMOVE EXISTING
S	=	SALVAGE
R&S	=	REMOVE AND SALVAGE
N	=	NEW
RET	=	RETAIN
B-B	=	BACK TO BACK
	=	EXISTING GUARDRAIL
	=	PROPOSED GUARDRAIL
YL	=	YELLOW LINE
WL	=	WHITE LINE
	=	DELINEATOR
	=	PROPOSED UP

1	3/8/2013	ADDED ENVIRONMENTAL AND RESOURCE DELINEATION

NOT TO SCALE

ROADWAY LAYOUT 27

PROJECT NAME: VERSHIRE-THETFORD
PROJECT NUMBER: STP 2911(1)

FILE NAME: p10c224.dgn
PROJECT LEADER: PTS
DESIGNED BY: NLL
IPARM FILE NAME: 10C224_54

PLOT DATE: 3/8/2013
DRAWN BY: SNG
CHECKED BY: PTS
SHEET 54 OF 232