TEMPORARY 4 INCH WHITE LINE, PAINT
DURABLE 4 INCH WHITE LINE (OPTION BID ITEM)
T29+50 TO T40+50 SOLID RT
T29+50 TO T40+50 SOLID LT

TEMPORARY 4 INCH YELLOW LINE, PAINT
DURABLE 4 INCH YELLOW LINE (OPTION BID ITEM)
T29+50 TO T40+50 SOLID LT & RT

6 INCH UNDERDRAIN PIPE
~~T31+70~~ TO ~~T34+50~~ RT
T30+50 34+70 RT
REMOVING SIGNS
AS SHOWN - 9

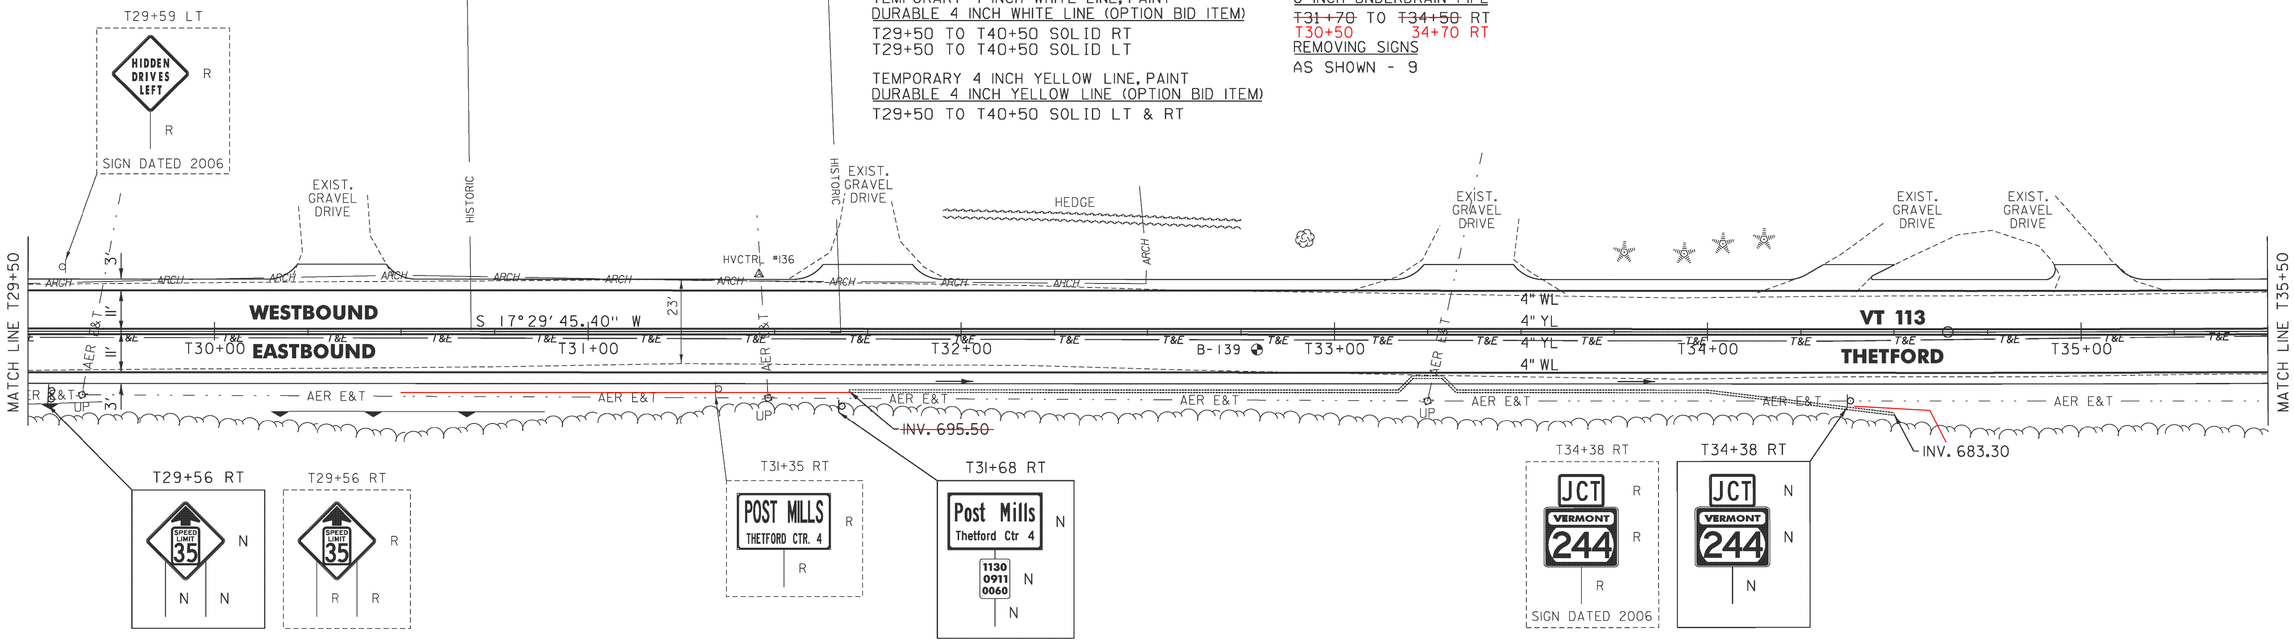

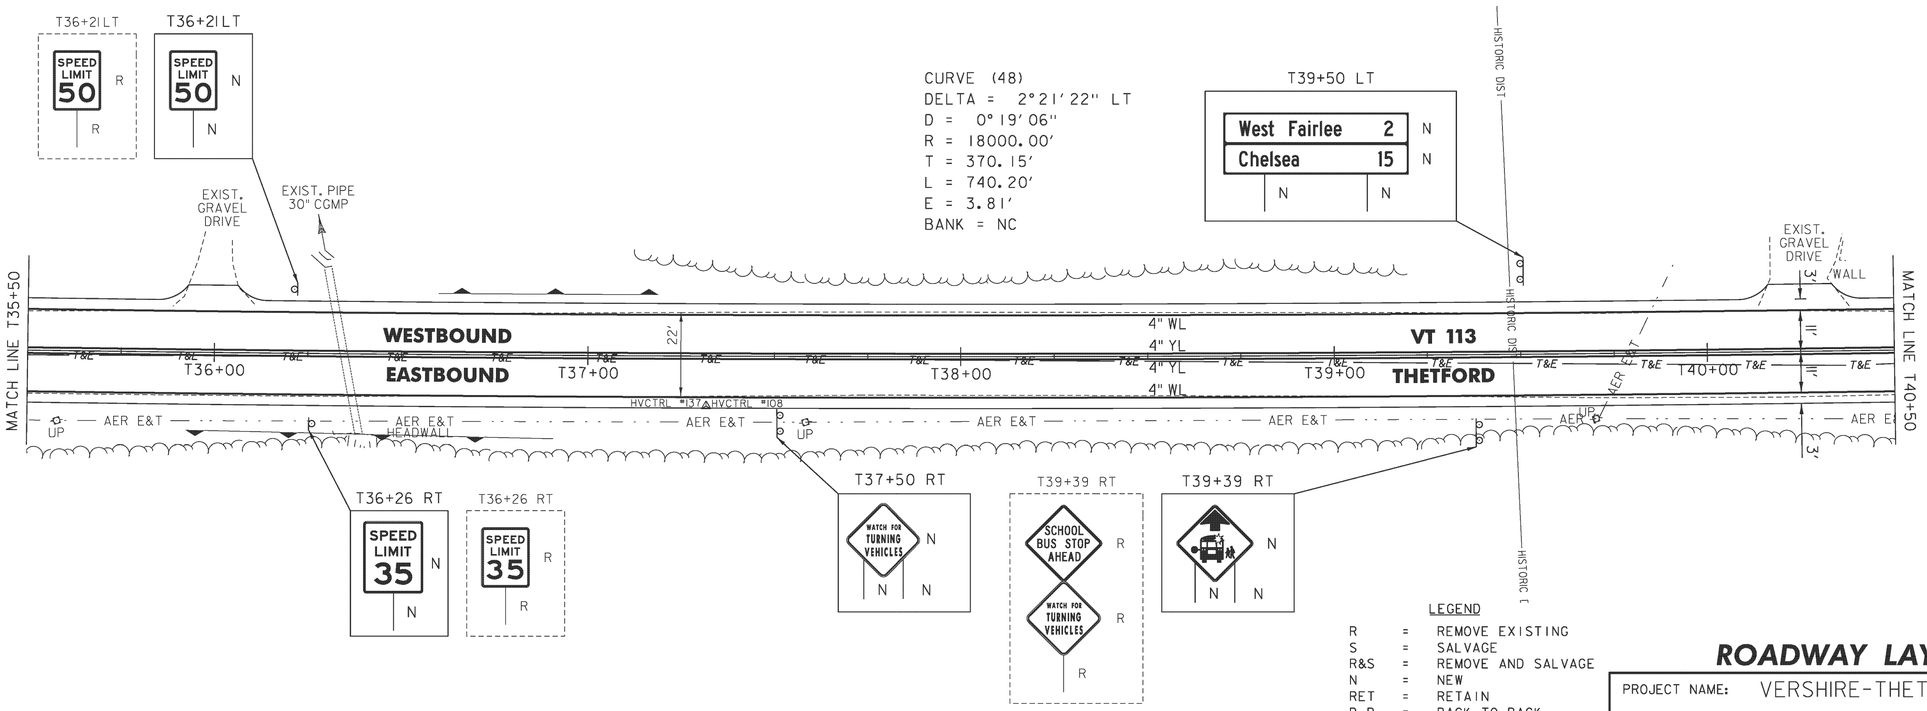

LEGEND

R	=	REMOVE EXISTING
S	=	SALVAGE
R&S	=	REMOVE AND SALVAGE
N	=	NEW
RET	=	RETAIN
B-B	=	BACK TO BACK
	=	EXISTING GUARDRAIL
	=	PROPOSED GUARDRAIL
YL	=	YELLOW LINE
WL	=	WHITE LINE
	=	DELINEATOR
	=	PROPOSED UP

NOT TO SCALE

1	3/8/2013	ADDED ENVIRONMENTAL AND RESOURCE DELINEATION

ROADWAY LAYOUT 39

PROJECT NAME: VERSHIRE-THETFORD
PROJECT NUMBER: STP 2911(1)

FILE NAME: pl0c224.dgn
PROJECT LEADER: PTS
DESIGNED BY: NLL
IPARM FILE NAME: 10C224_66

PLOT DATE: 3/8/2013
DRAWN BY: SNG
CHECKED BY: PTS
SHEET 66 OF 232