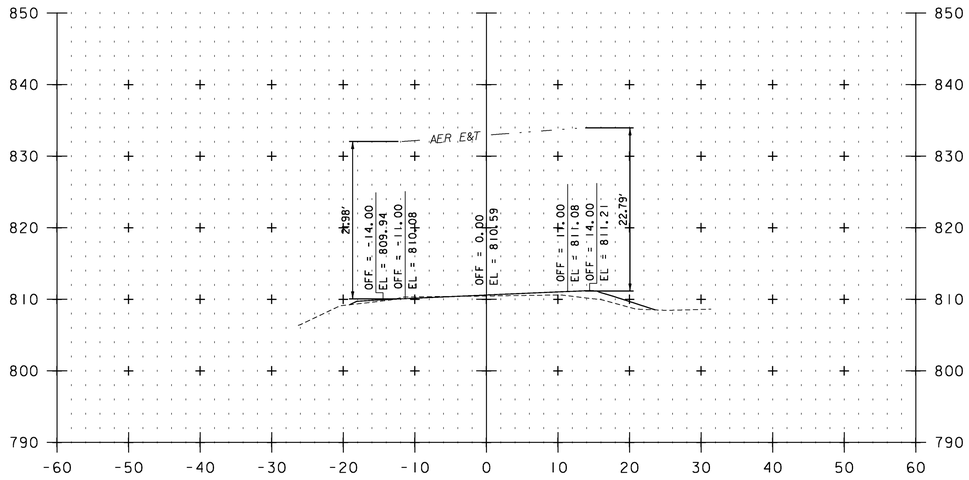

364+60

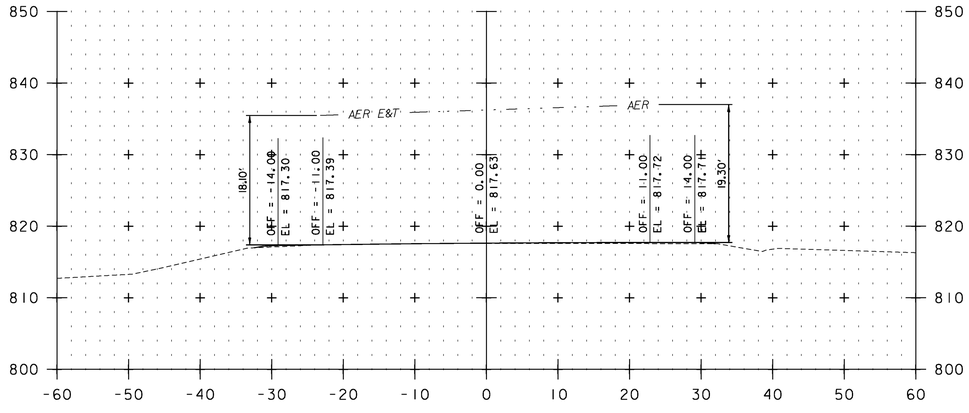

359+04

STA. 359+04 TO STA. 364+60

0 10 20

SCALE IN FEET

UTILITY CROSS SECTION SHEET 10

PROJECT NAME: VERSHIRE-THETFORD

PROJECT NUMBER: STP 2911(1)

FILE NAME: p10c224.dgn
PROJECT LEADER: PTS
DESIGNED BY: NLL
IPARM FILE NAME: 10C224_214

PLOT DATE: 1/29/2013
DRAWN BY: JLS
CHECKED BY: PTS
SHEET 214 OF 232