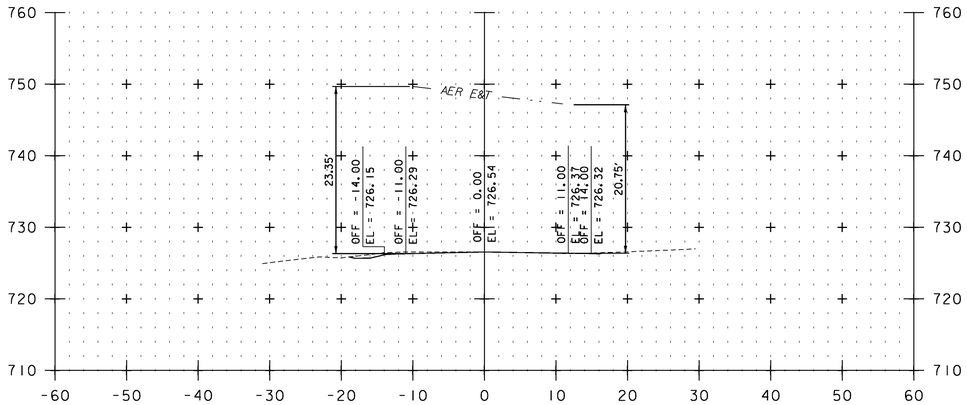

F 117+34

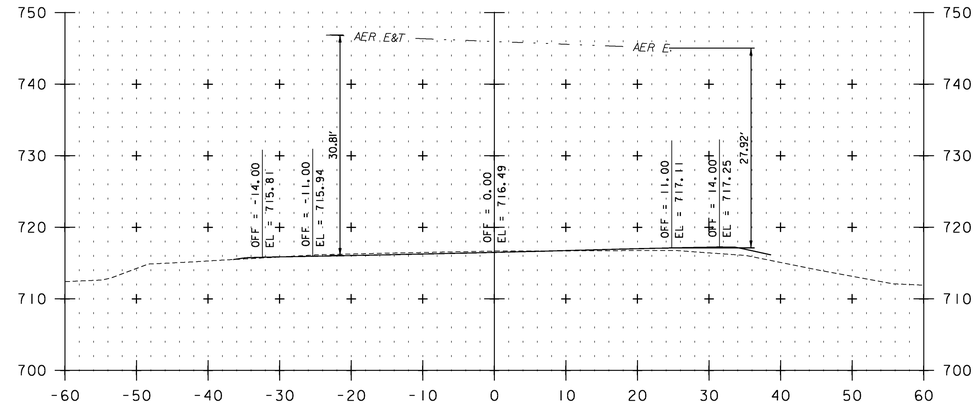

F 122+06

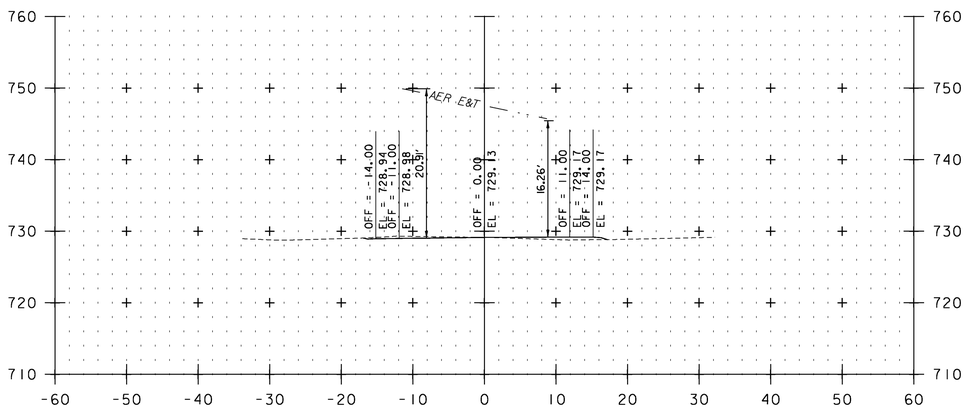

F 115+26

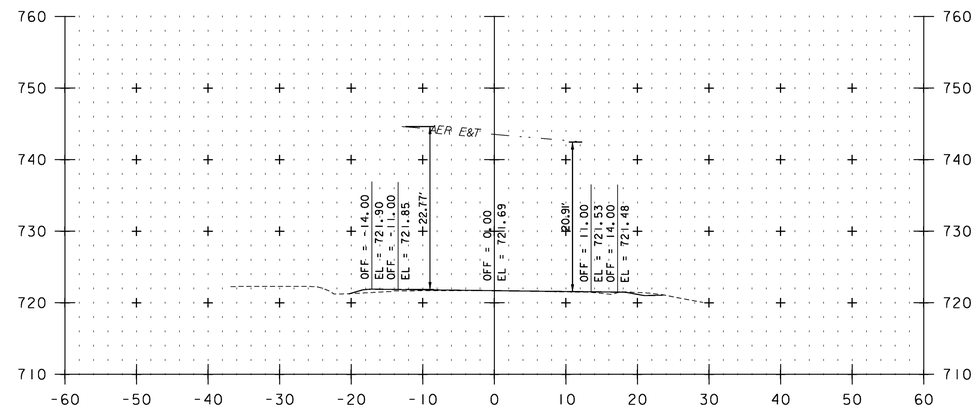

F 120+25

STA. F 115+26 TO STA. F 122+06

0 10 20
SCALE IN FEET

UTILITY CROSS SECTION SHEET 22

PROJECT NAME: VERSHIRE-THETFORD

PROJECT NUMBER: STP 2911(1)

FILE NAME: p10c224.dgn	PLOT DATE: 1/29/2013
PROJECT LEADER: PTS	DRAWN BY: JLS
DESIGNED BY: NLL	CHECKED BY: PTS
IPARM FILE NAME: 10C224_226	SHEET 226 OF 232