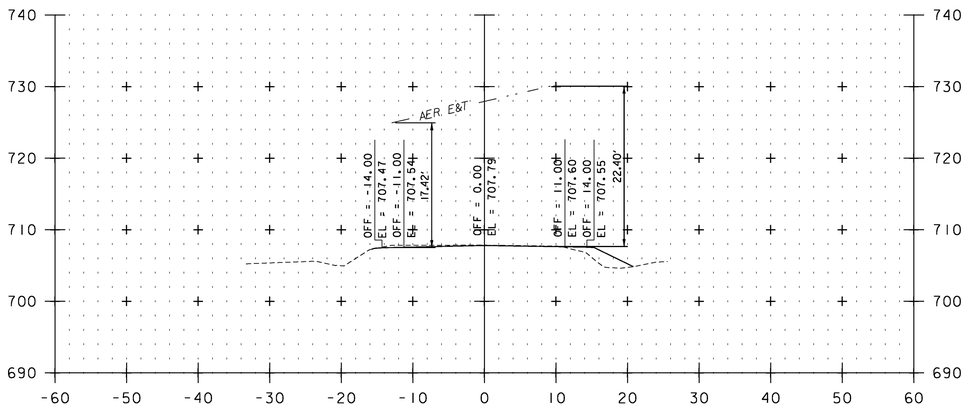

T 29+68

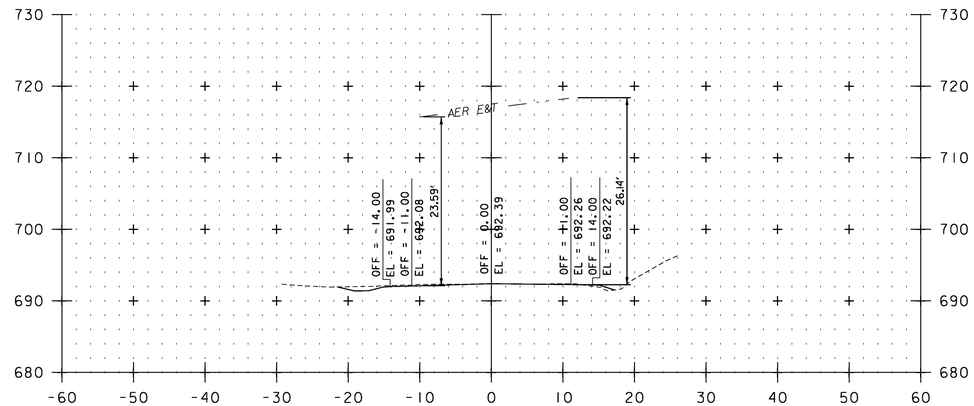

T 33+30

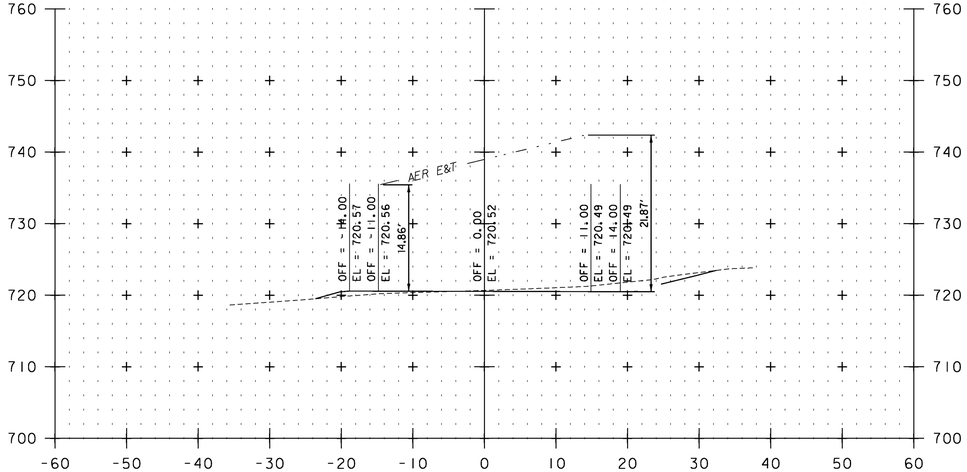

T 26+25

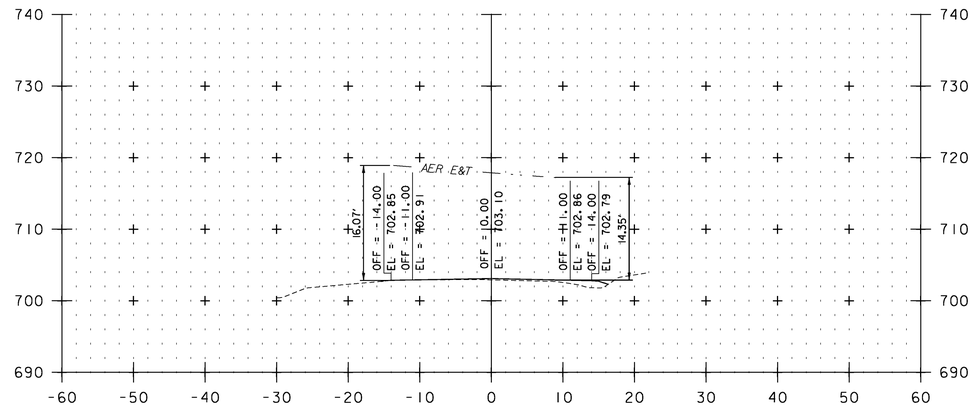

T 31+47

STA. T 26+25 TO STA. T 33+30

0 10 20
SCALE IN FEET

UTILITY CROSS SECTION SHEET 26

PROJECT NAME: VERSHIRE-THETFORD

PROJECT NUMBER: STP 291(1)

FILE NAME: pl0c224.dgn
PROJECT LEADER: PTS
DESIGNED BY: NLL
IPARM FILE NAME: 10C224_230

PLOT DATE: 1/29/2013
DRAWN BY: JLS
CHECKED BY: PTS
SHEET 230 OF 232