STONE FILL, TYPE I
STA. 42+70 TO 43+70, LT
STA. 45+10 TO 46+00, LT

DURABLE 4 INCH WHITE LINE
(ALL LINES WILL INCLUDE EDGE LINE BREAKS AND RADII FOR SIDE ROADS)
STA. 42+50 TO 48+50, SOLID LT & RT

DURABLE 4 INCH YELLOW LINE
(ALL LINES WILL INCLUDE ℄ BREAKS FOR SIDE ROADS)
STA. 42+50 TO 48+50, DASHED ℄

TEMPORARY 4 INCH WHITE LINE, PAINT
(ALL LINES WILL INCLUDE EDGE LINE BREAKS AND RADII FOR SIDE ROADS)
STA. 42+50 TO 48+50, SOLID LT & RT

TEMPORARY 4 INCH YELLOW LINE, PAINT
(ALL LINES WILL INCLUDE ℄ BREAKS FOR SIDE ROADS)
STA. 42+50 TO 48+50, DASHED ℄

GEOTEXTILE UNDER STONE FILL
STA. 42+70 TO 43+70, LT
STA. 45+10 TO 46+00, LT

GRUBBING MATERIAL
STA. 42+70 TO 43+70, LT
STA. 45+10 TO 46+00, LT

REMOVING SIGNS
AS SHOWN - 1

UD-15E STA 49+60 TO 54+50, RT
CONSTRUCT 6 INCH UNDERDRAIN PIPE,
SEE SHEET 12 FOR DETAIL.

VT STATE PLANE GRID

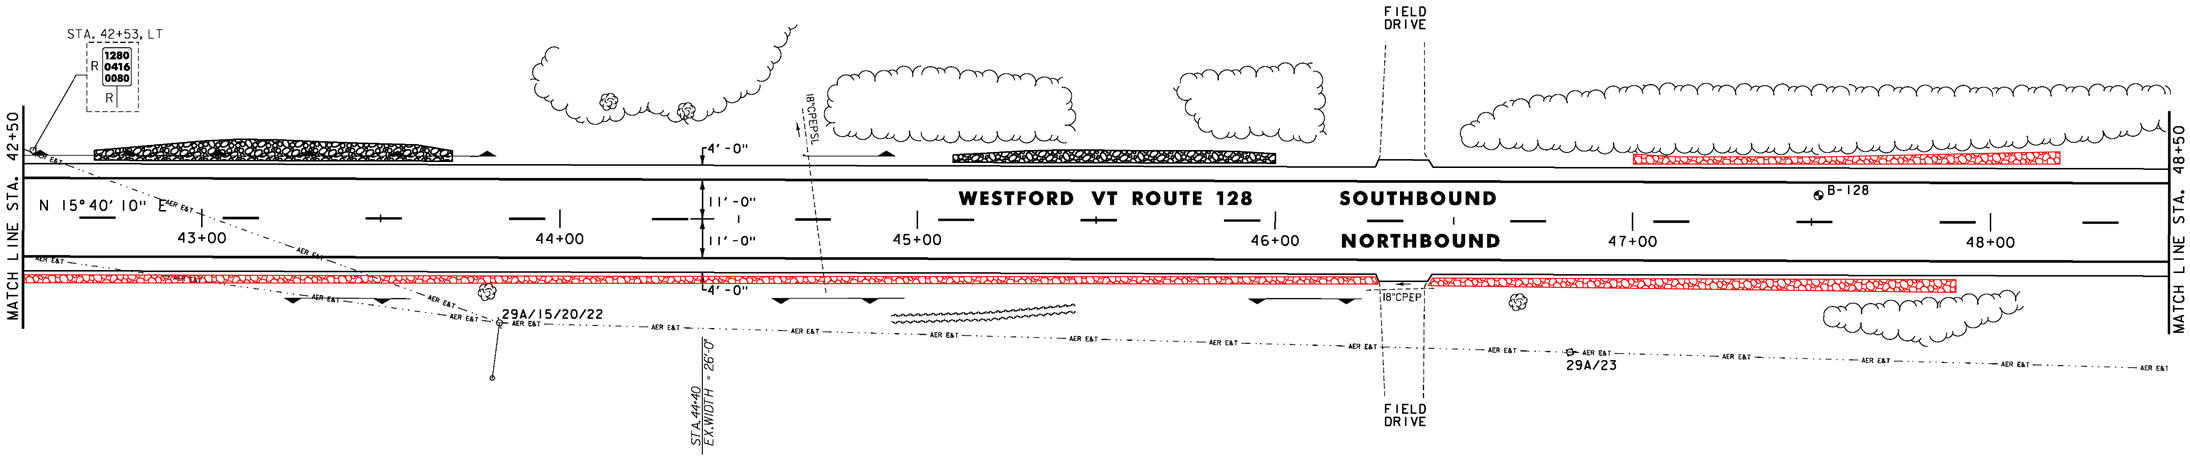

SOIL BORING DATA			
BORING#	DEPTH (FT.)	PCC	COMMENTS
B-128	5.0'	NO	

STONE FILL, TYPE I
STA. 48+70 TO 50+80, RT
STA. 49+00 TO 49+30, LT
STA. 52+70 TO 54+30, LT

DURABLE 4 INCH WHITE LINE
(ALL LINES WILL INCLUDE EDGE LINE BREAKS AND RADII FOR SIDE ROADS)
STA. 48+50 TO 54+50, SOLID LT & RT

DURABLE 4 INCH YELLOW LINE
(ALL LINES WILL INCLUDE ℄ BREAKS FOR SIDE ROADS)
STA. 48+50 TO 49+63, DASHED ℄
STA. 49+63 TO 54+50, DASHED LT, SOLID RT

TEMPORARY 4 INCH WHITE LINE, PAINT
(ALL LINES WILL INCLUDE EDGE LINE BREAKS AND RADII FOR SIDE ROADS)
STA. 48+50 TO 54+50, SOLID LT & RT

TEMPORARY 4 INCH YELLOW LINE, PAINT
(ALL LINES WILL INCLUDE ℄ BREAKS FOR SIDE ROADS)
STA. 48+50 TO 49+63, DASHED ℄
STA. 49+63 TO 54+50, DASHED LT, SOLID RT

GEOTEXTILE UNDER STONE FILL
STA. 48+70 TO 50+80, RT
STA. 49+00 TO 49+30, LT
STA. 52+70 TO 54+30, LT

GRUBBING MATERIAL
STA. 48+70 TO 50+80, RT
STA. 49+00 TO 49+30, LT
STA. 52+70 TO 54+30, LT

REMOVING SIGNS
AS SHOWN - 3

VT STATE PLANE GRID

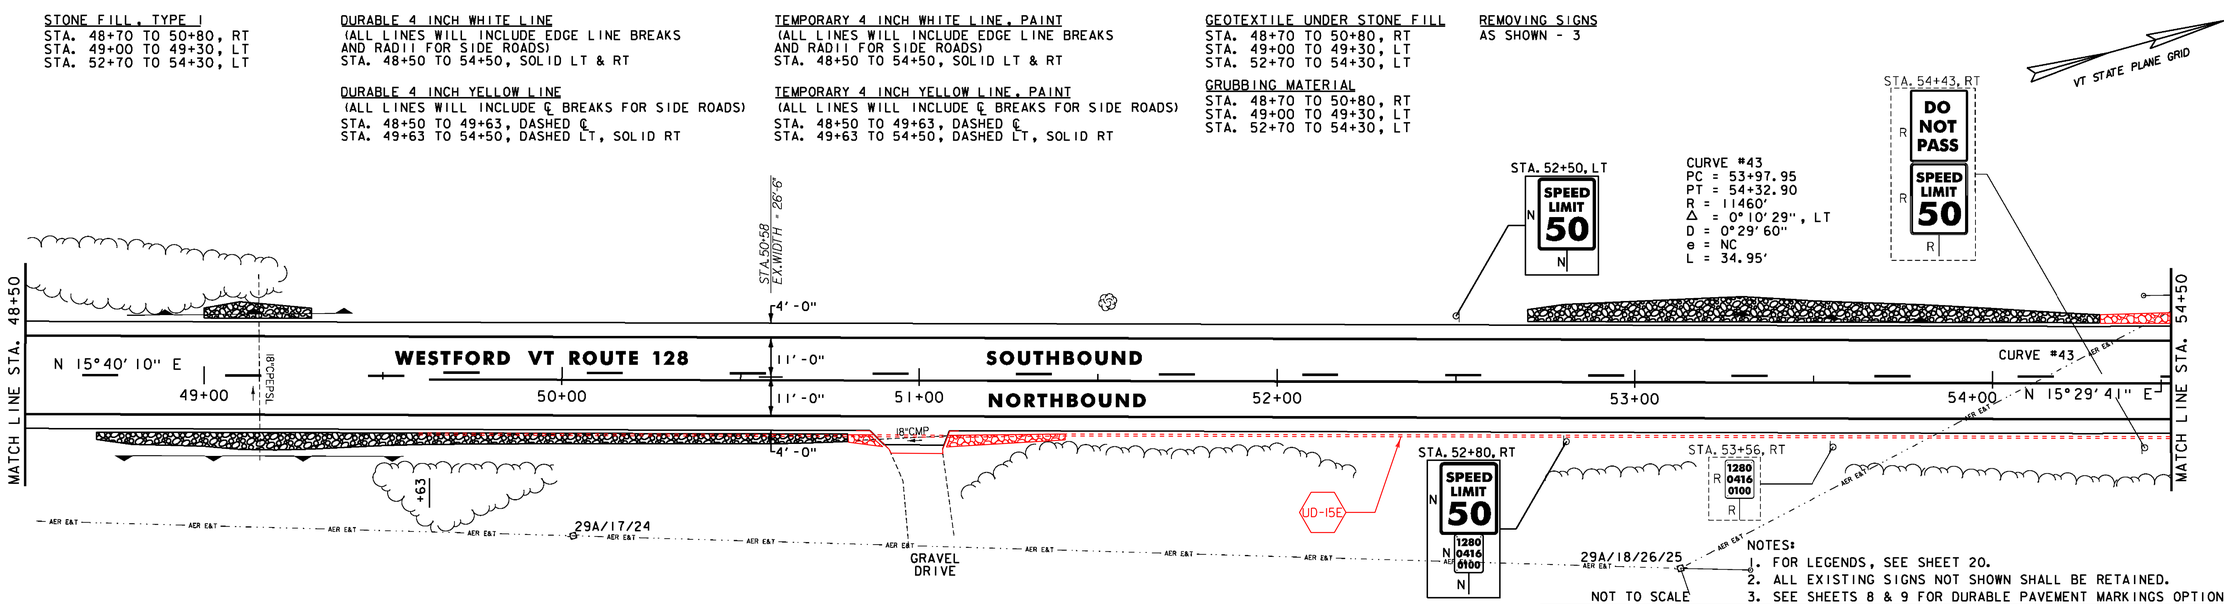

NOTES:
1. FOR LEGENDS, SEE SHEET 20.
2. ALL EXISTING SIGNS NOT SHOWN SHALL BE RETAINED.
3. SEE SHEETS 8 & 9 FOR DURABLE PAVEMENT MARKINGS OPTIONS.

NOT TO SCALE

Stantec

PROJECT LAYOUT SHEET #29

PROJECT NAME: ESSEX-WESTFORD
PROJECT NUMBER: STP 2912(I)

FILE NAME: pl0c226.dgn
PROJECT LEADER: JLL
DESIGNED BY: STANTEC
IPARM FILE: p10c226l29.i
PLOT DATE: 2/20/2013
DRAWN BY: STANTEC
CHECKED BY: STANTEC
SHEET 48 OF 239