DURABLE 4 INCH WHITE LINE, SEE OPTION ITEMS
STA. 124+05 - STA. 129+25 (SOLID LT & RT)

TEMPORARY 4 INCH WHITE LINE, PAINT
STA. 124+05 - STA. 129+25 (SOLID LT & RT)

DURABLE 4 INCH YELLOW LINE, POLYUREA
STA. 124+05 - STA. 129+25 (CENTERLINE)

TEMPORARY 4 INCH YELLOW LINE, PAINT
STA. 124+05 - STA. 129+25 (CENTERLINE)

REMOVING SIGNS
AS SHOWN - 7

ERECTING SALVAGED SIGNS
AS SHOWN - 5

REHAB. DROP INLET/MANHOLE
STA. 124+40 LT

CURVE #1
DELTA = 0°26'38"
D = 0°34'23"
R = 10000.00'
T = 38.73'
L = 77.46'
E = 0.08'
BANKING NORMAL CROWN
DESIGN SPEED 35 MPH
SEE SUPERELEVATION DIAGRAMS
FOR MORE INFORMATION

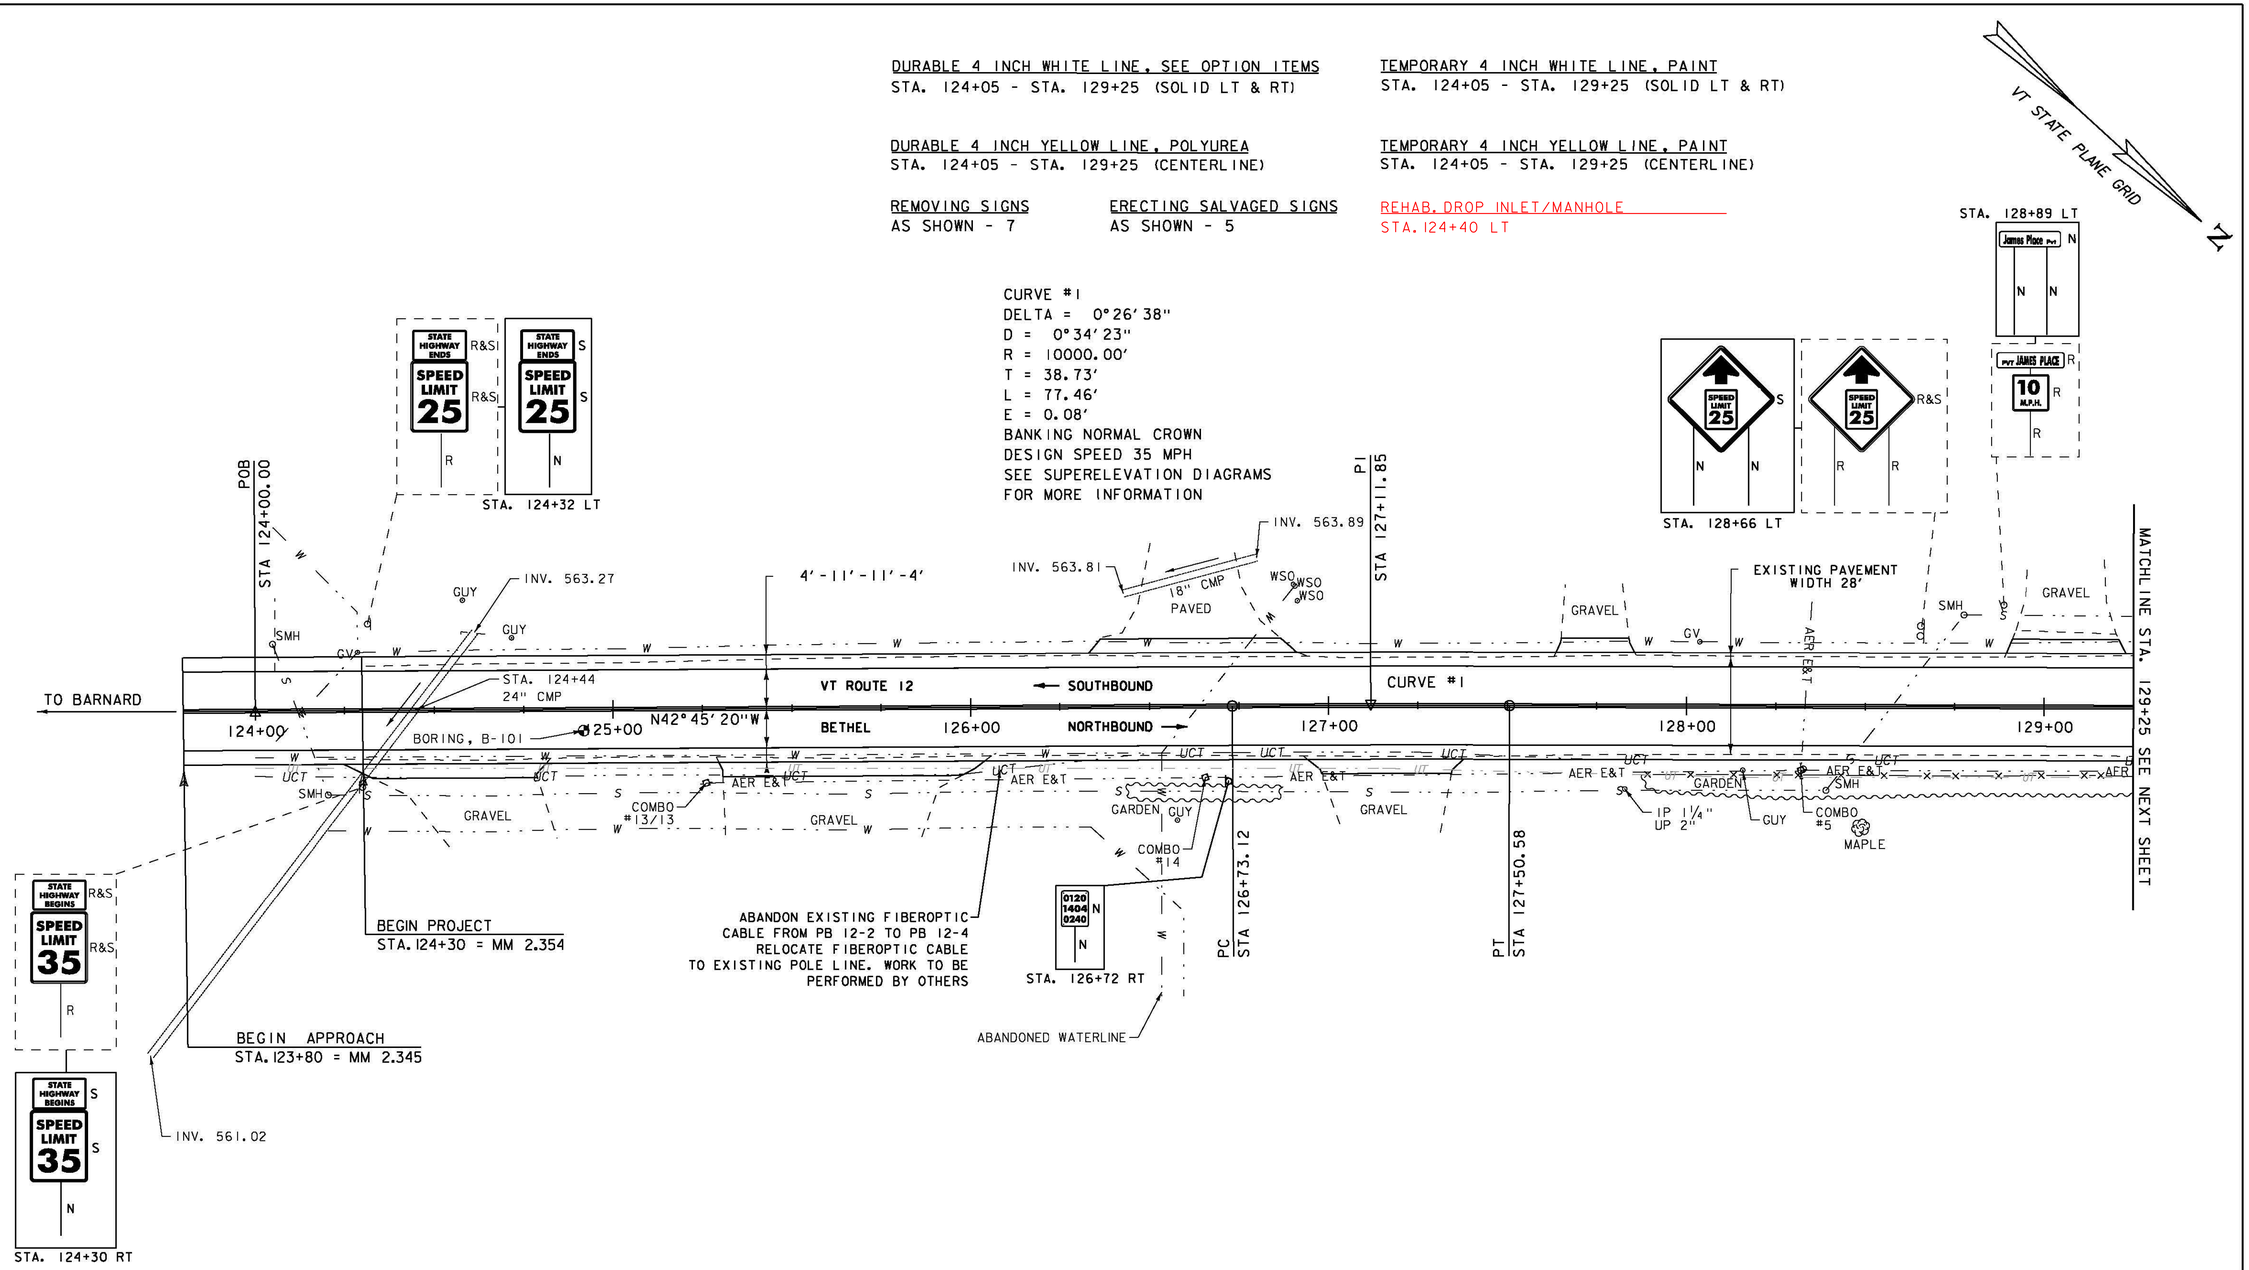

SIGN LEGEND

R = REMOVE
R&S = REMOVE AND SALVAGE
RET = RETAIN
S = SALVAGED
N = NEW
B-B = BACK TO BACK
– – = EXISTING
—— = NEW

0 20 40
SCALE IN FEET

PROJECT NAME: BETHEL-RANDOLPH	
PROJECT NUMBER: STP 2921(1)	
FILE NAME: z10c244bdr.dgn	PLOT DATE: 4/23/2015
PROJECT LEADER: C. LATHROP	DRAWN BY: S. LAMPHERE
DESIGNED BY: S. LAMPHERE	CHECKED BY: C. LATHROP
PLAN SHEET 1	SHEET 27 OF 211