~~REHAB DROP INLETS, CATCH BASINS, OR MANHOLES, CLASS I~~
~~STA. 237+70 LT~~

DURABLE 4 INCH WHITE LINE, SEE OPTION ITEMS
STA. 234+25 - STA. 239+25 (SOLID LT & RT)

DURABLE 4 INCH YELLOW LINE, POLYUREA
STA. 234+25 - STA. 239+25 (CENTERLINE)

REMOVING SIGNS
AS SHOWN - 3

ERECTING SALVAGED SIGNS
AS SHOWN - 1

TEMPORARY 4 INCH WHITE LINE, PAINT
STA. 234+25 - STA. 239+25 (SOLID LT & RT)

TEMPORARY 4 INCH YELLOW LINE, PAINT
STA. 234+25 - STA. 239+25 (CENTERLINE)

~~6 INCH UNDERDRAIN PIPE~~
~~STA. 235+50 - STA. 237+75 RT~~

CURVE #15
DELTA = 22°41'12"
D = 6°01'52"
R = 950.00'
T = 190.58'
L = 376.16'
E = 18.93'
BANKING 0.077 FT/FT
DESIGN SPEED 50 MPH
SEE SUPERELEVATION DIAGRAMS
FOR MORE INFORMATION

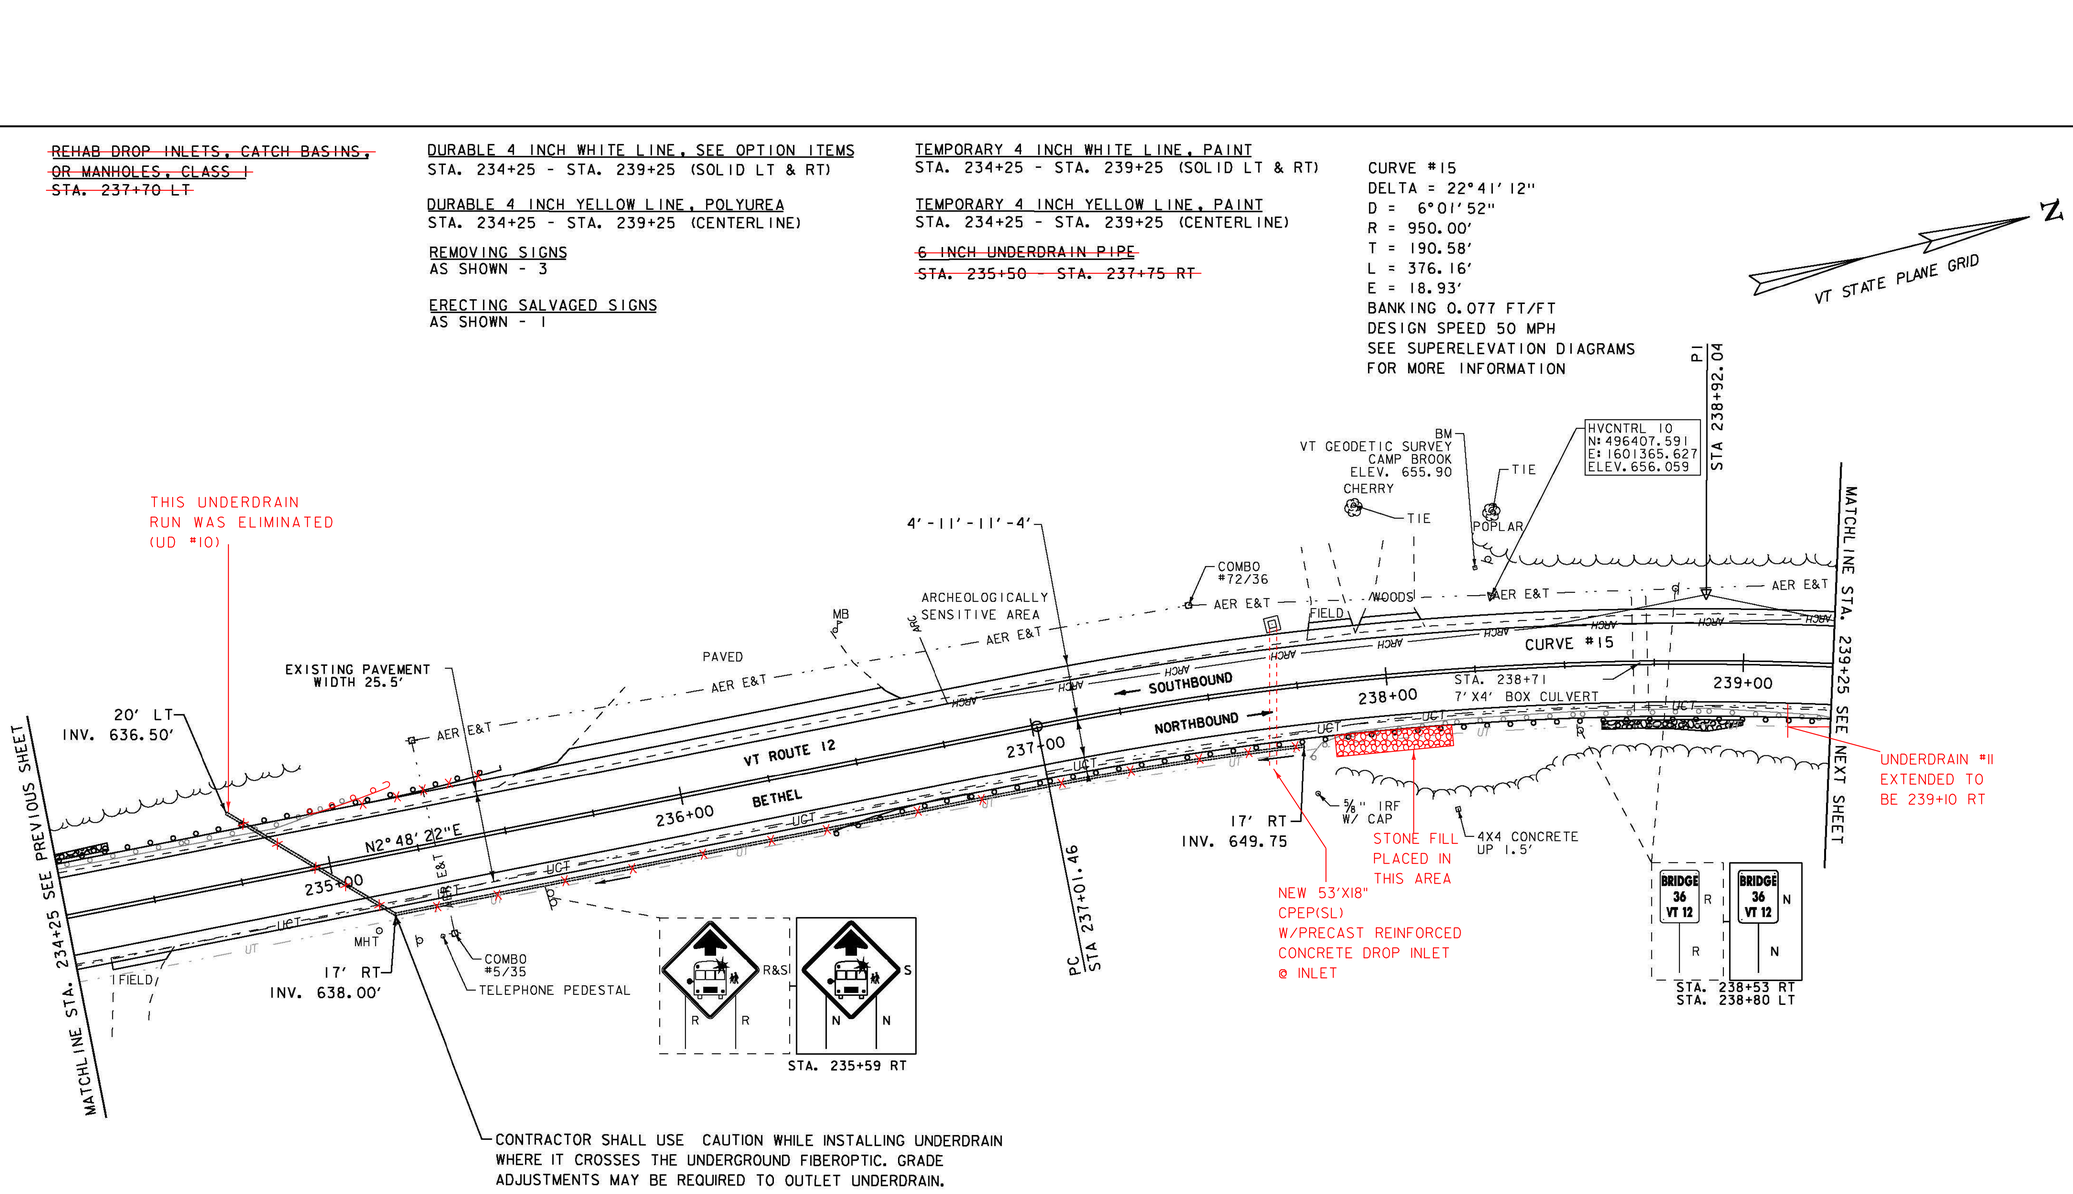

TREATED TIMBER CURB
STA. 234+25 - STA. 234+75 LT

REMOVAL AND DISPOSAL OF GUARDRAIL
STA. 234+25 - STA. 235+11 LT
STA. 236+00 - STA. 239+25 RT

SPECIAL PROVISION (BOX BEAM GUARDRAIL W/7 FEET POSTS)
STA. 234+25 - STA. ~~235+50~~ LT 235+16
STA. 236+41 - STA. 239+25 RT

STONE FILL, TYPE I
STA. 234+25 - STA. 234+40 LT
STA. 238+60 - STA. 239+00 RT
STA. 237+83 - STA. 238+15 RT

GEOTEXTILE FOR SILT FENCE
STA. 234+25 - STA. 234+40 LT
STA. 238+60 - STA. 239+00 RT

GRUBBING MATERIAL (6")
STA. 234+25 - STA. 234+40 LT
STA. 238+60 - STA. 239+00 RT

PRECAST REINFORCED CONCRETE DROP INLET WITH CAST IRON GRATE
STA. 237+70 LT

18" CPEP(SL)
STA. 237+70 LT/RT-53'

SIGN LEGEND
R = REMOVE
R&S = REMOVE AND SALVAGE
RET = RETAIN
S = SALVAGED
N = NEW
B-B = BACK TO BACK
– – = EXISTING
—— = NEW

0 20 40
SCALE IN FEET

PROJECT NAME:	BETHEL-RANDOLPH
PROJECT NUMBER:	STP 2921(1)
FILE NAME: z10c244bdr.dgn	PLOT DATE: 4/23/2015
PROJECT LEADER: C. LATHROP	DRAWN BY: S. LAMPHERE
DESIGNED BY: S. LAMPHERE	CHECKED BY: C. LATHROP
PLAN SHEET 21	SHEET 47 OF 211