DURABLE 4 INCH WHITE LINE, SEE OPTION ITEMS
STA. A 35+50 - STA. A 41+25 (SOLID LT & RT)

DURABLE 4 INCH YELLOW LINE, POLYUREA
STA. A 35+50 - STA. A 41+25 (CENTERLINE)

MILLED RUMBLE STRIPS
STA. A 38+50 - STA. A 41+25 (CENTERLINE)

TEMPORARY 4 INCH WHITE LINE, PAINT
STA. A 35+50 - STA. A 41+25 (SOLID LT & RT)

TEMPORARY 4 INCH YELLOW LINE, PAINT
STA. A 35+50 - STA. A 41+25 (CENTERLINE)

6 INCH UNDERDRAIN PIPE
STA. A 35+50 - STA. A ~~36+16~~ 36+20 LT
STA. A ~~40+69~~ 40+75 - STA. A 41+25 LT

PRECAST CONCRETE STRUCTURE (HEADWALL)
STA. A 36+18 LT

18" CPEP
STA. A 36+18 LT-2.5'

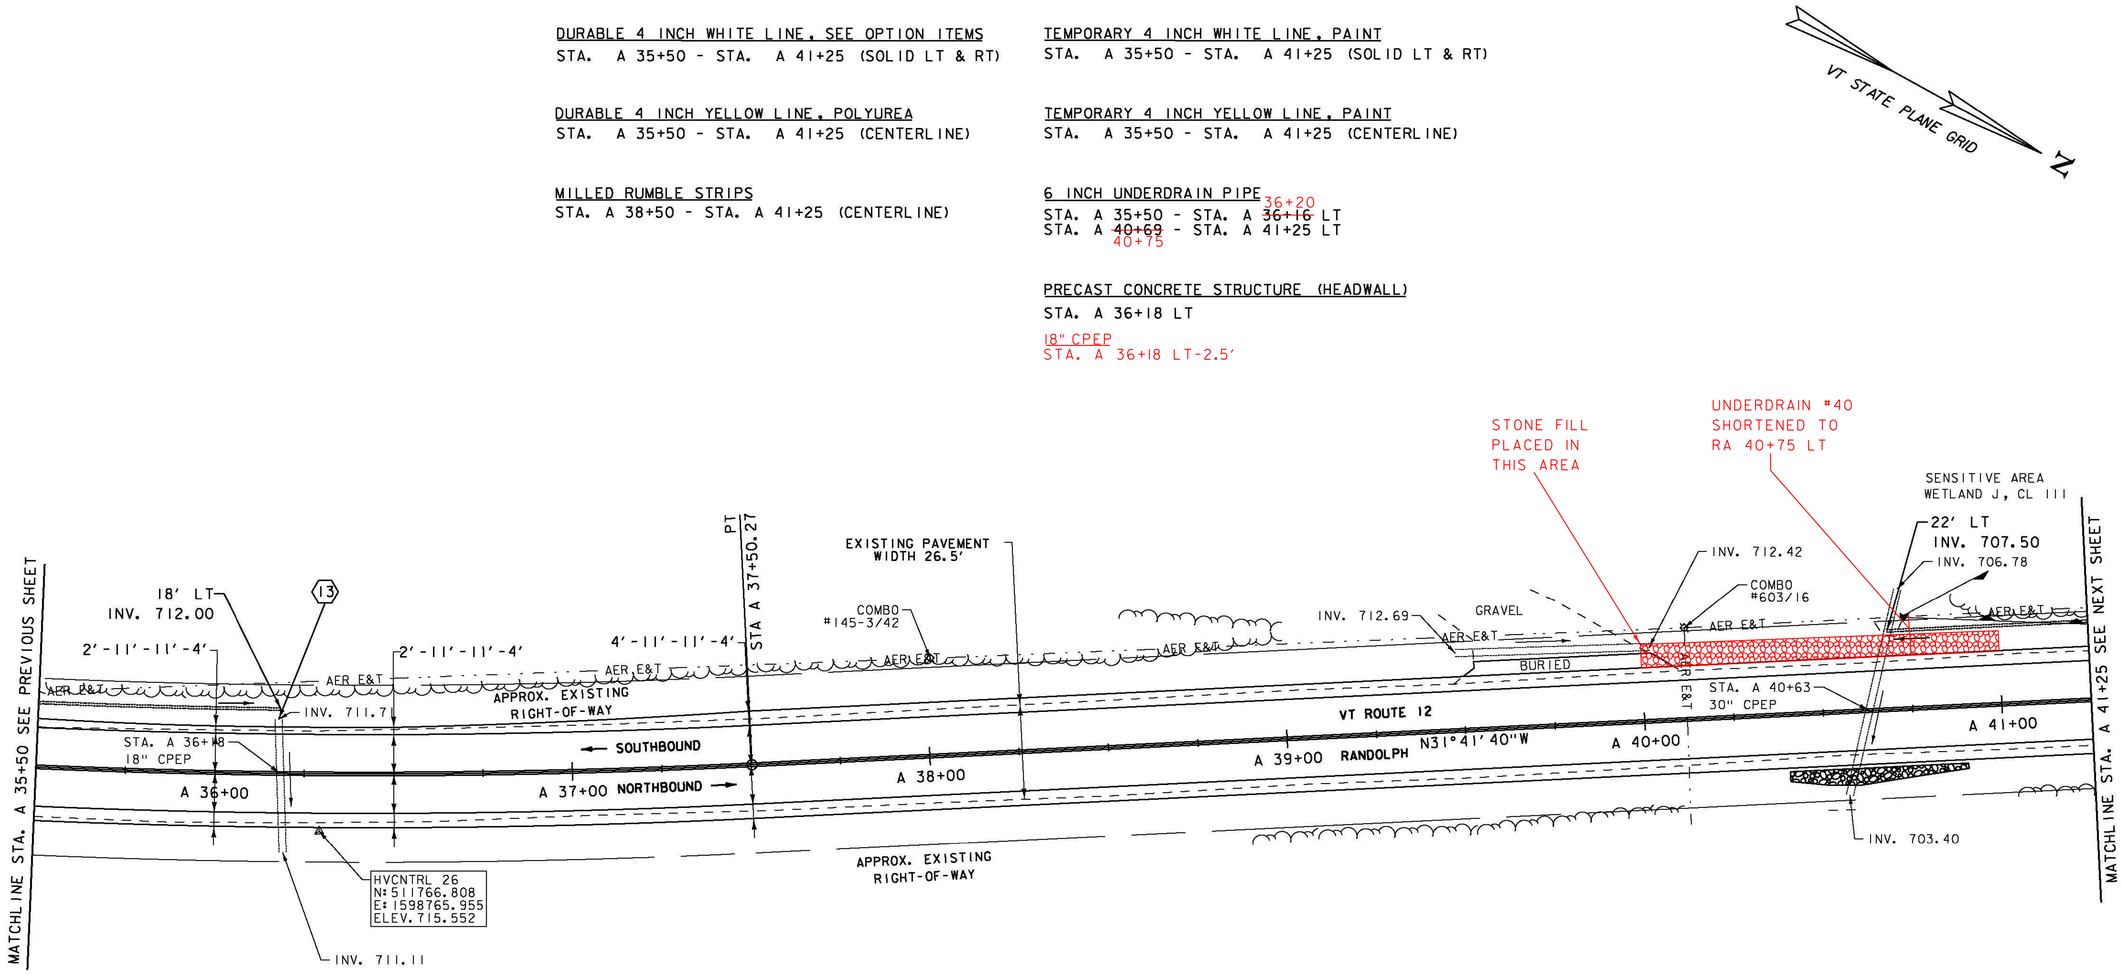

(13) INSTALL NEW PRECAST CONCRETE HEADWALL AT STA. A 36+18 LT. PIPE INV. = 711.71', TOP OF HEADWALL EL. = 714.73'

STONE FILL, TYPE I
STA. A 40+40 - STA. A 40+90 RT
STA. A 40+00 - STA. A 41+00 LT

GEOTEXTILE FOR SILT FENCE
STA. A 40+40 - STA. A 40+90 RT

GRUBBING MATERIAL (6")
STA. A 40+40 - STA. A 40+90 RT

ENVIRONMENTALLY SENSITIVE LOCATIONS:

NO.	LIMITS	POS.	TYPE
11.	STA. A 40+73 - STA. A 41+25	LT	-

SIGN LEGEND
R = REMOVE
R&S = REMOVE AND SALVAGE
RET = RETAIN
S = SALVAGED
N = NEW
B-B = BACK TO BACK
– – = EXISTING
—— = NEW

0 20 40
SCALE IN FEET

PROJECT NAME: BETHEL-RANDOLPH
PROJECT NUMBER: STP 2921(1)

FILE NAME: z10c244bdr.dgn
PROJECT LEADER: C. LATHROP
DESIGNED BY: S. LAMPHERE
PLAN SHEET 52
PLOT DATE: 4/23/2015
DRAWN BY: S. LAMPHERE
CHECKED BY: C. LATHROP
SHEET 78 OF 211