COMMON EXCAVATION
STA. 106+04 - STA. 106+08 LT
STA. 106+25 - STA. 106+30 LT ✓
STA. 106+96 - STA. 107+02 LT ✓
STA. 107+18 - STA. 107+23 LT ✓

NOT DONE DUE TO PROPOSED SW PROJ.

PORTLAND CEMENT CONCRETE SIDEWALK, 5 INCH
STA. 106+04 - STA. 106+08 LT
STA. 106+25 - STA. 106+30 LT
STA. 106+96 - STA. 107+02 LT
STA. 107+18 - STA. 107+23 LT

SUBBASE OF CRUSHED GRAVEL, FINE GRADED
STA. 106+04 - STA. 106+08 LT
STA. 106+25 - STA. 106+30 LT
STA. 106+96 - STA. 107+02 LT
STA. 107+18 - STA. 107+23 LT

REMOVE AND RESET CURB
STA. 105+98 - STA. 106+09 LT
STA. 106+26 - STA. 106+39 LT
STA. 106+87 - STA. 106+99 LT
STA. 107+11 - STA. 107+23 LT

DETECTABLE WARNING SURFACES
STA. 106+07 LT (8 SF) NOT DONE, PROPOSED SW PROJECT
STA. 106+28 LT (8 SF) ✓
STA. 106+97 LT (8 SF) ✓
STA. 107+19 LT (8 SF) ✓

DURABLE 4 INCH WHITE LINE, TYPE I TAPE
STA. 105+25 - STA. 110+50 (SOLID LT & RT)
STA. 105+85 LT (EDGELINES TH #46)
STA. 107+35 LT (EDGELINES TH #46)

DURABLE 4 INCH YELLOW LINE, TYPE I TAPE
STA. 105+25 - STA. 110+50 (SOLID LT & RT)
(WITH BREAKS AT SIDEROADS)
STA. 106+20 - STA. 106+37 LT (CENTERLINE TH #46)
STA. 106+99 - STA. 107+09 LT (CENTERLINE TH #46)

TEMPORARY 4 INCH WHITE LINE, PAINT
STA. 105+25 - STA. 110+50 (SOLID LT & RT)
STA. 105+85 LT (EDGELINES TH #46)
STA. 107+35 LT (EDGELINES TH #46)

TEMPORARY 4 INCH YELLOW LINE, PAINT
STA. 105+25 - STA. 110+50 (SOLID LT & RT)
(WITH BREAKS AT SIDEROADS)
STA. 106+20 - STA. 106+37 LT (CENTERLINE TH #46)
STA. 106+99 - STA. 107+09 LT (CENTERLINE TH #46)

DURABLE 24 INCH STOP BAR, TYPE I TAPE
STA. 107+02 - STA. 107+09 LT

TEMPORARY 24 INCH STOP BAR, PAINT
STA. 107+02 - STA. 107+09 LT

DURABLE LETTER OR SYMBOL, TYPE I TAPE
STA. 106+21 LT "YIELD"
STA. 106+99 LT "STOP"

TEMPORARY LETTER OR SYMBOL, PAINT
STA. 106+21 LT "YIELD"
STA. 106+99 LT "STOP"

CHANGING ELEVATION OF SEWER MANHOLES
STA. 109+53 LT ✓

REMOVING SIGNS
AS SHOWN - 11

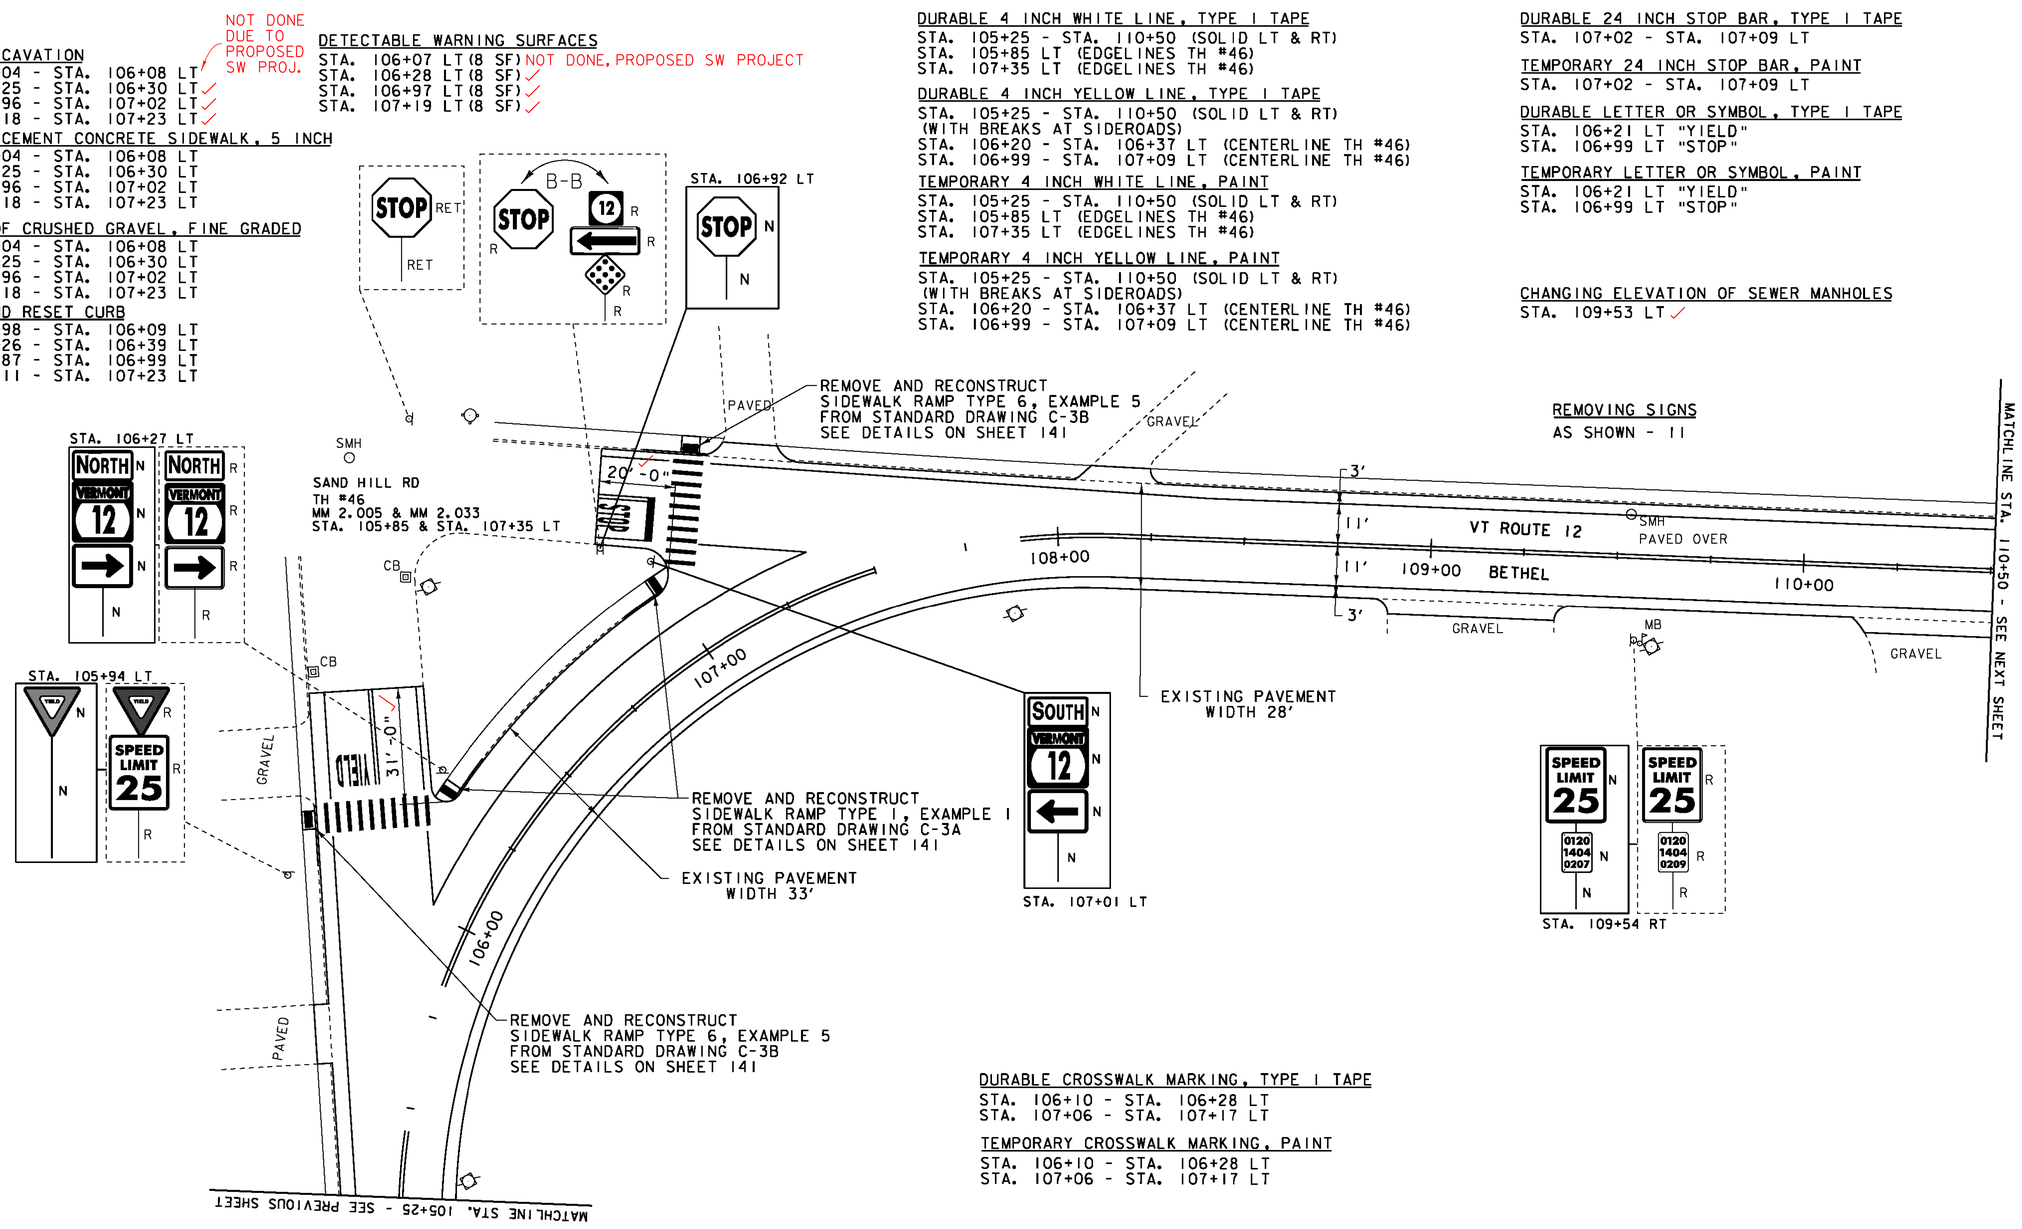

DURABLE CROSSWALK MARKING, TYPE I TAPE
STA. 106+10 - STA. 106+28 LT
STA. 107+06 - STA. 107+17 LT

TEMPORARY CROSSWALK MARKING, PAINT
STA. 106+10 - STA. 106+28 LT
STA. 107+06 - STA. 107+17 LT

LEGEND
- SIGN
- HYDRANT
- MANHOLE
- VALVE
- GAS PIPELINE MARKER
- CATCH BASIN / DROP INLET
- CURB INLET
- TRAFFIC CONTROL BOX
- PARKING METER
- UTILITY POLE
- DETECTABLE WARNINGS
- LIGHT POLE
- EX. DETECTABLE WARNINGS
- JUNCTION BOX
- PED BUTTON
- ELECTRICAL BOX
- SIGNAL
- PEDESTAL POST
- STRAIN POLE
- CAMERA
- VDZ VIDEO DETECTION ZONE

SIGN LEGEND
R = REMOVE
R&S = REMOVE AND SALVAGE
RET = RETAIN
S = SALVAGE
N = NEW
B-B = BACK TO BACK

NOT TO SCALE

PROJECT LAYOUT SHEET 6

PROJECT NAME: BETHEL-NORTHFIELD
PROJECT NUMBER: STP 2922(I)

FILE NAME: p10C246.dgn
PROJECT LEADER: CDL
DESIGNED BY: SJL
PLOT FILE: p10C246_25.1
PLOT DATE: 1/3/13
DRAWN BY: JBG
CHECKED BY: CDL
SHEET 25 OF 149