TEMPORARY 4 INCH WHITE LINE, PAINT
DURABLE 4 INCH WHITE LINE (OPTION ITEM)
92+50 TO 98+50 SOLID LT & RT
92+50 TO 98+50 SOLID LT (DIAGONALS)

TEMPORARY 4 INCH YELLOW LINE, PAINT
DURABLE 4 INCH YELLOW LINE (OPTION ITEM)
92+50 TO 98+50 SOLID LT & RT
92+50 TO 98+50 SOLID LT (SHOULDER)

TEMPORARY 8 INCH WHITE LINE, PAINT
DURABLE 8 INCH WHITE LINE (OPTION ITEM)
92+50 TO 98+50 SOLID LT (SHOULDER)

REHAB. DROP INLETS, CATCH BASINS,
OR MANHOLES, CLASS I, CLASS II
93+85 LT
97+98 RT

REMOVING SIGNS
AS SHOWN - 1

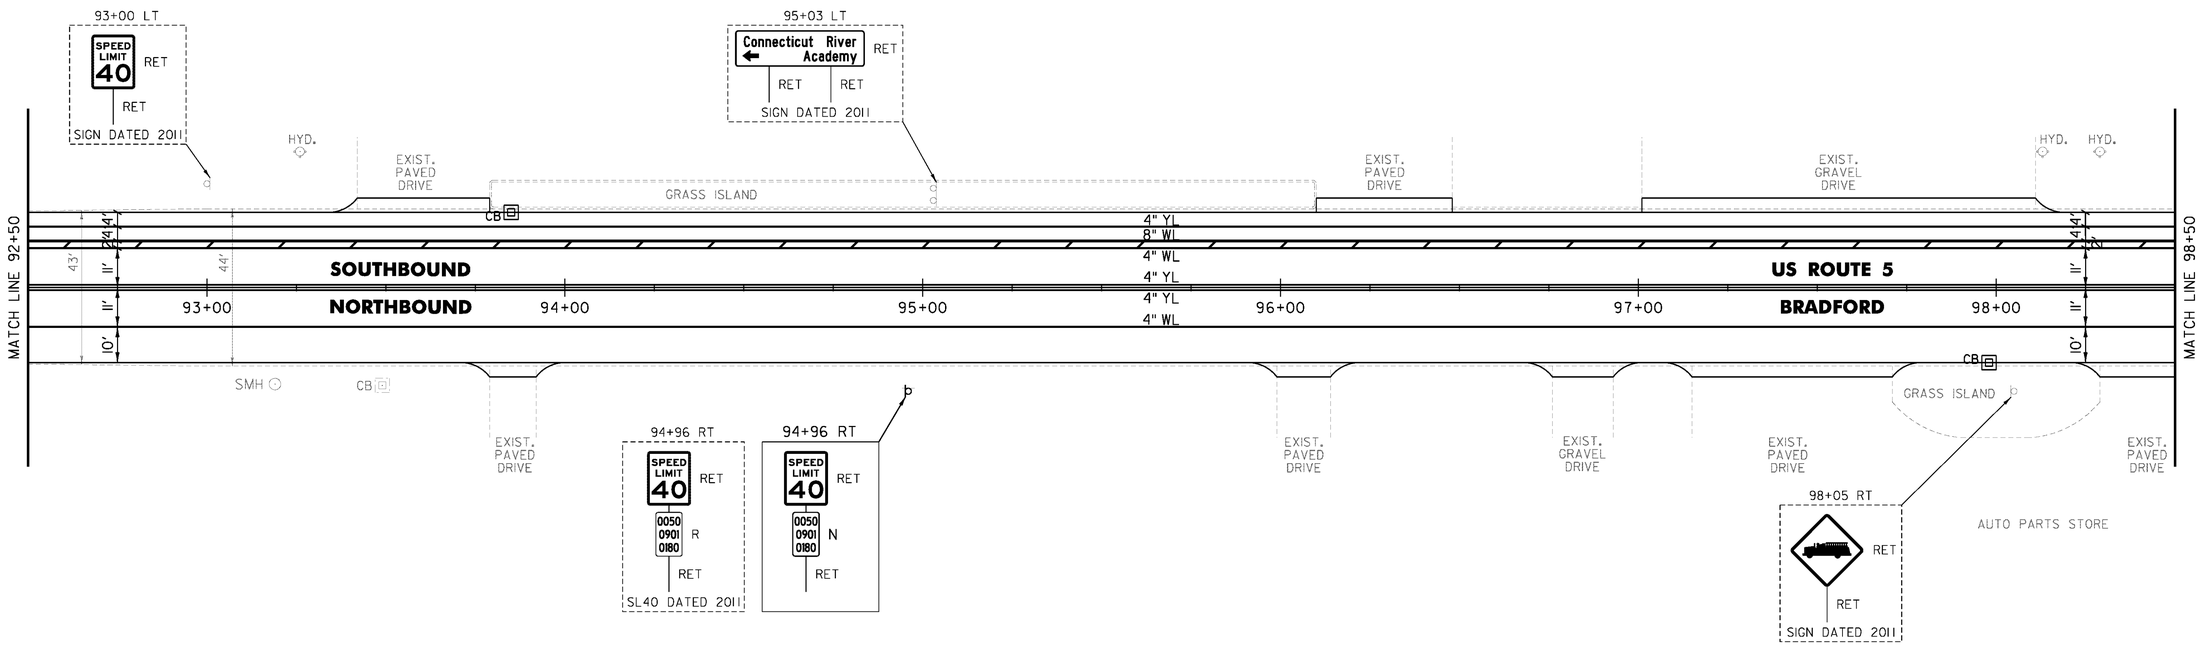

NOT TO SCALE

PROJECT NAME:	BRADFORD-RYEGATE
PROJECT NUMBER:	STP 2929(I)
FILE NAME: z10c264bdr.dgn	PLOT DATE: 2/4/2016
PROJECT LEADER: P. SHEDD	DRAWN BY: W. GORDON
DESIGNED BY: N. LEMAY	CHECKED BY: P. SHEDD
US 5 PLAN SHEET 3	SHEET 61 OF 239

CLD 14-0278