

DURABLE 4 INCH WHITE LINE (SEE OPTION ITEMS)

STA. 89+50 - STA. 95+50 (SOLID LT & RT)
 (WITH EDGE LINE BREAKS AT TH#59, TH#26)
 STA. 91+50 - STA. 93+25 (DOTTED RT)
 STA. 93+25 - STA. 94+00 (SOLID RT)
 STA. 94+24 RT (EDGE LINES AT TH#59)
 STA. 94+87 LT (EDGE LINES AT TH#26)
 STA. 95+25 - STA. 95+50 (SOLID LT)

DURABLE 4 INCH YELLOW LINE, POLYUREA

STA. 89+50 - STA. 93+25 (CENTERLINE LT & RT)
 STA. 93+25 - STA. 94+00 (CENTERLINE LT)
 STA. 94+24 RT (CENTERLINE AT TH#59)
 STA. 94+87 LT (CENTERLINE AT TH#26)
 STA. 95+25 - STA. 95+50 (CENTERLINE RT)

DURABLE 8 INCH YELLOW LINE (SEE OPTION ITEMS)

STA. 89+50 - STA. 92+84 (HATCHED LT & RT)

TEMPORARY 4 INCH WHITE LINE, PAINT

STA. 89+50 - STA. 95+50 (SOLID LT & RT)
 (WITH EDGE LINE BREAKS AT TH#59, TH#26)
 STA. 91+50 - STA. 93+25 (DOTTED RT)
 STA. 93+25 - STA. 94+00 (SOLID RT)
 STA. 94+24 RT (EDGE LINES AT TH#59)
 STA. 94+87 LT (EDGE LINES AT TH#26)
 STA. 95+25 - STA. 95+50 (SOLID LT)

TEMPORARY 4 INCH YELLOW LINE, PAINT

STA. 89+50 - STA. 93+25 (CENTERLINE LT & RT)
 STA. 93+25 - STA. 94+00 (CENTERLINE LT)
 STA. 94+24 RT (CENTERLINE AT TH#59)
 STA. 94+87 LT (CENTERLINE AT TH#26)
 STA. 95+25 - STA. 95+50 (CENTERLINE RT)

TEMPORARY 8 INCH YELLOW LINE, PAINT

STA. 89+50 - STA. 92+84 (HATCHED LT & RT)

DURABLE 24 INCH STOP BAR (SEE OPTIONS ITEMS)

STA. 94+24 - STA. 94+49 RT
 STA. 94+45 - STA. 94+85 LT

DURABLE LETTER OR SYMBOL (SEE OPTIONS ITEMS)

STA. 93+29 CTR ARROW
 STA. 93+62 CTR "ONLY"
 STA. 93+96 CTR ARROW
 STA. 94+30 RT "STOP"
 STA. 94+72 LT "STOP"
 STA. 95+29 CTR ARROW


TEMPORARY 24 INCH STOP BAR, PAINT

STA. 94+24 - STA. 94+49 RT
 STA. 94+45 - STA. 94+85 LT

TEMPORARY LETTER OR SYMBOL, PAINT

STA. 93+29 CTR ARROW
 STA. 93+62 CTR "ONLY"
 STA. 93+96 CTR ARROW
 STA. 94+30 RT "STOP"
 STA. 94+72 LT "STOP"
 STA. 95+29 CTR ARROW

CURVE #8
 DELTA = 0° 11' 36"
 D = 0° 34' 23"
 R = 10000.00'
 T = 16.88'
 L = 33.77'
 E = 0.01'
 BANKING NORMAL CROWN
 DESIGN SPEED 50 MPH

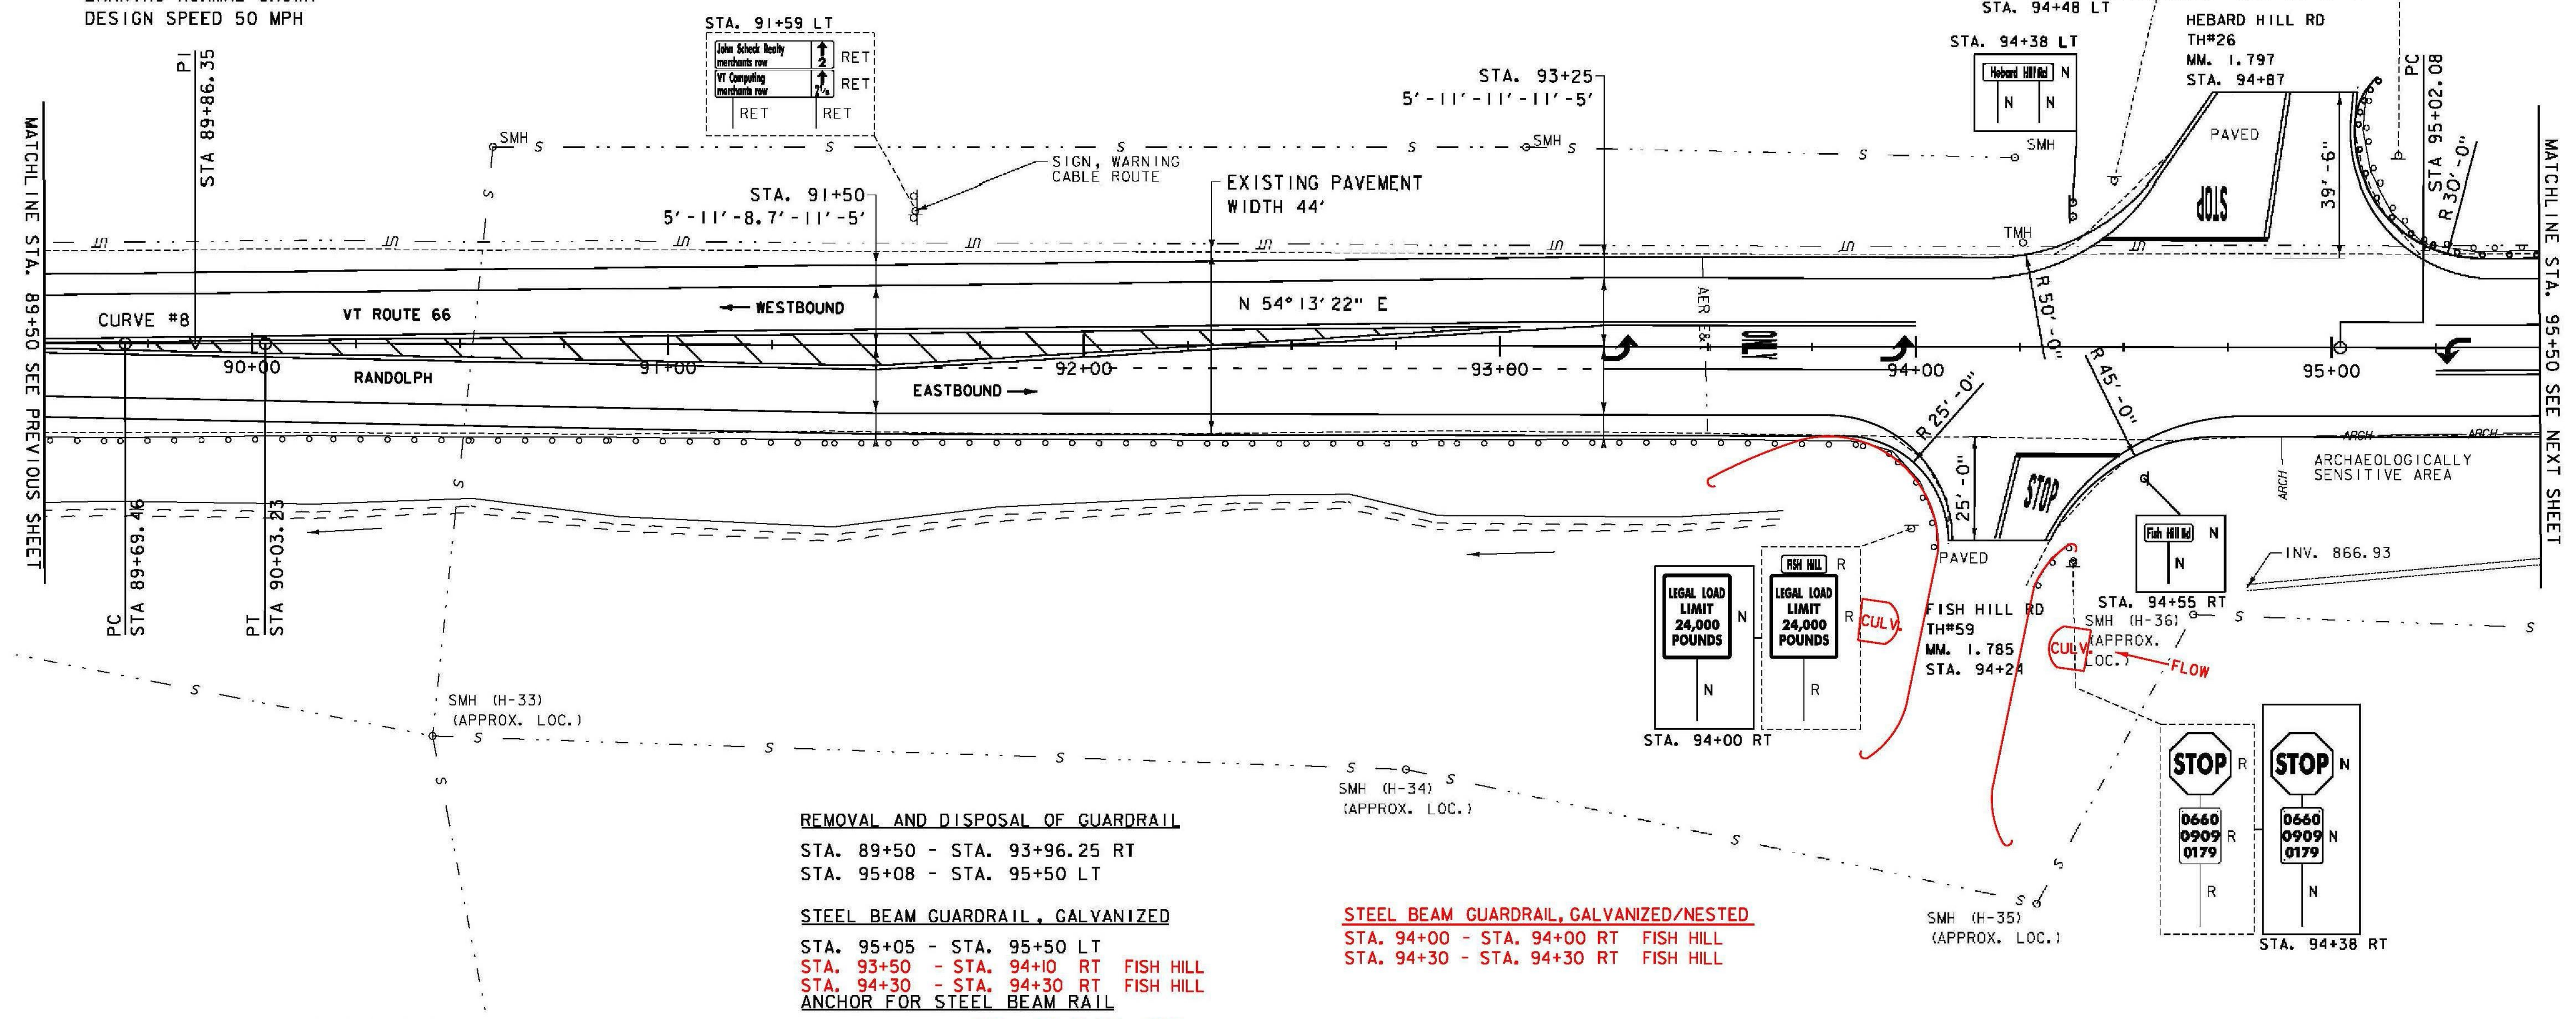

REMOVAL AND DISPOSAL OF GUARDRAIL

STA. 89+50 - STA. 93+96.25 RT
 STA. 95+08 - STA. 95+50 LT

STEEL BEAM GUARDRAIL, GALVANIZED

STA. 95+05 - STA. 95+50 LT
 STA. 93+50 - STA. 94+10 RT FISH HILL
 STA. 94+30 - STA. 94+30 RT FISH HILL
 ANCHOR FOR STEEL BEAM RAIL

STEEL BEAM GUARDRAIL, GALVANIZED/NESTED

STA. 94+00 - STA. 94+00 RT FISH HILL
 STA. 94+30 - STA. 94+30 RT FISH HILL

SIGN LEGEND

R = REMOVE
 R&S = REMOVE AND SALVAGE
 RET = RETAIN
 S = SALVAGE
 N = NEW
 B-B = BACK TO BACK
 --- = EXISTING
 — = NEW

STA. 95+08 LT STA. 94+30 RT (55')
 STA. 93+55 RT STA. 94+30 RT (110')
 STA. 94+10 RT

REMOVING SIGNS

AS SHOWN - 7

PROJECT NAME: RANDOLPH
 PROJECT NUMBER: STP 2932 (1)

FILE NAME: z10c270.dgn
 PROJECT LEADER: C. LATHROP
 DESIGNED BY: B. BRESLEND
 PROJECT LAYOUT SHEET 13

PLOT DATE: 6/5/2014
 DRAWN BY: B. BRESLEND
 CHECKED BY: C. LATHROP
 SHEET 42 OF 276

