DURABLE 4 INCH WHITE LINE (SEE OPTION ITEMS)
STA. 95+50 - STA. 101+50 (SOLID LT & RT)
STA. 95+50 - STA. 96+00 (SOLID LT)
STA. 96+00 - STA. 97+75 (DOTTED LT)

DURABLE 4 INCH YELLOW LINE, POLYUREA
STA. 95+50 - STA. 96+00 (CENTERLINE RT)
STA. 96+00 - STA. 100+50 (CENTERLINE LT & RT)
STA. 100+50 - STA. 101+50 (SOLID LT & RT)

DURABLE 8 INCH YELLOW LINE (SEE OPTION ITEMS)
STA. 96+32 - STA. 100+07 (HATCHED LT & RT)

DURABLE LETTER OR SYMBOL (SEE OPTIONS ITEMS)
STA. 95+61 CTR "ONLY"
STA. 95+96 CTR ARROW

TEMPORARY 4 INCH WHITE LINE, PAINT
STA. 95+50 - STA. 101+50 (SOLID LT & RT)
STA. 95+50 - STA. 96+00 (SOLID LT)
STA. 96+00 - STA. 97+75 (DOTTED LT)

TEMPORARY 4 INCH YELLOW LINE, PAINT
STA. 95+50 - STA. 96+00 (CENTERLINE RT)
STA. 96+00 - STA. 100+50 (CENTERLINE LT & RT)
STA. 100+50 - STA. 101+50 (SOLID LT & RT)

TEMPORARY 8 INCH YELLOW LINE, PAINT
STA. 96+32 - STA. 100+07 (HATCHED LT & RT)

TEMPORARY LETTER OR SYMBOL, PAINT
STA. 95+61 CTR "ONLY"
STA. 95+96 CTR ARROW

REHAB, DROP INLET, CATCH BASINS, OR MANHOLES, CLASS I, CLASS II, OR CLASS III
STA. 97+99 RT
STA. 99+63 RT
STA. 100+95 RT

MILLED RUMBLE STRIPS
STA. 100+50 - STA. 101+50 CTR

SPECIAL PROVISION (CORING CONCRETE)
STA. 99+63 RT

6 INCH UNDERDRAIN PIPE
STA. 99+63 - STA. 100+75 RT

RELOCATE MAILBOX, SINGLE SUPPORT
STA. 99+04 RT

COMMON EXCAVATION
STA. 97+93 - STA. 99+21 RT (BITUMINOUS GUTTER)
STA. 99+48 - STA. 101+50 RT (BITUMINOUS GUTTER)

REMOVAL AND DISPOSAL OF GUARDRAIL
STA. 95+50 - STA. 98+80 LT

STEEL BEAM GUARDRAIL, GALVANIZED
STA. 95+50 - STA. 98+80 LT

ANCHOR FOR STEEL BEAM RAIL
STA. ~~98+80~~ 98+75 LT

REMOVING SIGNS
AS SHOWN - 2

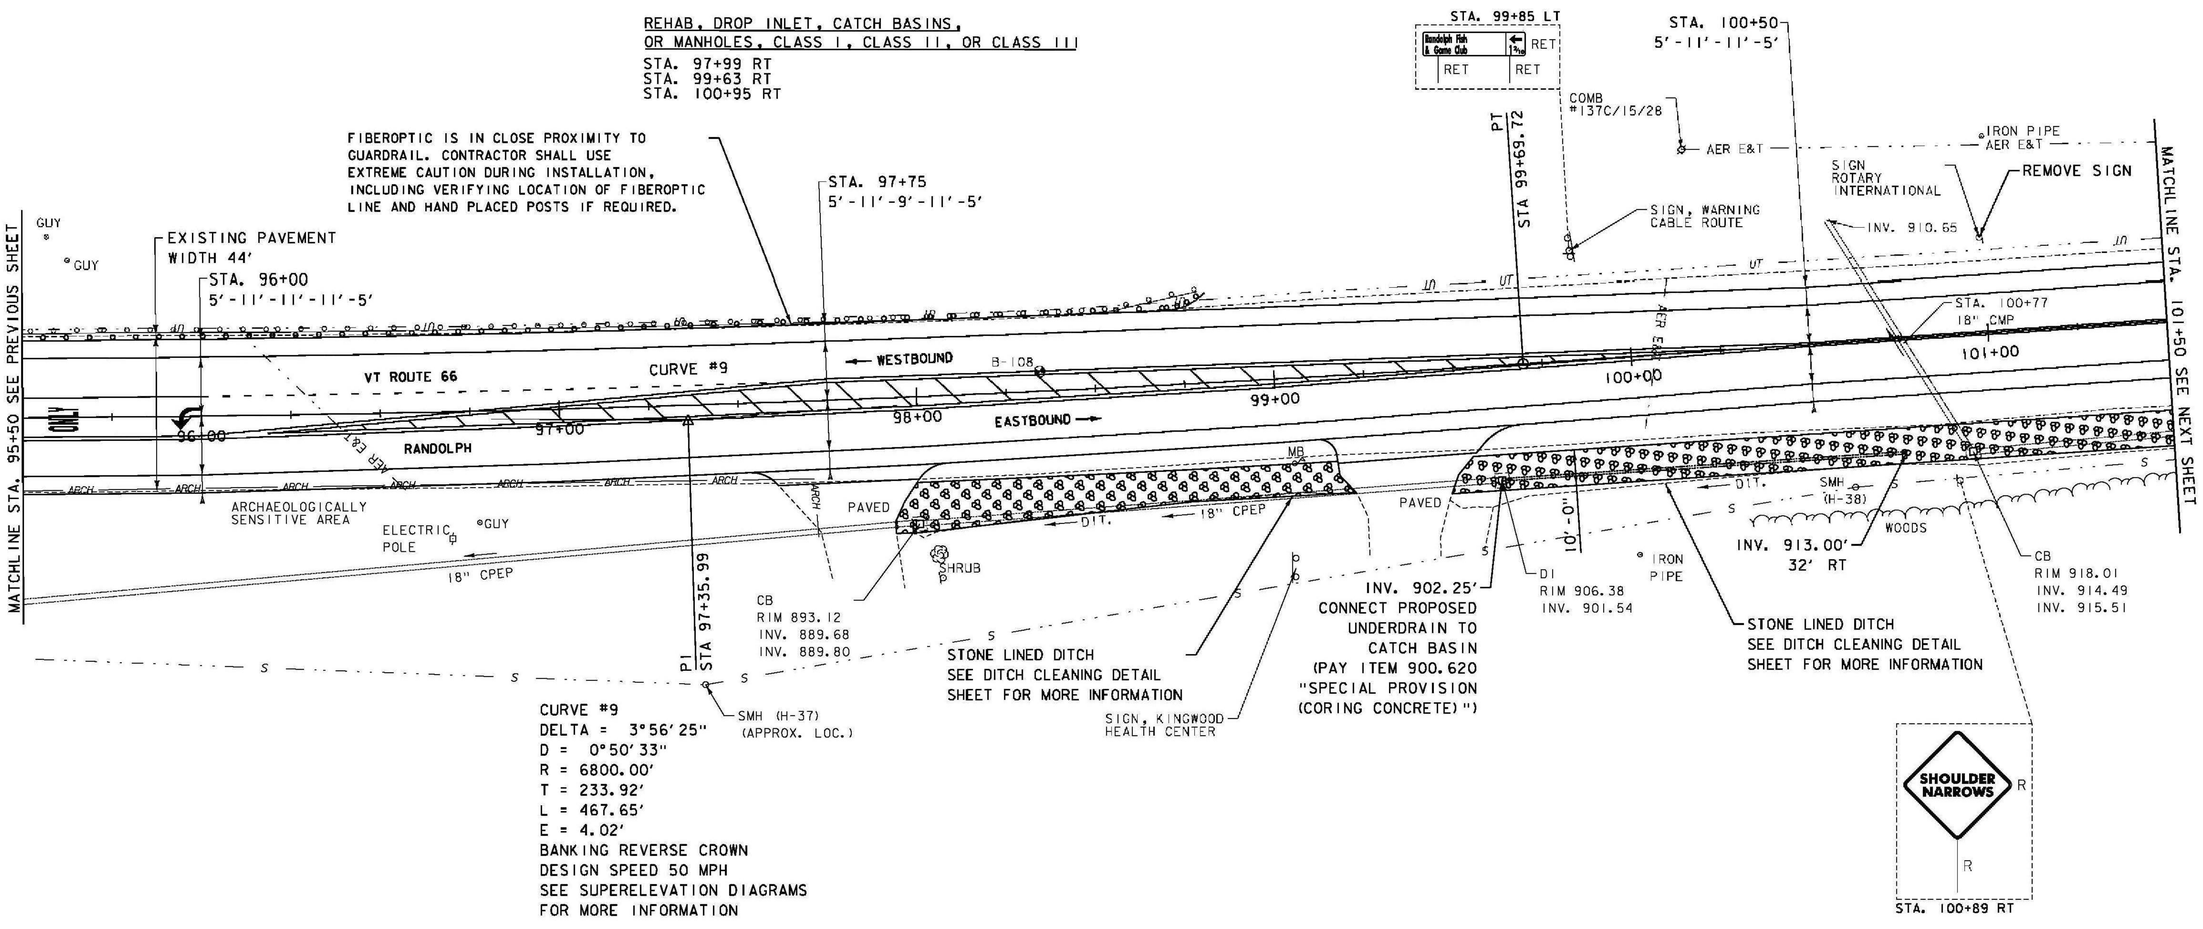

SIGN LEGEND

R = REMOVE
R&S = REMOVE AND SALVAGE
RET = RETAIN
S = SALVAGE
N = NEW
B-B = BACK TO BACK
—— = EXISTING
—— = NEW

0 20 40
SCALE IN FEET

PROJECT NAME: RANDOLPH	
PROJECT NUMBER: STP 2932 (1)	
FILE NAME: z10c270.dgn	PLOT DATE: 6/5/2014
PROJECT LEADER: C. LATHROP	DRAWN BY: B. BRESLEND
DESIGNED BY: B. BRESLEND	CHECKED BY: C. LATHROP
PROJECT LAYOUT SHEET 14	SHEET 43 OF 276