DURABLE 4 INCH WHITE LINE (SEE OPTION ITEMS)
STA. 325+50 - STA. 331+25 (SOLID LT & RT)

DURABLE 4 INCH YELLOW LINE, POLYUREA
STA. 325+50 - STA. 331+25 (SOLID LT & RT)

6 INCH UNDERDRAIN PIPE
STA. 325+50 - STA. ~~327+45~~ RT 327+49
STA. ~~328+00~~ - STA. 331+25 RT
327+90

MILLED RUMBLE STRIPS
STA. 325+50 - STA. 331+25 CTR

TEMPORARY 4 INCH WHITE LINE, PAINT
STA. 325+50 - STA. 331+25 (SOLID LT & RT)

TEMPORARY 4 INCH YELLOW LINE, PAINT
STA. 325+50 - STA. 331+25 (SOLID LT & RT)

REMOVING SIGNS
AS SHOWN - 3

STONE FILL, TYPE I
STA. 325+50 - STA. 327+60 LT
STA. 327+90 - STA. 328+00 LT
STA. 329+25 - STA. 331+25 LT

GEOTEXTILE FOR SILT FENCE
STA. 325+50 - STA. 327+60 LT
STA. 327+90 - STA. 328+00 LT
STA. 329+25 - STA. 331+25 LT

GRUBBING MATERIAL (6")
STA. 325+50 - STA. 327+60 LT
STA. 327+90 - STA. 328+00 LT
STA. 329+25 - STA. 331+25 LT

(37) STA. 327+49.49 RT 21.78' TO
STA. 327+66.19 LT 27.47'
REMOVE HEADWALL AND PIPE
INSTALL NEW 18" CPEP (52'-0")
INV. IN = 967.80'
INV. OUT = 963.20'

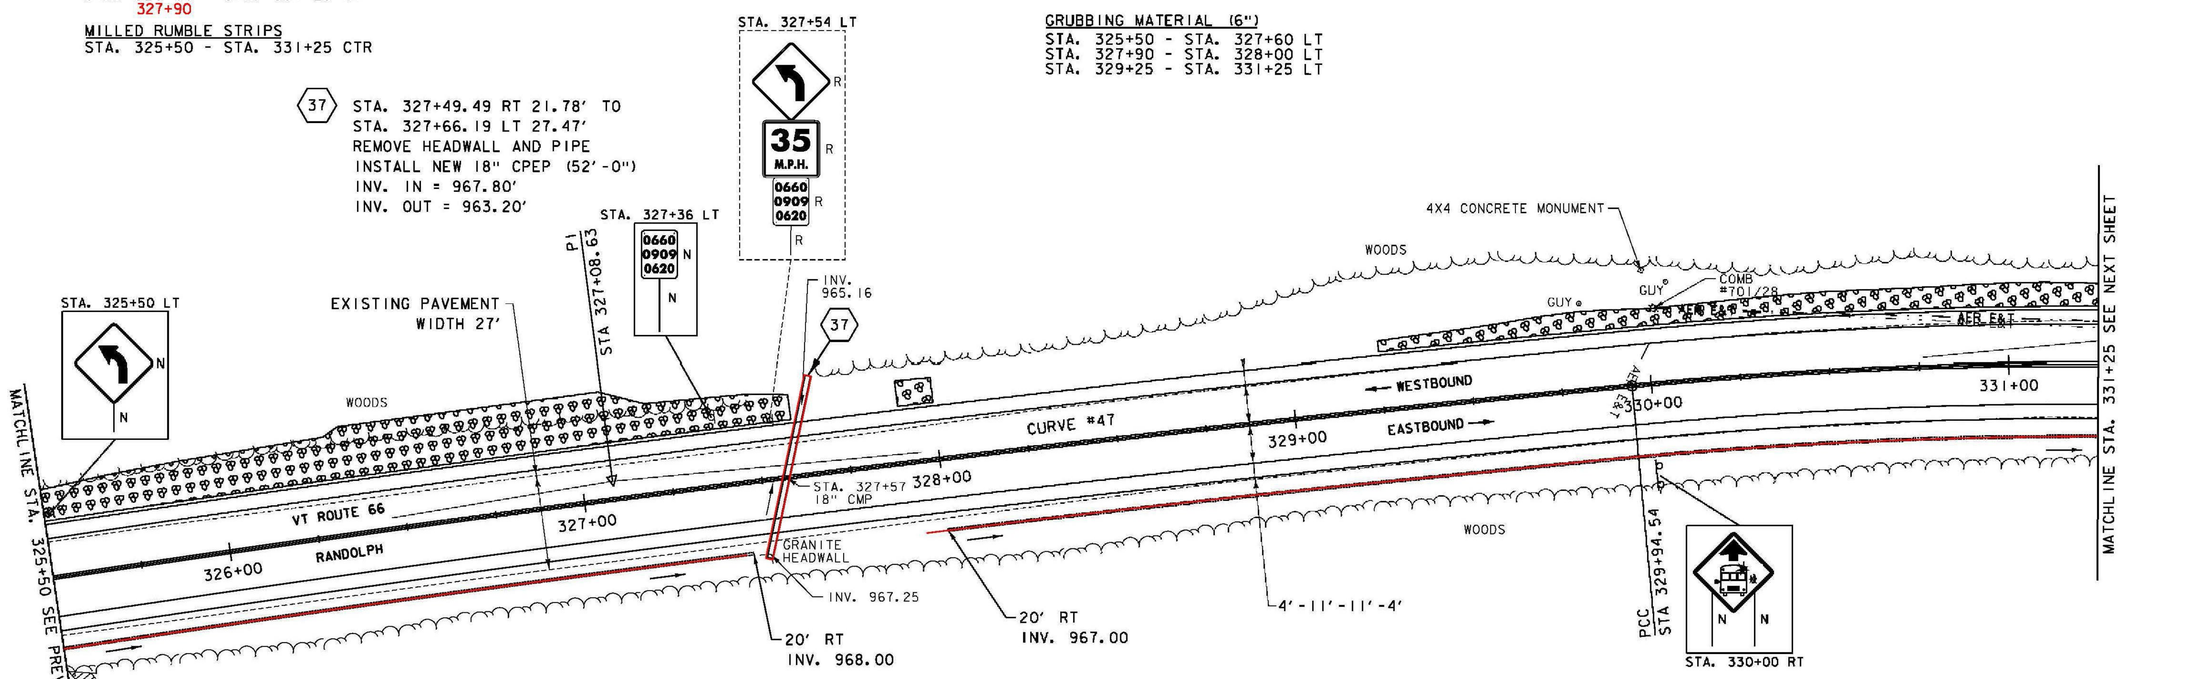

CURVE #47
DELTA = 39°38'58"
D = 9°10'02" (1) D = 0°42'58" (2) D = 4°14'39" (3)
R = 625.00' (1) R = 8000.00' (2) R = 1350.00' (3)
T = 459.09' (1) T = 712.19' (2)
L = 251.90' (1) L = 572.06' (2) L = 293.58' (3)
E = 150.49'
BANKING 0.080 FT/FT, NORMAL CROWN, 0.058 FT/FT
DESIGN SPEED 45/50/50 MPH
SEE SUPERELEVATION DIAGRAMS
FOR MORE INFORMATION

SIGN LEGEND

R = REMOVE
R&S = REMOVE AND SALVAGE
RET = RETAIN
S = SALVAGE
N = NEW
B-B = BACK TO BACK
—— = EXISTING
—— = NEW

0 20 40
SCALE IN FEET

PROJECT NAME: RANDOLPH
PROJECT NUMBER: STP 2932 (1)

FILE NAME: z10c270.dgn
PROJECT LEADER: C. LATHROP
DESIGNED BY: B. BRESLEND
PROJECT LAYOUT SHEET 55

PLOT DATE: 6/5/2014
DRAWN BY: B. BRESLEND
CHECKED BY: C. LATHROP
SHEET 86 OF 276