DURABLE 4 INCH WHITE LINE (SEE OPTION ITEMS)
STA. 358+50 - STA. 364+25 (SOLID LT & RT)

DURABLE 4 INCH YELLOW LINE, POLYUREA
STA. 358+50 - STA. 364+25 (SOLID LT & RT)

6 INCH UNDERDRAIN PIPE
~~STA. 358+75 - STA. 362+95 LT~~
STA. 360+48 - STA. 363+90 LT
STA. 361+33 - STA. 364+25 RT

MILLED RUMBLE STRIPS
STA. 358+50 - STA. 364+25 CTR

TEMPORARY 4 INCH WHITE LINE, PAINT
STA. 358+50 - STA. 364+25 (SOLID LT & RT)

TEMPORARY 4 INCH YELLOW LINE, PAINT
STA. 358+50 - STA. 364+25 (SOLID LT & RT)

REMOVING SIGNS
AS SHOWN - 2

REMOVING AND RESETTING FENCE
STA. 360+80 - STA. 362+60 LT
STA. 363+35 - STA. 363+70 LT

STONE FILL, TYPE I
STA. 362+60 - STA. 363+35 LT
STA. 364+05 - STA. 364+25 LT

GEOTEXTILE FOR SILT FENCE
STA. 362+60 - STA. 363+35 LT
STA. 364+05 - STA. 364+25 LT

GRUBBING MATERIAL (6")
STA. 362+60 - STA. 363+35 LT
STA. 364+05 - STA. 364+25 LT

CURVE #53
DELTA = 25° 14' 30"
D = 8° 29' 18"
R = 675.00'
T = 151.14'
L = 297.37'
E = 16.71'
BANKING 0.080 FT/FT
DESIGN SPEED 45 MPH
SEE SUPERELEVATION DIAGRAMS
FOR MORE INFORMATION

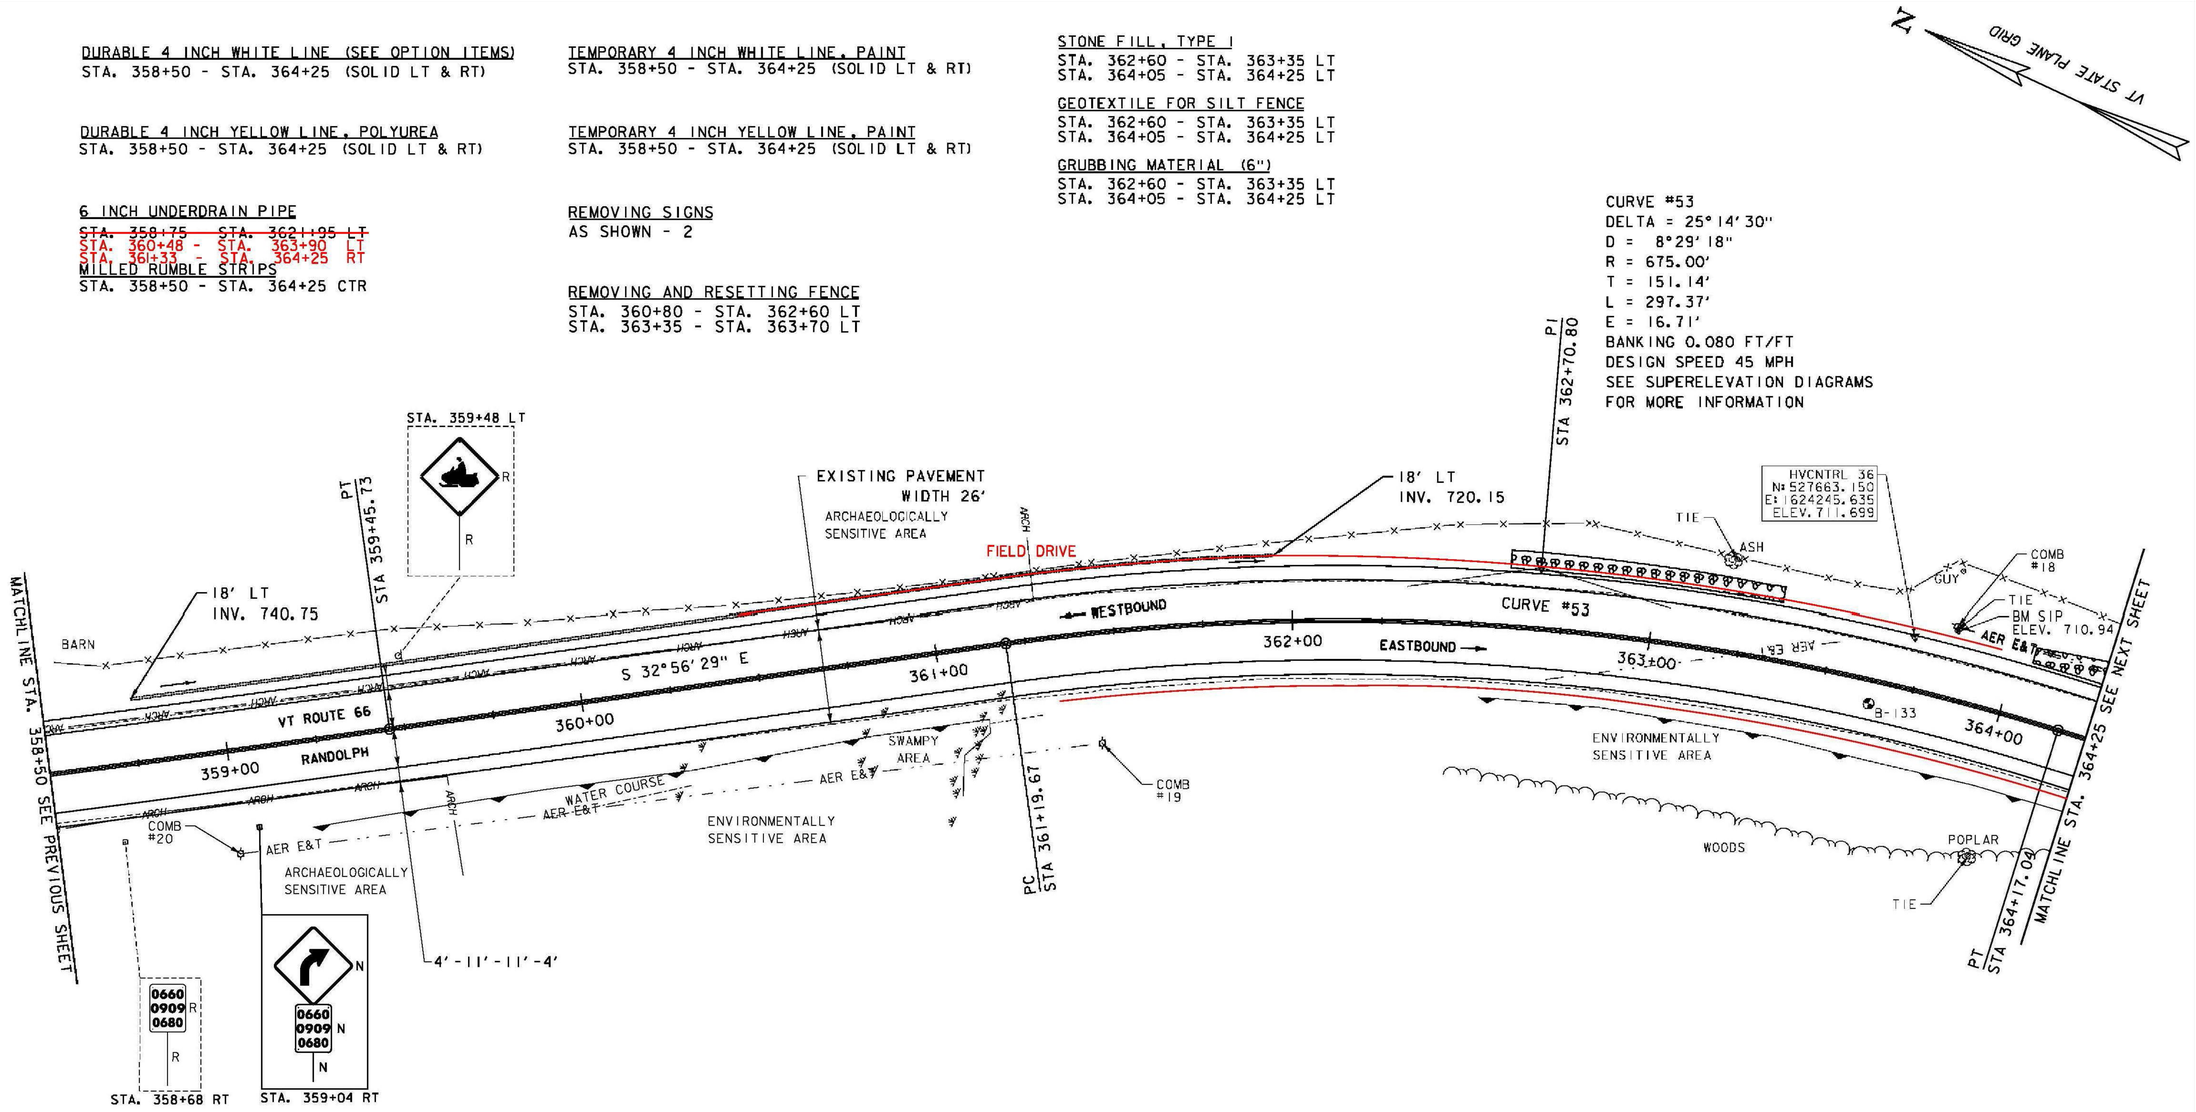

ENVIRONMENTALLY SENSITIVE LOCATIONS:

NO.	LIMITS	POS.	TYPE
12.	STA. 359+19 - STA. 361+04	RT	-
13.	STA. 362+51 - STA. 364+25	RT	-

SIGN LEGEND

R = REMOVE
R&S = REMOVE AND SALVAGE
RET = RETAIN
S = SALVAGE
N = NEW
B-B = BACK TO BACK
—— = EXISTING
—— = NEW

0 20 40
SCALE IN FEET

PROJECT NAME: RANDOLPH
PROJECT NUMBER: STP 2932 (1)

FILE NAME: z10c270.dgn
PROJECT LEADER: C. LATHROP
DESIGNED BY: B. BRESLEND
PROJECT LAYOUT SHEET 61

PLOT DATE: 6/5/2014
DRAWN BY: B. BRESLEND
CHECKED BY: C. LATHROP
SHEET 92 OF 276