STATE OF VERMONT
AGENCY OF TRANSPORTATION

TRAFFIC SIGN SUMMARY SHEET 25

MILEMARKER, STATION, OR SIGN NUMBER	SIGN LEGEND	SIGN DIMENSIONS EA	WIDTH (in)	HEIGHT (in)	NEW & SALVAGED SIGNS "A"	"B"	SALV SIGN	SALV TIS	EXIST POST RETAIN	SALVAGE	NEW SIGN POSTS NO. OF POSTS	FLANGED CHANNEL lb/ft 1.12	2.0	3.0	SQUARE STEEL (in) lb/ft 1.75	2.0	2.5	ANCHOR	SLEEVE	TUBULAR ALUMINUM Ø (in) lb/ft 3.0	4.0	4.0 MOD	TUBULAR STEEL Ø (in) FOUND-ATION	lb/ft 3.0	3.5	4.0	5.0	W-SHAPE STEEL FTG. SIZE 24"	30"	WEIGHT	POST SIZE	SIGNS REQUIRED FRAMED	REMARKS SHSM = FHWA STANDARD HIGHWAY SIGNS AND MARKINGS BOOK	SIGN DETAIL DETAIL IN SHSM	DETAIL ON DWG. NUMBER	STD. SHEET NUMBER
STA. 255+75 LT RANDOLPH		1	30	30	6.25						1					12' 6" X		X														WI-2L	SHSM		
STA. 260+83 LT RANDOLPH		1	42	12	3.50						1					10' 4" X		X														D3-1		137	
STA. 264+00 LT RANDOLPH		1	6	10	0.42						1				5' 10" X			2.5' X														VD-700			T-44
STA. 269+50 RT RANDOLPH		1	30	30	6.25						1					13' 3" X		X														WI-2L	SHSM		
STA. 274+34 LT RANDOLPH		1	66	12	5.50						2					16' 6" X		8' X														D3-1		137	
STA. 274+56 RT RANDOLPH		1	6	10	0.42						1				6' 0" X			2.5' X														VD-700			T-44
STA. 276+23 LT RANDOLPH		1	30	30	6.25						1					10' 6" X		X														WI-2R	SHSM		
STA. 277+13 LT RANDOLPH	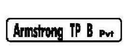	1	66	12	5.50						2					18' 6" X		8' X														D3-1		137	
												LF	LF	LF	LF ~~16~~ 11'-10"	LF ~~120~~ 81'-7"	LF -	37'-0"	EA.	LB	LB	LB		LB	LB	LB	LB								
																	130'-5"																			