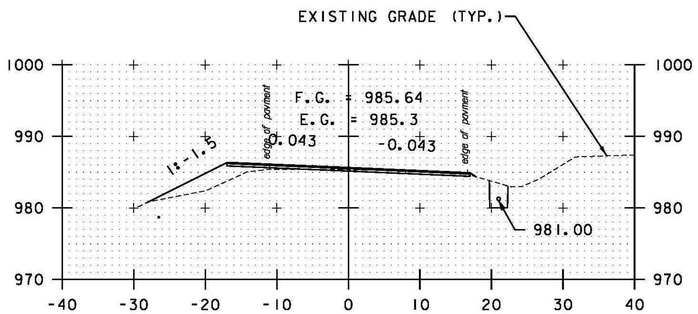

108+50

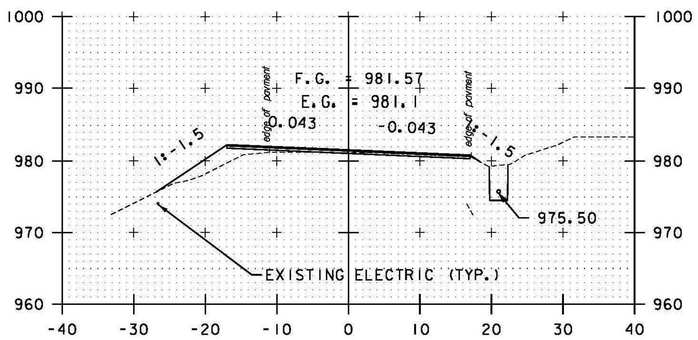

108+00

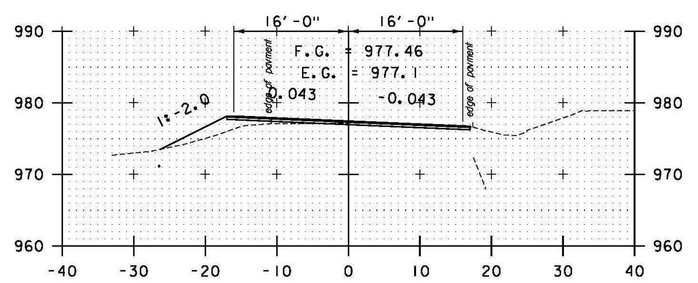

107+50

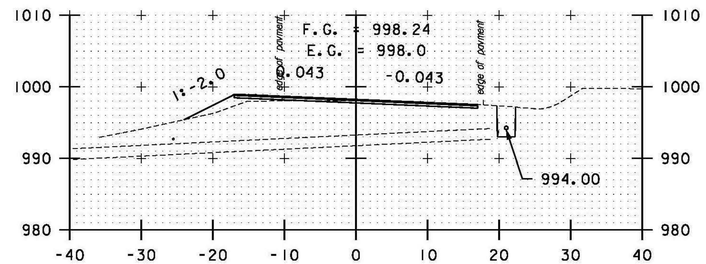

110+00

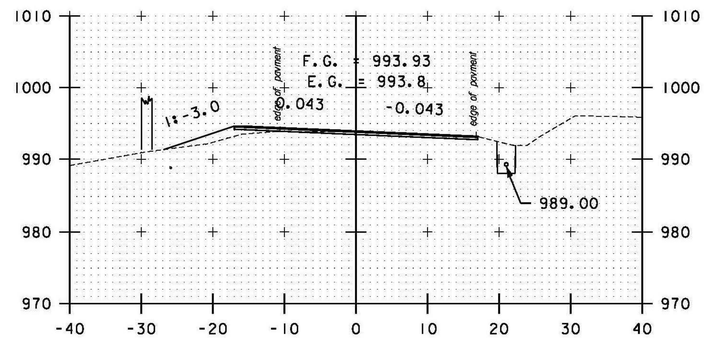

109+50

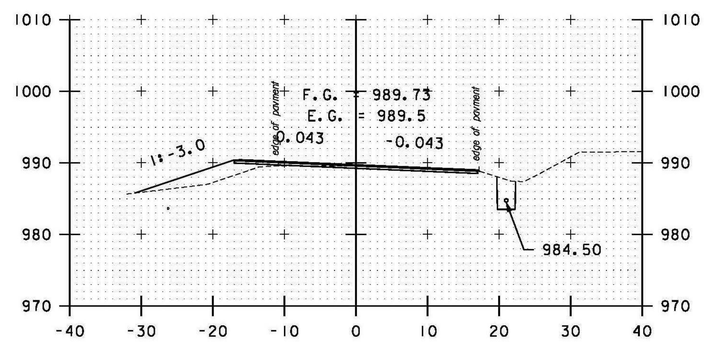

109+00

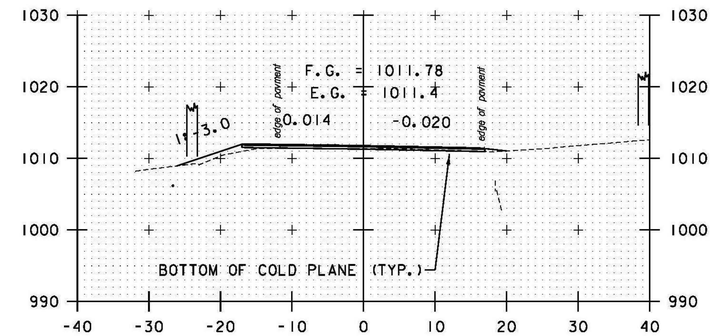

DRIVE RT
111+50

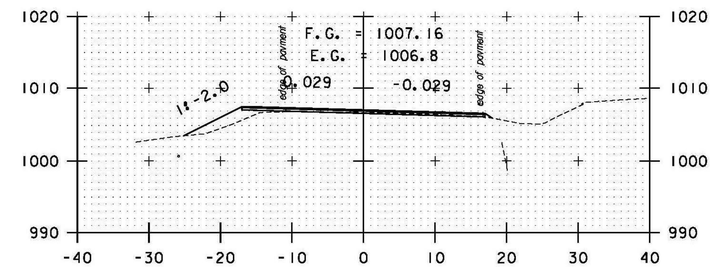

111+00

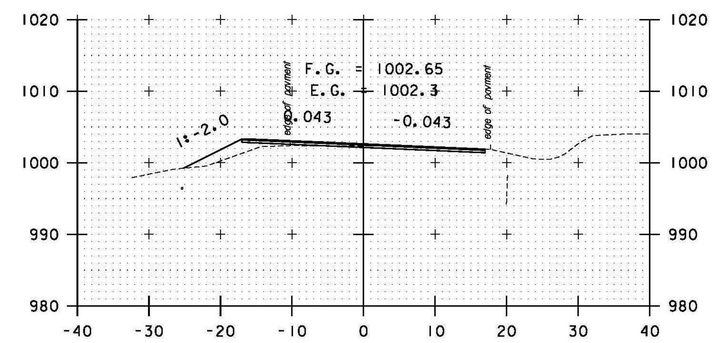

110+50

STA. 107+50 TO STA. 111+50

DATUM
VERTICAL NAVD 88
HORIZONTAL NAD 83 (07)

0 10 20
SCALE IN FEET

PROJECT NAME: RANDOLPH
PROJECT NUMBER: STP 2932 (1)

FILE NAME: z10c270.dgn
PROJECT LEADER: C. LATHROP
DESIGNED BY: B. BRESLEND
VT 66 CROSS SECTION SHEET 21

PLOT DATE: 6/5/2014
DRAWN BY: B. BRESLEND
CHECKED BY: C. LATHROP
SHEET 177 OF 276