DIRECTION	MILEPOINT	LOCATION CODE (SHEET 2)	SIGN CODE	WIDTH (IN)	HEIGHT (IN)	SHEETING REMARKS	SIGN LEGEND	NEW SIGNS "A"	NEW SIGNS "B"	EXISTING SIGNS RETAIN	EXISTING SIGNS SALVAGE FROM	EXISTING SIGNS SALVAGE TO	EXISTING SIGNS REMOVE	EXIST POST RETAIN	EXIST POST REMOVE	NUMBER OF NEW POSTS	SQUARE STEEL (IN) 1.75 (LB / FT) 1.88	SQUARE STEEL (IN) 2.00 (LB / FT) 2.42	SQUARE STEEL (IN) 2.50 (LB / FT) 3.35	TUBULAR STEEL Ø (IN) FOUNDATION	TUBULAR STEEL Ø (IN) 3.00 (LB / FT) 7.60	TUBULAR STEEL Ø (IN) 3.50 (LB / FT) 9.00	TUBULAR STEEL Ø (IN) 4.00 (LB / FT) 10.80	TUBULAR STEEL Ø (IN) 5.00 (LB / FT) 14.60	SIGN FRAME REQUIRED	REMARKS	SIGN DETAIL LOCATION SHSM	SIGN DETAIL LOCATION PROJECT SHEET #	SIGN DETAIL LOCATION STANDARD SHEET #
SPRINGFIELD NB							FY-FLUORESCENT YELLOW FYG-FLUORESCENT YELLOW GREEN																				"SHMS"-STANDARD HIGHWAY SIGNS AND MARKINGS			
NB	2.011	A	VD-062C	74.75	16		TRAVEL INFORMATION SIGN			1																			
		A	VD-062BC	74.75	16		TRAVEL INFORMATION SIGN			1				X															
NB	2.070	A	W3-1	36	36		STOP AHEAD SYMBOL						1		X												TO BE REPLACED FURTHER NORTH AT MP 2.144			
		A	M2-1	21	15			2.19								1		X							**GREEN ON WHITE** "JCT"	X		
		A	M1-5	24	24			4.00																			VERMONT ROUTE 11			E-136B
NB	2.144	A	M2-1	21	15		JCT						1		X														
		A	M1-5	24	24		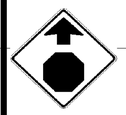 VERMONT ROUTE 11						1																
		A	W3-1	36	36			9.00								2		X									VTRANS DISTRICT 2 WILL APPLY THE ADJACENT PAVEMENT STENCIL "STOP AHEAD" AFTER THE SIGN IS INSTALLED	X		
NB	2.179	A	D1-1A	72	10		<--- SPRINGFIELD 4						1		X														
		A	D1-1A	72	10		CHARLESTOWN NH 2 --->						1																
		A	D9-2	24	24		HOSPITAL ("H")						1																
		A	M5-1L	21	15		ADVANCE LEFT ARROW						1																
		A	VD1-1A	72	12			6.00								2		X									NOTE: THE NEW DESTINATION SIGNS HAVE NEW SIGN CODES AND UPPER / LOWER CASE LETTERS (TYP)		13	
		A	VD1-1A	72	12			6.00																				15	
		A	D9-2	24	24		(CONT. ON NEXT PAGE)	4.00																			INSTALL THE HOSPITAL SIGNS ON THE LEFT SIDE POST	X		
							SHEET TOTALS	31.19	0.00	2	0	0	7	0	0	5		75									
								SF	SF	EA	EA	EA	EA	EA	EA	EA		FT									
							TOWN DIRECTIONAL TOTALS	615.4	0.0	12.0	5.0	5.0	145	0.0	0.0	82		1230.0									

SIGN SUMMARY SHEET

VERMONT AGENCY OF TRANSPORTATION

PROJECT NAME: **SPRINGFIELD-HARTFORD**
PROJECT NUMBER: **STPG SIGN(33)**

FILE NAME: **SPRINGFIELD US-5 NB**
PROJECT MANAGER: **A. GAMBLE**
DESIGNED BY: **M. MILLER**
SPRINGFIELD US-5 NORTHBOUND 2

PLOT DATE: **2/13/2012**
DRAWN BY: **M. MILLER**
CHECKED BY: **A. GAMBLE**
SHEET **18** OF **162**