DIRECTION	MILEPOINT	LOCATION CODE (SHEET 2)	SIGN CODE	WIDTH (IN)	HEIGHT (IN)	SHEETING REMARKS	SIGN LEGEND	NEW SIGNS "A"	NEW SIGNS "B"	EXISTING SIGNS RETAIN	EXISTING SIGNS SALVAGE FROM	EXISTING SIGNS SALVAGE TO	EXISTING SIGNS REMOVE	EXIST POST RETAIN	EXIST POST REMOVE	NUMBER OF NEW POSTS	SQUARE STEEL (IN) 1.75 (LB / FT) 1.88	SQUARE STEEL (IN) 2.00 (LB / FT) 2.42	SQUARE STEEL (IN) 2.50 (LB / FT) 3.35	FOUNDATION	TUBULAR STEEL Ø (IN) 3.00 (LB / FT) 7.60	TUBULAR STEEL Ø (IN) 3.50 (LB / FT) 9.00	TUBULAR STEEL Ø (IN) 4.00 (LB / FT) 10.80	TUBULAR STEEL Ø (IN) 5.00 (LB / FT) 14.60	SIGN FRAME REQUIRED	REMARKS	SIGN DETAIL LOCATION SHSM	SIGN DETAIL LOCATION PROJECT SHEET #	SIGN DETAIL LOCATION STANDARD SHEET #
WEATHERSFIELD NB							FY-FLUORESCENT YELLOW FYG-FLUORESCENT YELLOW GREEN																			"SHSM"-STANDARD HIGHWAY SIGNS AND MARKINGS			
NB	6.001	A	R2-1	24	30		SPEED LIMIT 40			1				X														
NB	6.126	A	VD-062BRN	72	16		BUSINESS DIRECTIONAL SIGN			1				X												ASCUTNEY STATE PARK			
		A	~~VD-062AS~~	~~72~~	~~16~~		~~BUSINESS DIRECTIONAL SIGN~~			~~1~~																RESORT IS CLOSED SIGN IS MISSING ~~ASCUTNEY MTN RESORT~~			
NB	6.168	A	M2-1	21	15		JCT						1		X														
		A	M1-5	24	24		VERMONT ROUTE 44A						1																
		A	M2-1	21	15			2.19								1		X						GREEN ON WHITE "JCT"	X		
		A	M1-5	24	24			4.00																					E-136B
NB	6.227	A	D1-1A	72	12		(UP ARROW) WINDSOR 4						1		X														
		A	D1-1A	72	12		<--- (45°) BROWNSVILLE 6						1																
		A	D1-1S	72	12		<--- (45°) MT ASCUTNEY SKI AREA 6						1														THIS SIGN WILL NOT BE REPLACED, THE RESORT IS CLOSED			
		A	VD1-1A	72	12		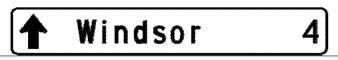	6.00								2		X								INSTALL THE ASSEMBLY AS SHOWN IN THE SIGN LEGEND		13	
		A	VD1-1A	72	12		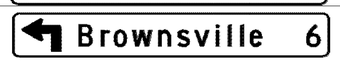	6.00																				13	
		A	D9-2	24	24		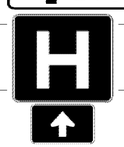	4.00																		INSTALL THE HOSPITAL SYMBOL ON THE LEFT POST	X		
		A	M6-3	21	15			2.19																		**WHITE ON BLUE**; UP ARROW	X		
NB	6.264	A	M3-1	24	12		NORTH (CONT. ON NEXT PAGE)						1		X														
SIGN SUMMARY SHEET							SHEET TOTALS	24.38	0.00	3	0	0	6	0	0	3		45.0		0	0.0	0.0	0.0	0.0				
								SF	SF	EA	EA	EA	EA	EA	EA	EA		FT		EA	LB	LB	LB	LB				
VERMONT AGENCY OF TRANSPORTATION							TOWN DIRECTIONAL TOTALS	367.0	0.0	11	4	4	89	0	0	48		720.0		0		0.0						

PROJECT NAME: **SPRINGFIELD-HARTFORD**
PROJECT NUMBER: **STPG SIGN(33)**

FILE NAME: **WEATHERSFIELD US-5 NB**
PROJECT MANAGER: **A. GAMBLE**
DESIGNED BY: **M. MILLER**
WEATHERSFIELD US-5 NB 11

PLOT DATE: **2/13/2012**
DRAWN BY: **M. MILLER**
CHECKED **A. GAMBLE**